


PROFILE FOR PROPOSAL NO. 8627. BYGN. NO. 555

SCALE: 1/8" = 1'-0"

LENGTH BETW. PP. 210'-0"
BREADTH 35'-0"
DEPTH MOULDED TO UPPER DECK 13'-9"
QUARTERDECK 17'-3"

TO BE BUILT TO CLASS: LLOYD'S 100-A-1. SINGLE DECK
WITH POOP & QUARTER DECK CONNECTED AND FORECASTLE
DOUBLE BOTTOM TO CARRY OIL FUEL & WATER BALLAST.
OIL FUEL OF A FLASHPOINT ABOVE 150° FAHR.

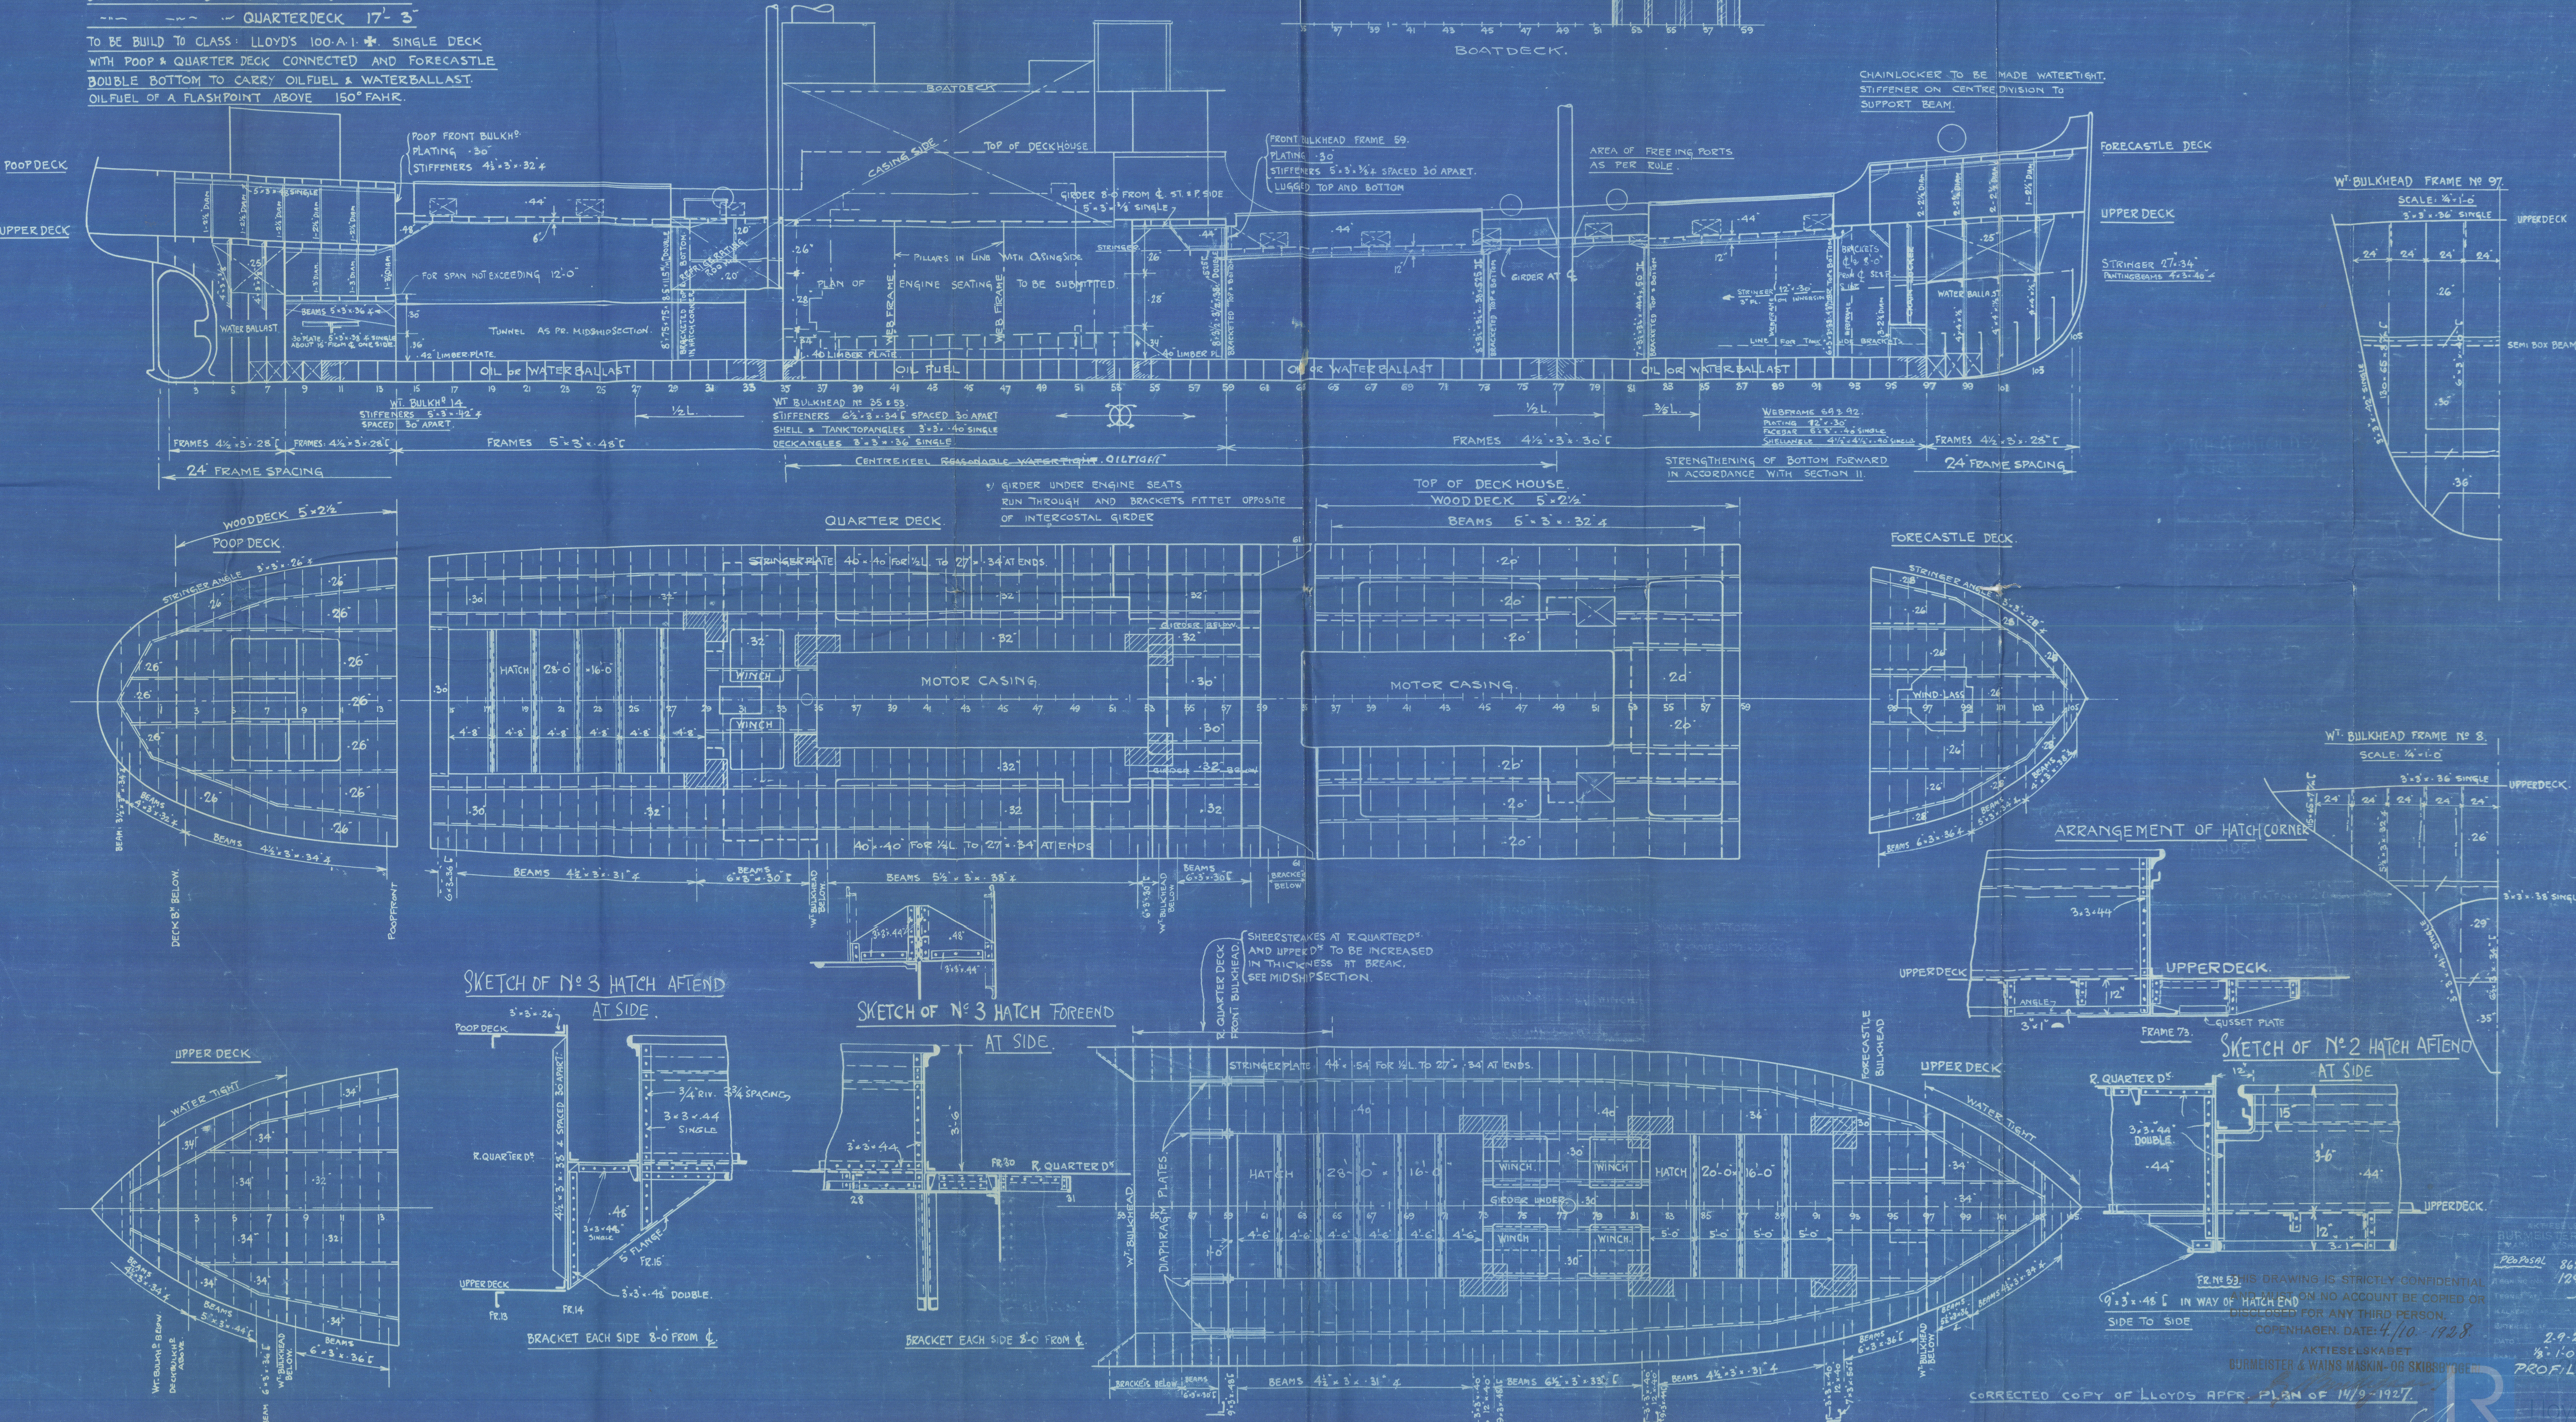

THIS DRAWING IS STRICTLY CONFIDENTIAL
IN NO WAY TO BE COPIED OR
DISCLOSED FOR ANY THIRD PERSON.
COPENHAGEN, DATE: 4/10-1928.

AKTIESELSKABET
BURMEISTER & WAINSKABET
CORRECTED COPY OF LLOYD'S APPR. PLAN OF 14/9-1927.

PROFITE 222
12031
29-27
1/8" = 1'-0" = 1/16"
PROFILE

{ BURMEISTER
&
WAIN,
COPENHAGEN.



NEWB. 555.

M/S "YANDRA"

of Port Adelaide.

LONGTUN-SECTION.

Copenhagen Report No: 7808.

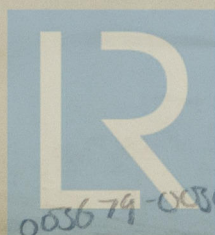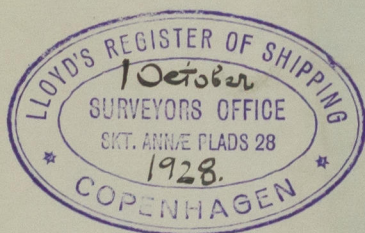

© 2020

Lloyd's Register
Foundation

© Sistravessels.