

PROFILE FOR PROPOSAL NO. 8627.








SCALE: 1/8" = 1'-0"

LENGTH BETW. PP 210'-0"
BREADTH 35'-0"
DEPTH MOULDED TO UPPER DECK 13'-9"
QUARTERDECK 17'-3"

TO BE BUILT TO CLASS LLOYD'S 100-A1 * SINGLE DECK
WITH POOP & QUARTER DECK CONNECTED AND FORECASTLE
DOUBLE BOTTOM TO CARRY OILFUEL & WATERBALLAST.
OILFUEL OF A FLASHPOINT ABOVE 150° FAHR.

POOP DECK

UPPER DECK

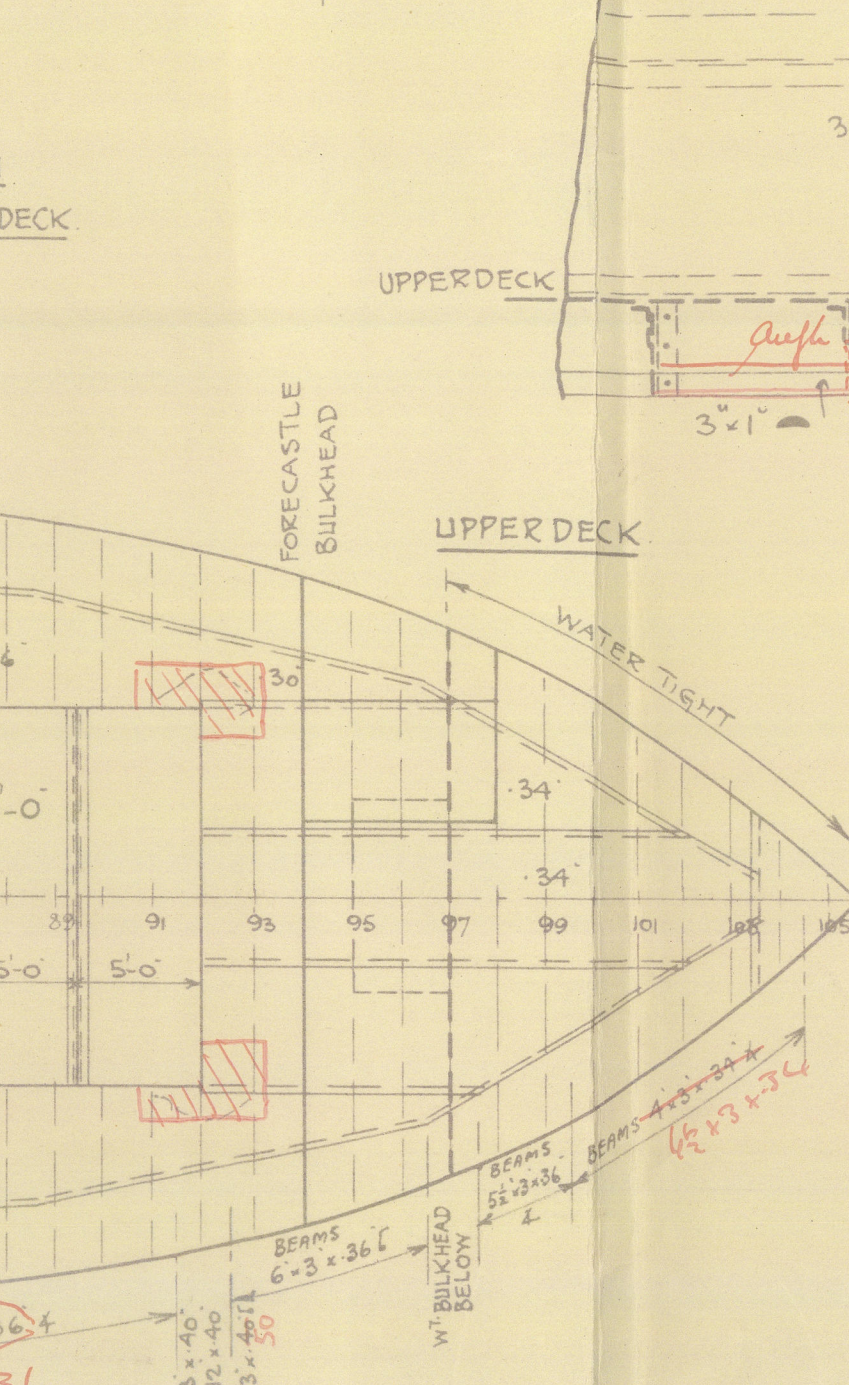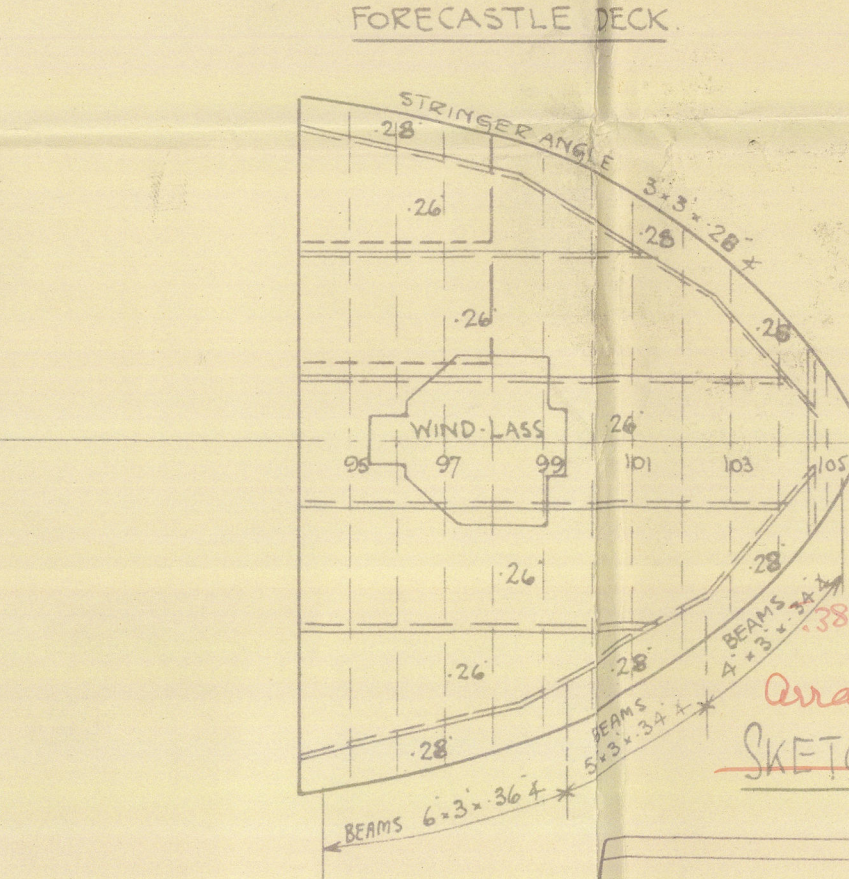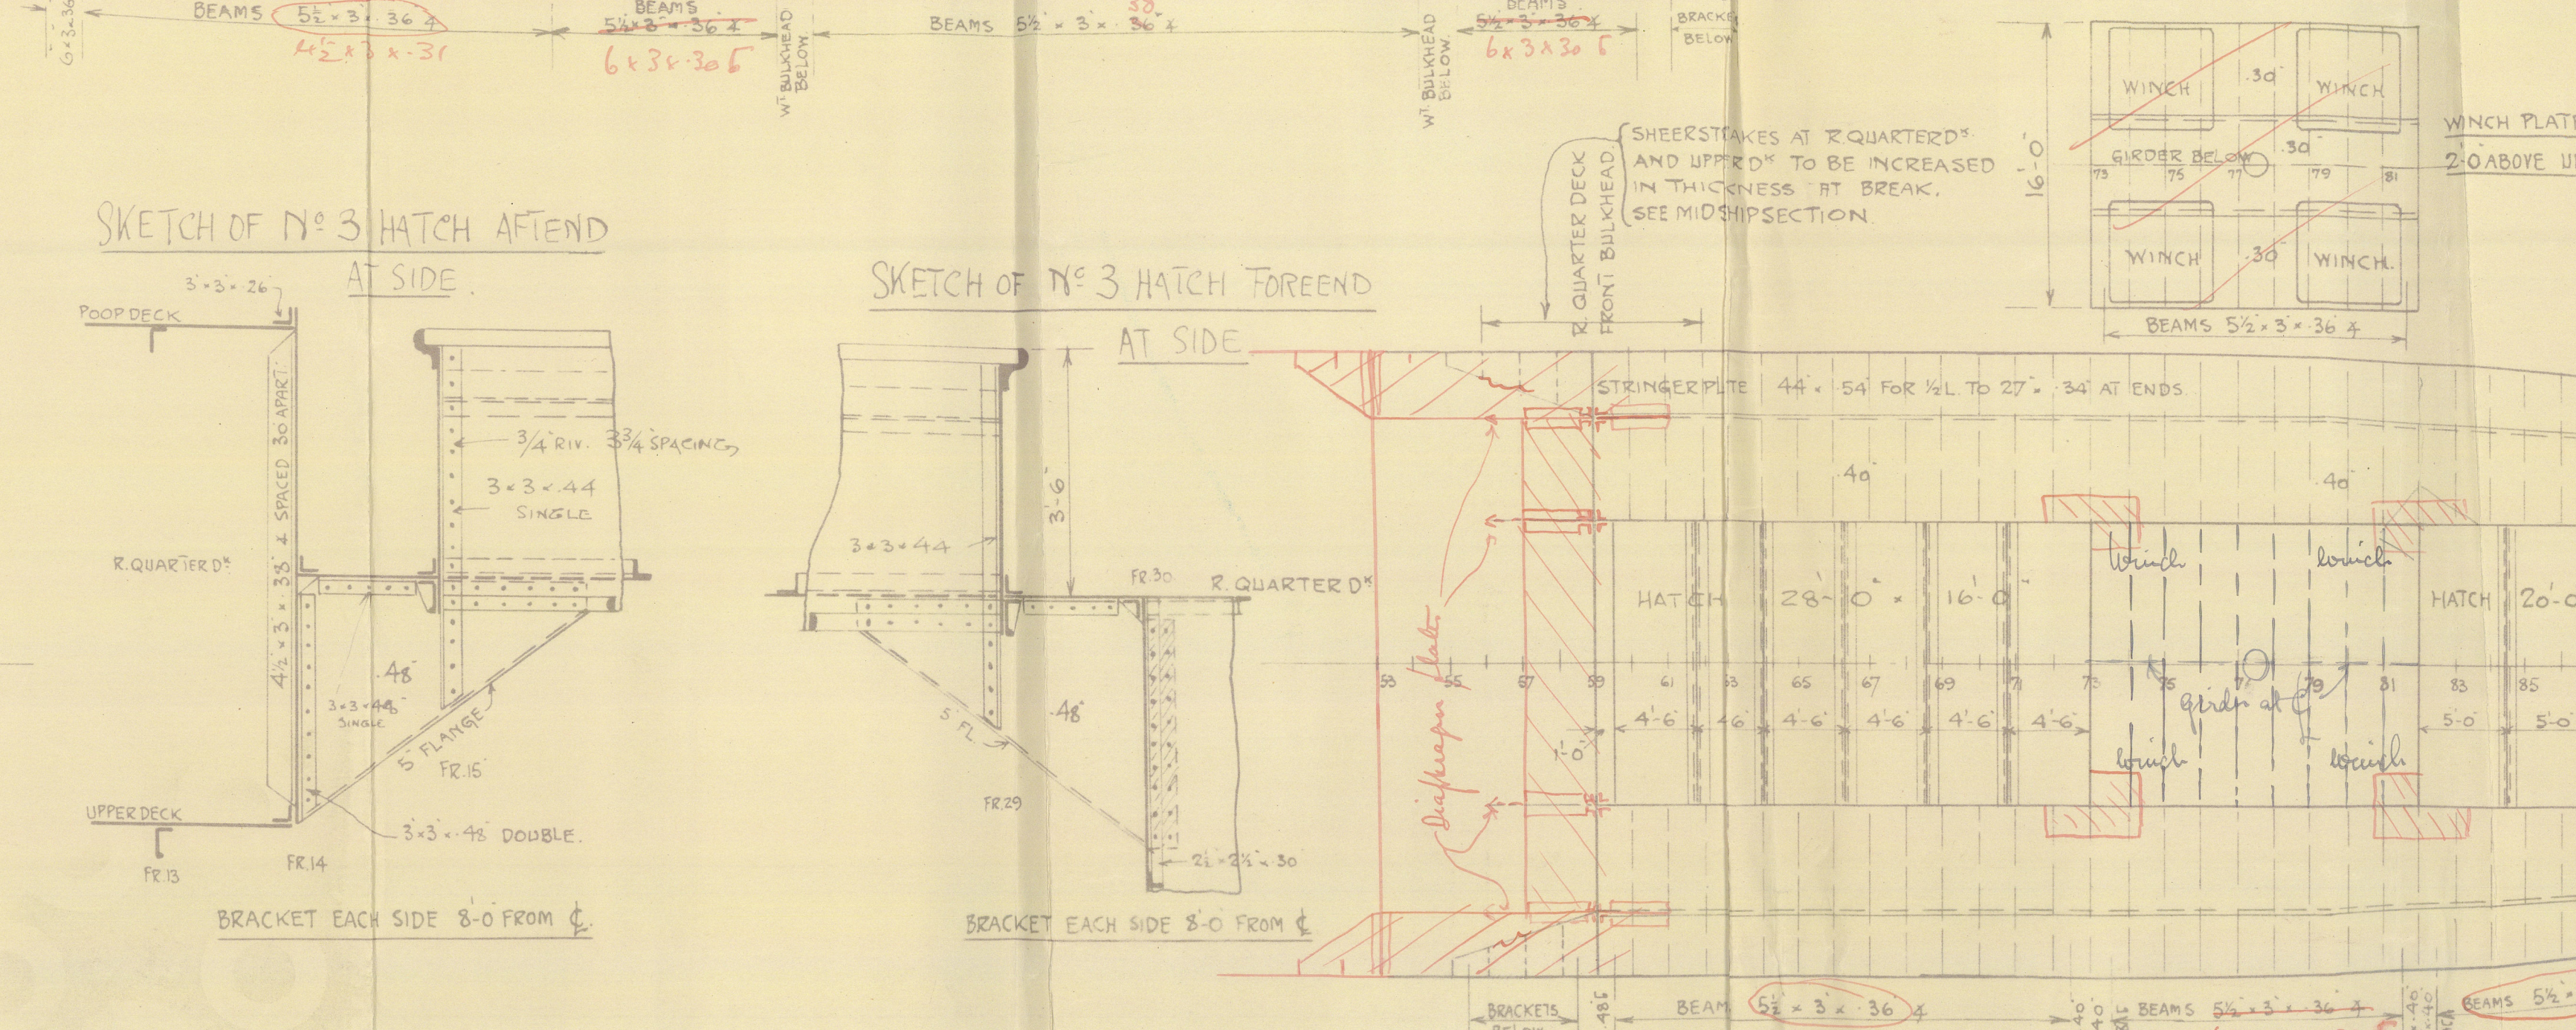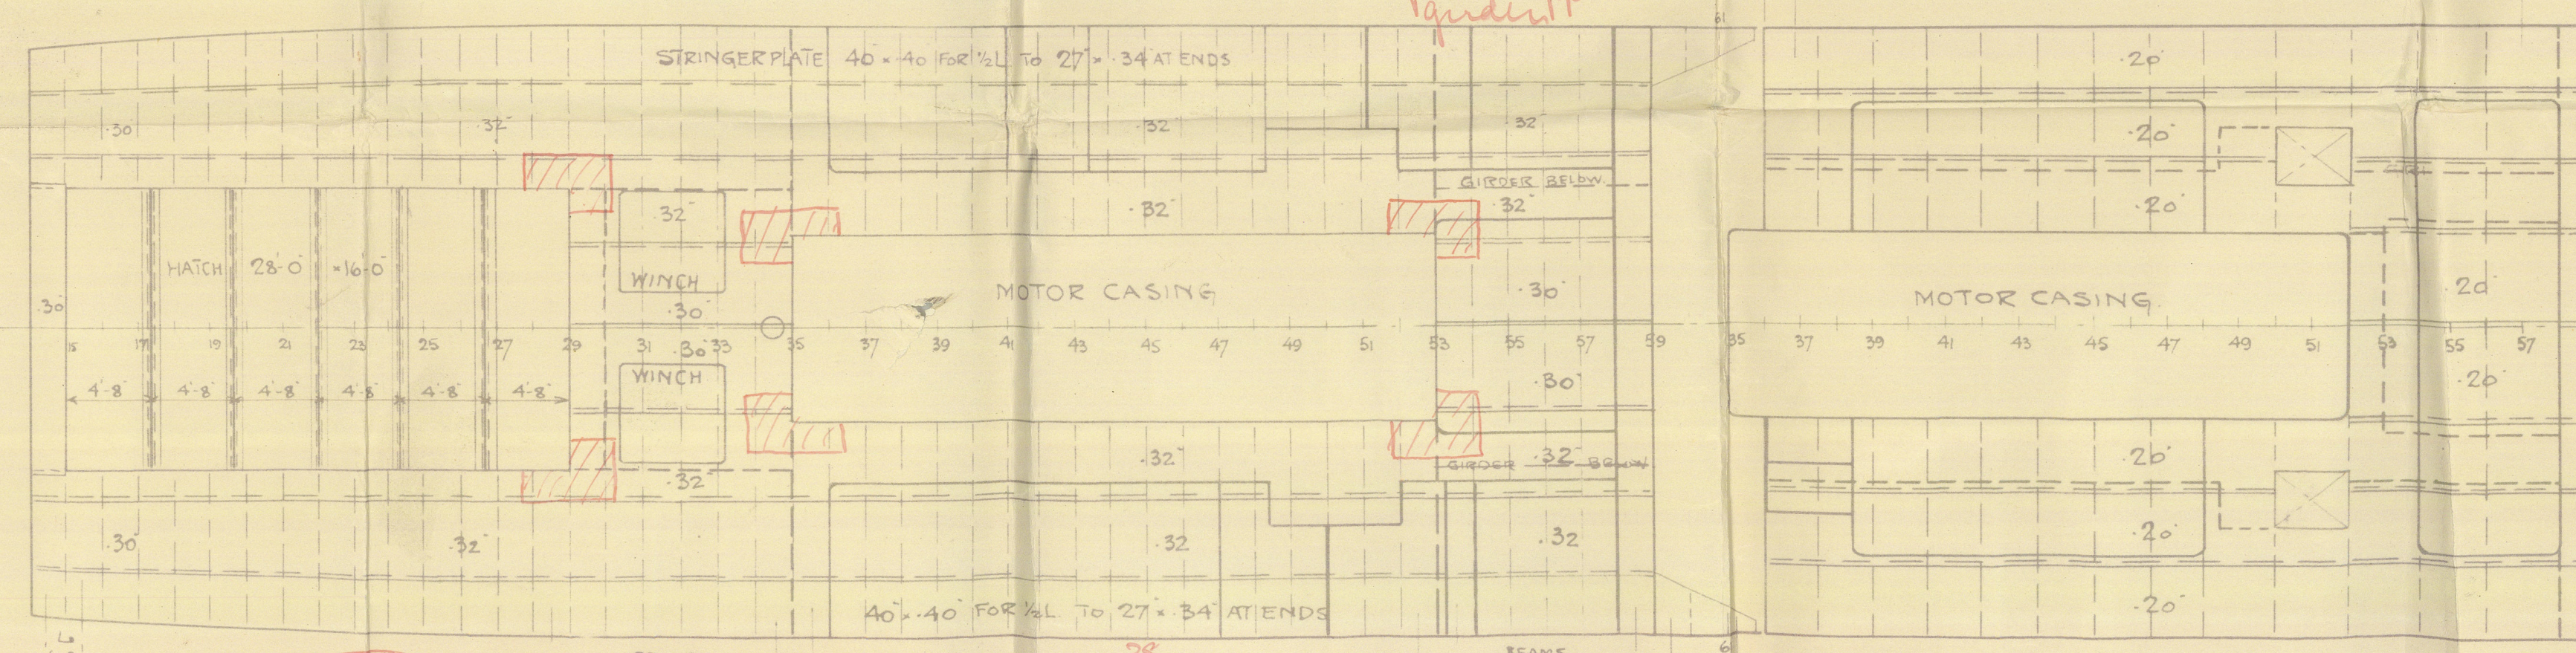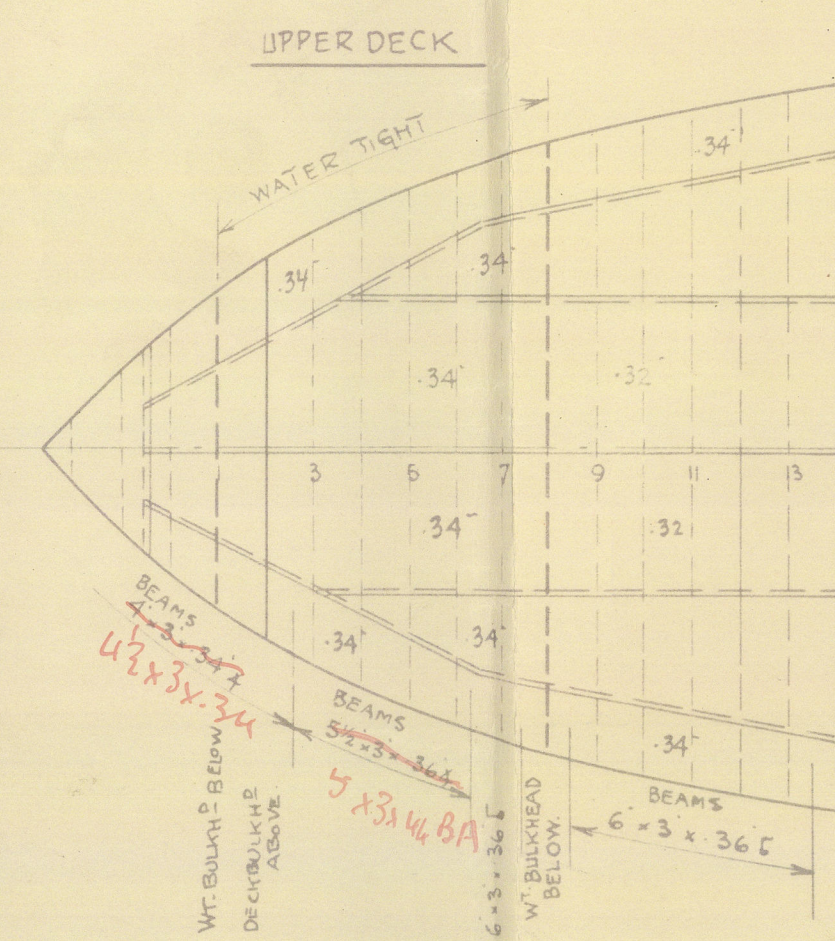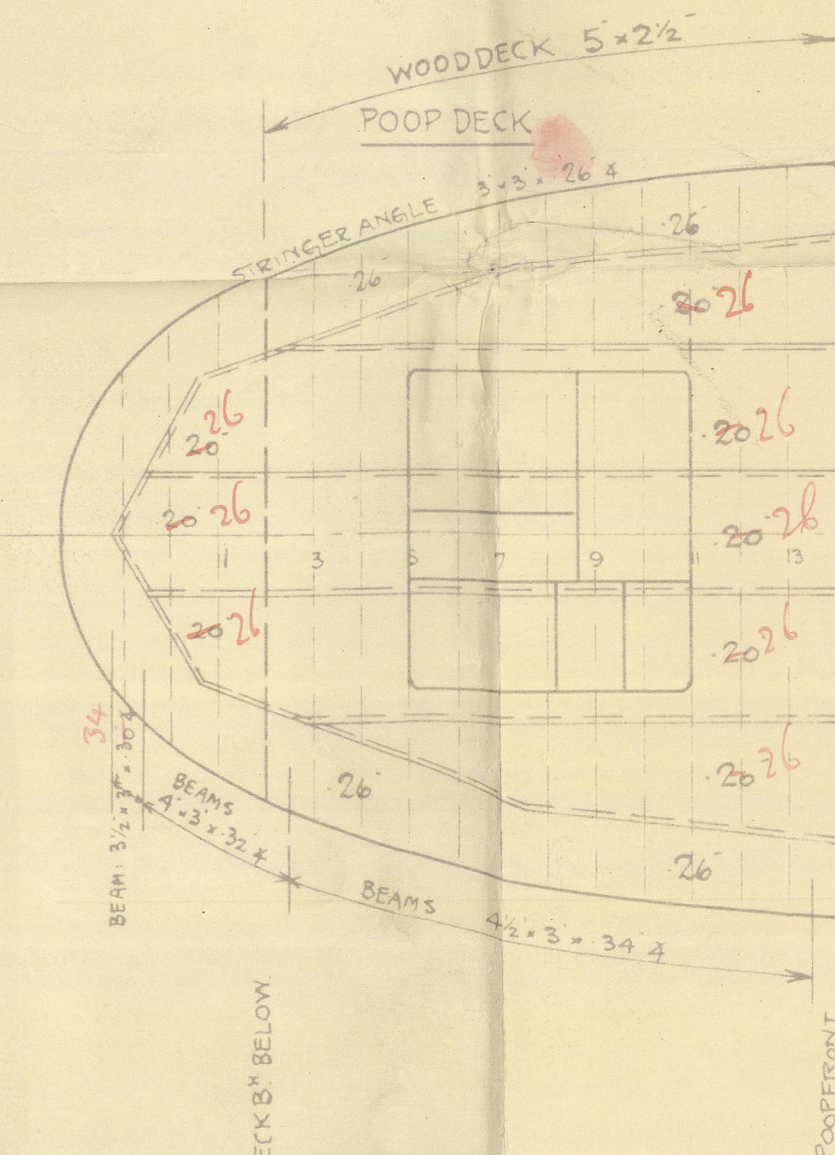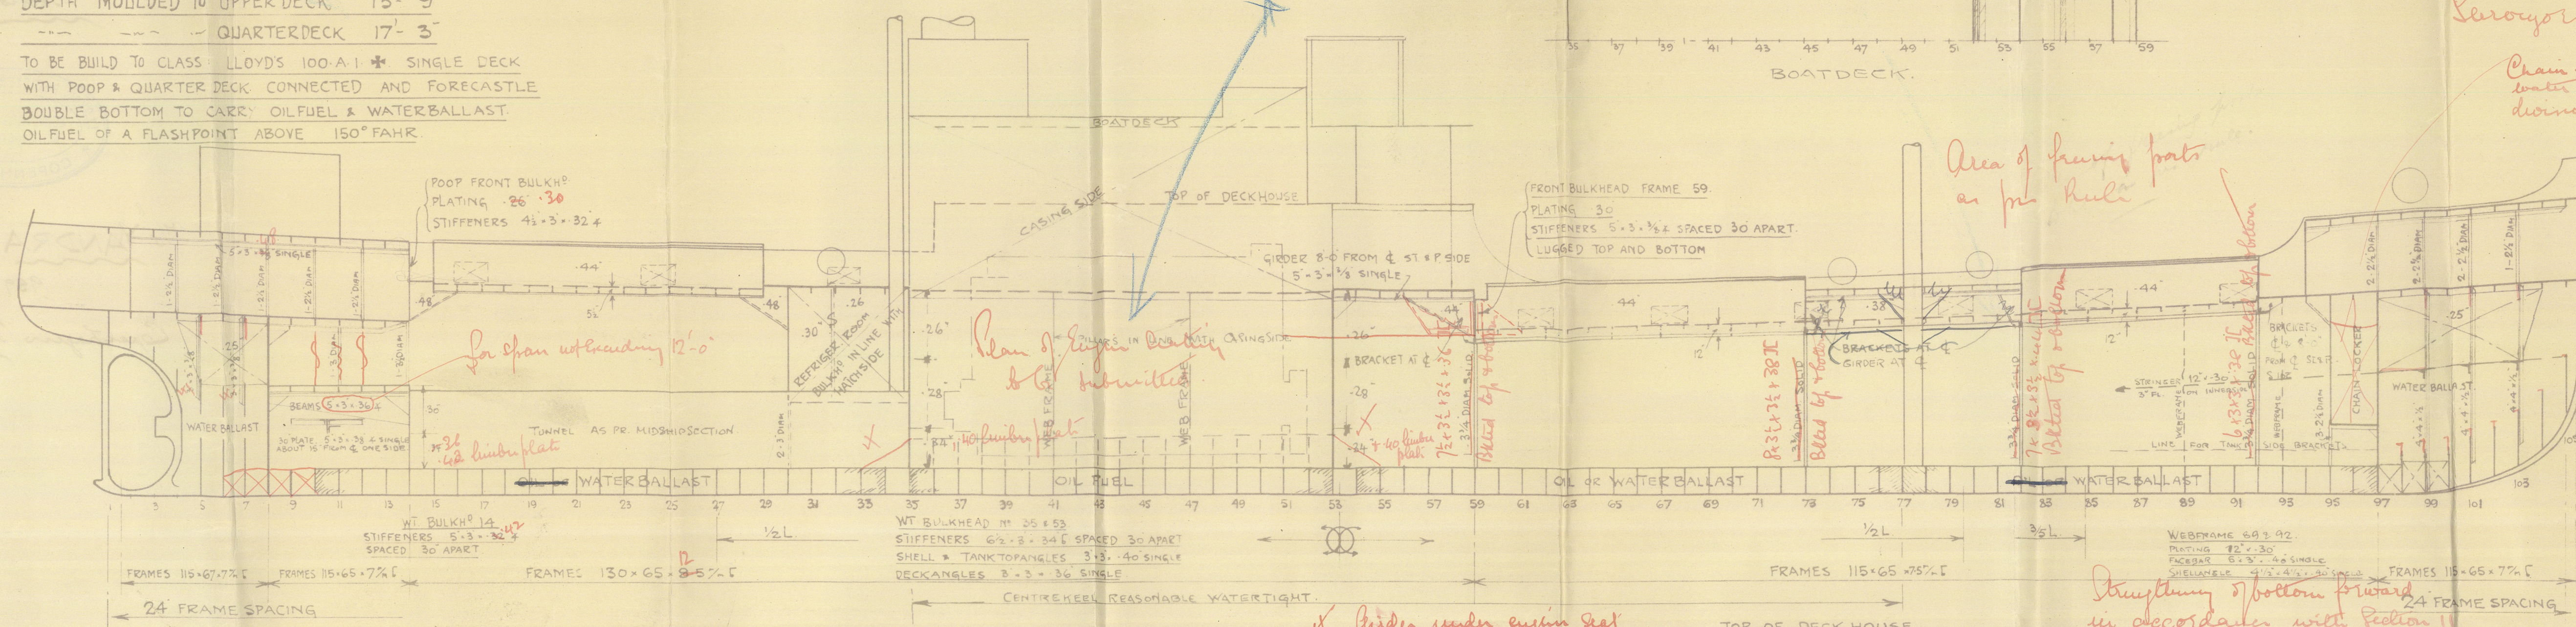

FORECASTLE DECK

UPPER DECK

STRINGER 27.34.40

PATINGS 4.3.24.2

WATER BALLAST

WATER BALLAST

WT BULKHEAD FRAME NO 97

SCALE 1/4" = 1'-0"

3.3 x 36 SINGLE

UPPER DECK

24






















SKETCH OF HATCH N°2

FOREEND AT C

WINCH PLATFORM 2'0" ABOVE UPPER DECK

5.3 x 3/8 AT C

BRACKET

FRAME 73 AT C

3/4" DIAM. SOLID AT C















Arrangement of Hatch N°2

SKETCH OF N°2 HATCH FOREEND

AT SIDE






















9.3 x 48 IN WAY OF HATCH

AND RUNNING IS BEYOND



THIS DRAWING IS STRICTLY CONFIDENTIAL

AND MUST ON NO ACCOUNT BE COPIED OR

DISCLOSED FOR ANY THIRD PERSON.

COPENHAGEN. DATE: 4/9.27

AKTIESELSKABET

BURMEISTER & WAINSKIN-OG SKIBSBYGGERI.

21. marts

005679-005686-0066

W.J.
14.9.27

PROPOSAL 8627
12931

2.9.27

2020

PROFILE.

Foundation


5551
Louisa. Sec.



© 2020

Lloyd's Register
Foundation

0000-08500-61000

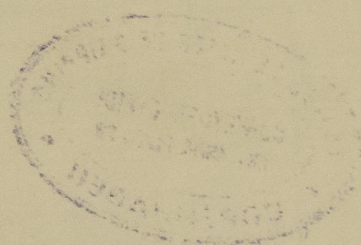

© 2020

Lloyd's Register
Foundation

Burn. & Wain,

Copenhagen,

Neer. No. 555.

for Adelaide Steamship Co.


Longitudinal
Section.



"M/S. YANDRA" of Port Adelaide.

989 Tons gr.

Copenhagen Report No. 7808.

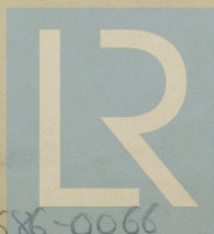

© 2020

Lloyd's Register
Foundation

003679-003686-0066