

Rpt. 6.

For the information of Surveyors and the Committee only.

Received at

Office

13 FEB 1934
19

Lloyd's Register of Shipping.

(Report on Vessel No. 44054 Port Hull)

No.

SHIP FORGINGS OR CASTINGS.

I have to report that the undermentioned Iron or Steel Forgings or Castings, manufactured by Messrs T.S. Forster & Son Ltd. of Sunderland for the Vessel No. 1115, being built by Messrs Bockrane & Son of Selly have been inspected by me as set forth below and found to be, so far as can be seen, Sound.

Mark on Forgings or Castings.

Lloyd's



No. 6836-

JD 28.4.33

J Dale
Sunderland

| | STERN FRAME. | RUDDER FRAME. | STEM. |
|---|-------------------------------|---------------|-------|
| Material* | <u>Scrap iron</u> | | |
| How made | <u>Forged & Smithed</u> | | |
| If annealed | | | |
| Dimensions | <u>6-7 3/4 x 3 1/2</u> | | |
| Progress on Inspection | <u>Forging & Smithing</u> | | |
| Date when Inspected | <u>28.4.33</u> | | |
| CASTINGS. | | | |
| Tests on Standard Test Pieces. | | | |
| Tensile Test— | | | |
| Tons per square inch | | | |
| Extension per cent. | | | |
| Cold Bending Test— | | | |
| Angle before fracture | | | |
| Drop Test— | | | |
| Height from ground | | | |
| Hammering Test— | | | |
| If made according to Rules and found satisfactory | | | |

SKETCHES OF FRAMES SHOWING POSITION AND DESCRIPTION OF WELDS OF FORGINGS.

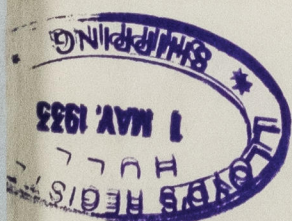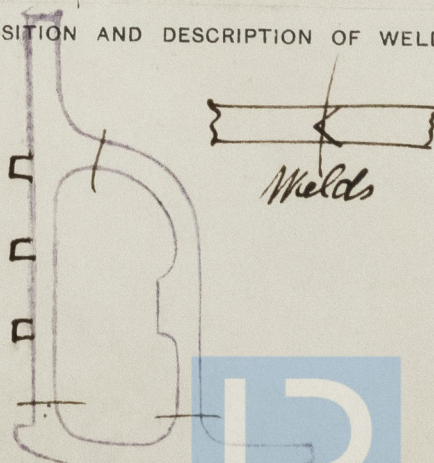

Fee (if any chargeable) £

To be paid at

* If of Iron, state whether scrap or puddled Iron. If of Steel, state whether made on the Open Hearth process.

5m.3.20. T.

003698-003705 0027

© 2020

Lloyd's Register
Foundation