

712

Glasgow to 71523

4 - MAR 1947

Rpt. C. 11 (Contd.)

Index No. ....

# Lloyd's Register of Shipping.


Ship's Name SAINT EUNAN

Official No. 115054

Memorandum of alterations reported since ship was surveyed for assignment of Load Lines  
in .....

RAISED QUARTER DECK.

(PORT SIDE)

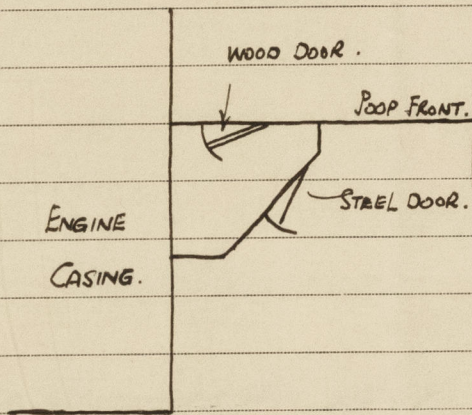


WOOD HINGED DOOR IN POOP FRONT. 4'-3" x 22". 18" SILL ABOVE R.O. DK.

STEEL " WEATHERTIGHT DOOR. 4'-9" x 24" 18" " " " "

14-1

*S. Berry*

Noted  
4 - MAR 1947  
EY

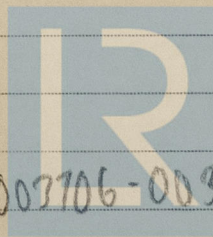

© 2020

Lloyd's Register  
Foundation

003706-003711-0057

003706-003711-0056 1/2