


S. S. No. 211 & 212.

RUDDER & STERNFRAME

LLOYDS. CLASS.





*100. A. 1.

STEERING CHAINS $\frac{3}{4}$ "
" RODS 1"

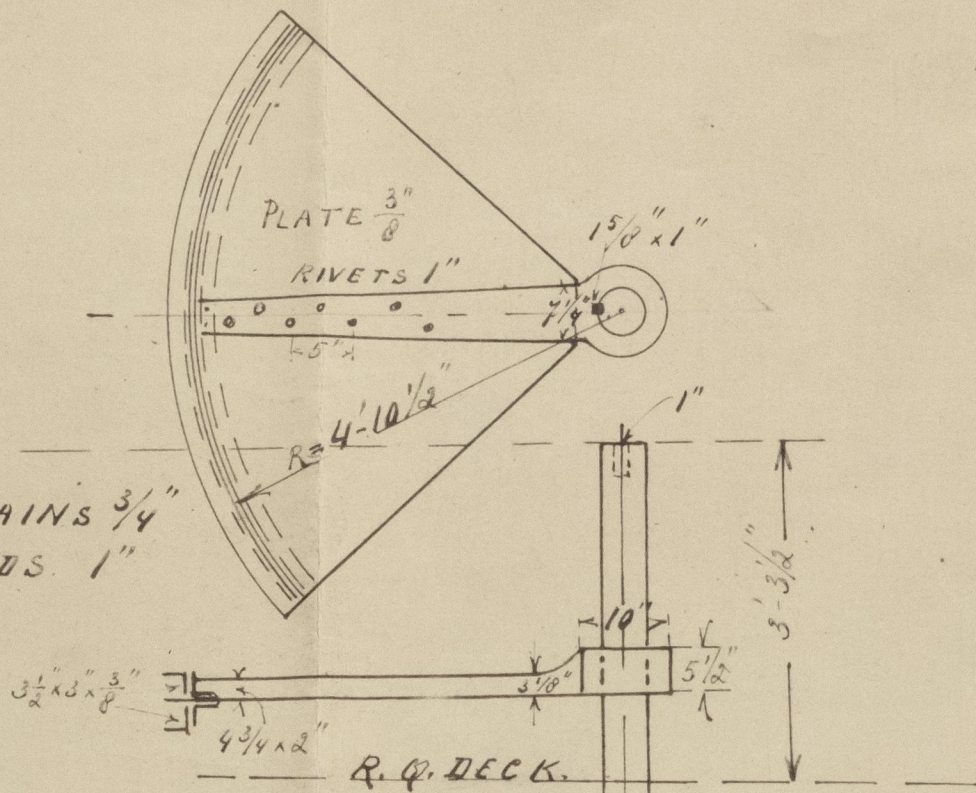




SCALE 1:20.

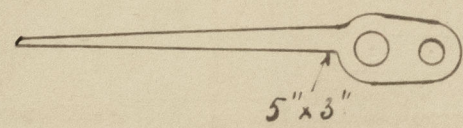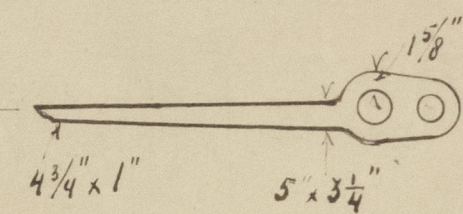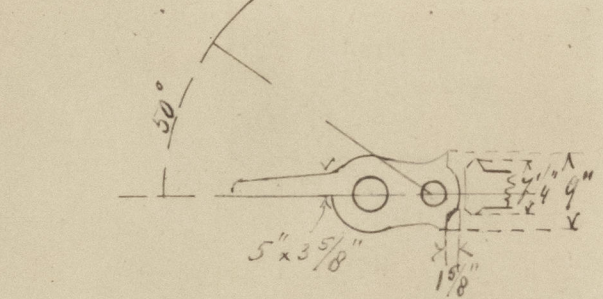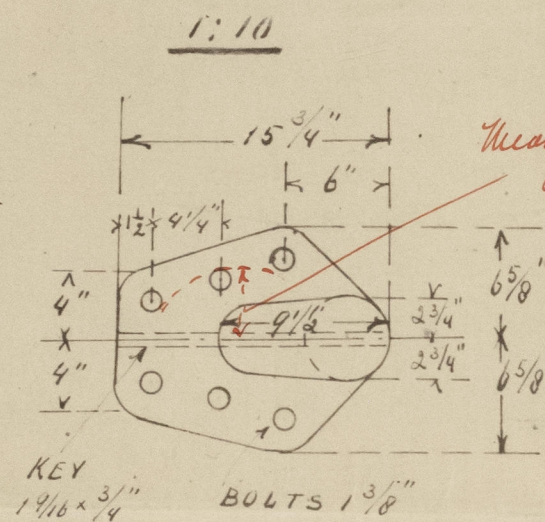

See Wellington Rpt 758



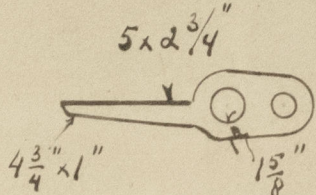


GEBR. V.D. WINDT
SCHEEPSWERF
VLAARDINGEN

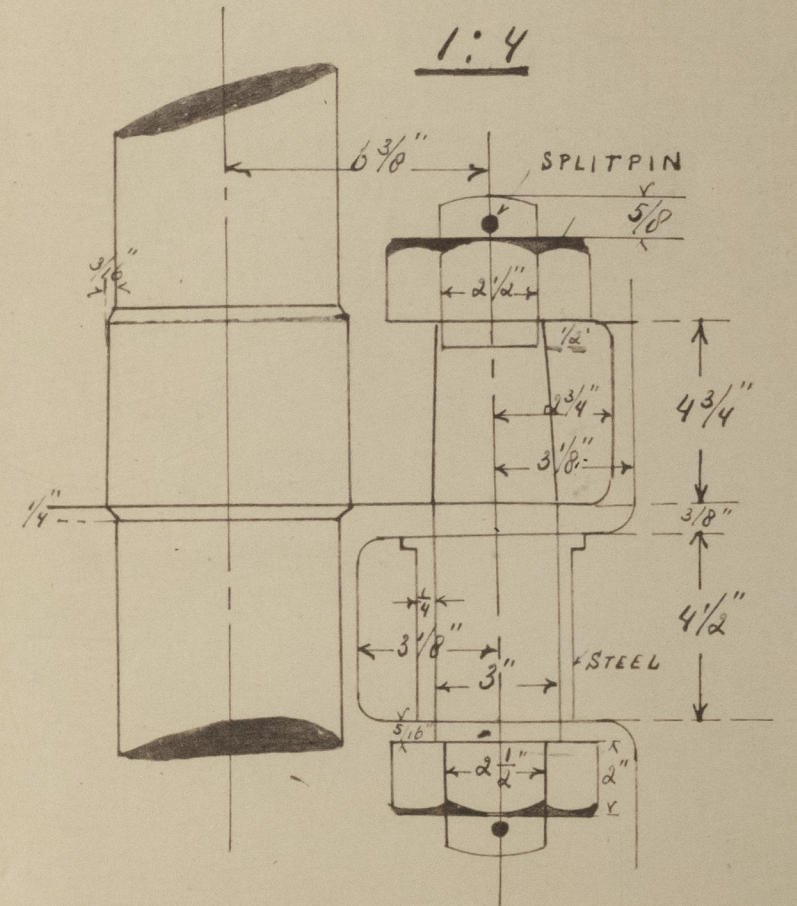

SPEED NOT ABOVE 10 KNOTS

FORGED IRON
OR
CAST STEEL

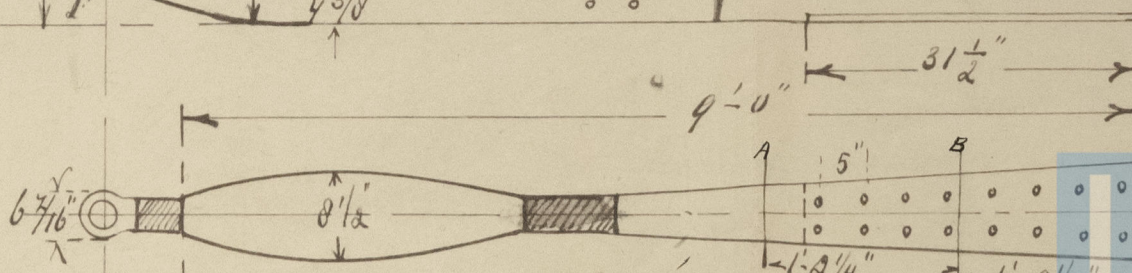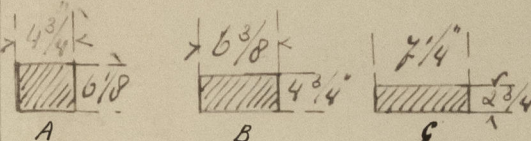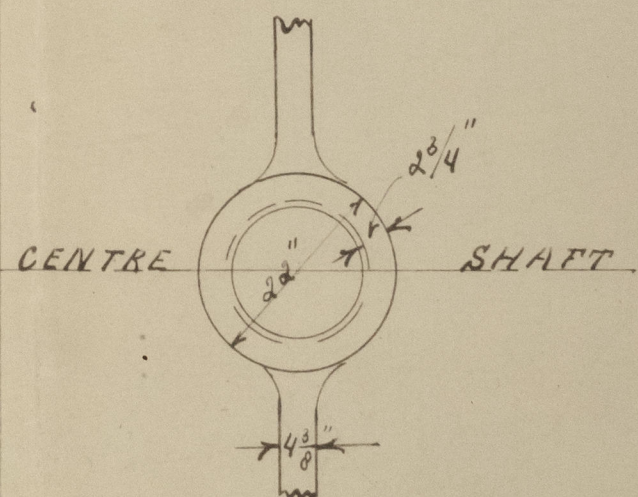

Gehr. Windt. Scheepswerf.

2119212

Sternframe & Rudder.

~~Gouda 2954~~
"Oostcappelle" #
Rot. 12534



© 2020

Lloyd's Register
Foundation

003706-003711-0062