



Gebrs v.d. Windt.
Scheepswerf
Vlaardingen.

Bridge Deck

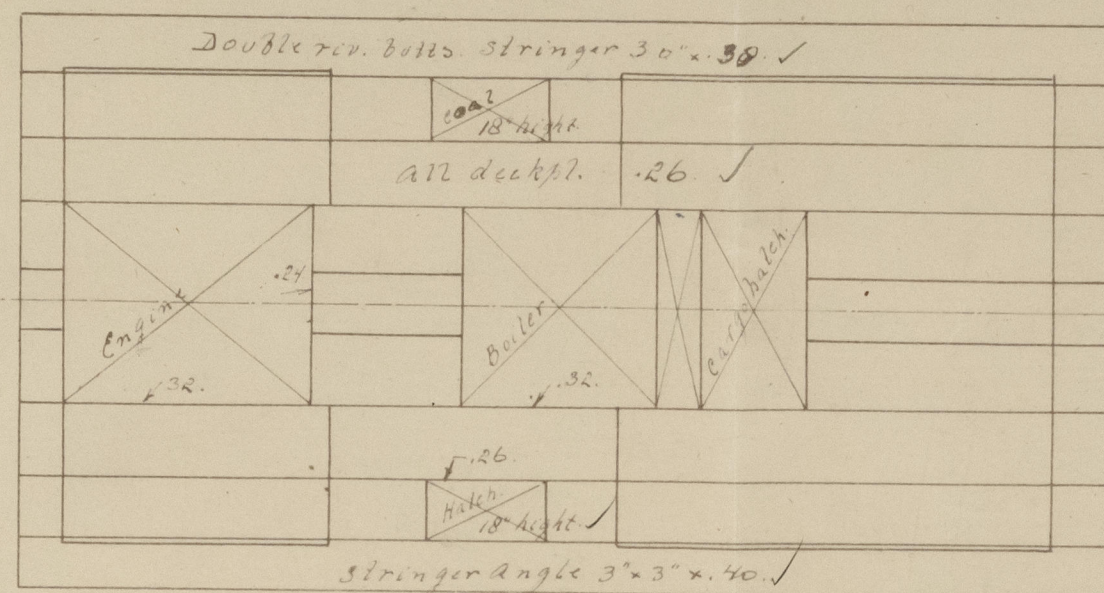

General Arrangement
of a
Cargo Steamer.

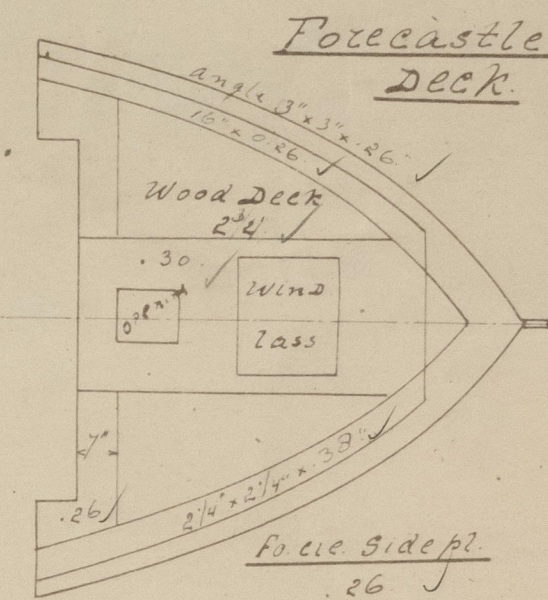

Scale 1:100

R. Q. Deck.

Gott. Wundt. Schepswarf

N^o 211712

Gen Arrangement

~~geboren 29.5.4~~

"Postappelle"

Rot. 12534.



© 2020

Lloyd's Register
Foundation

003106-003111-0065