

Nº 63-~~4~~ "EMPIRE JET"
MIDSHIP SECTION as built


DIMENSIONS:- 460'-0" B.P. x 61'-0" MLD. x 33'-3" MLD. TO UPPER DK.
SCALE $\frac{1}{2}$ " = 1 FOOT

LLOYDS NUMERALS.			
1 st LONGITUDINAL N°	L. D	460 - 33 25	= 15295 00
2 nd " "	L. (B.D)	460 - (610 - 33 25)	= 43355 00
L/D TO UPPER DECK		460 - 33 25	= 13 83
		D	= 33 25

RULE EQUIPMENT		
2ND LONG ST NO L ^Y (B.C.)		= 43355
POOP	97.5 x 7.5 x $\frac{3}{4}$	= 550
BRIDGE	46.5 x 7.5 x $\frac{3}{4}$	= 262
FORECASTLE	15.5 x 7.5 x $\frac{3}{4}$	= 250
HOUSE ON POOP DECK		= 443
" - BRIDGE -		= 478
EQUIPMENT NO = 45344		

2 POWER ANCHORS 77 CENTS EACH, STOCKLESS

1 STEAM "	22 "	EX STOCK	
240 FATHOMS	2 1/2	STUD CHAIN TACK CABLE	
120 "	4 1/4 "	SPECIAL FLEXIBLE STEEL WIRE	G = 24
"	5 1/4 "	SPECIAL FLEXIBLE STEEL WIRE	G = 24
2 HAWKERS	100 FATHOMS	2 3/4 STEEL WIRE	G = 12
2 WARPS	100 "	2 1/4 "	G = 12

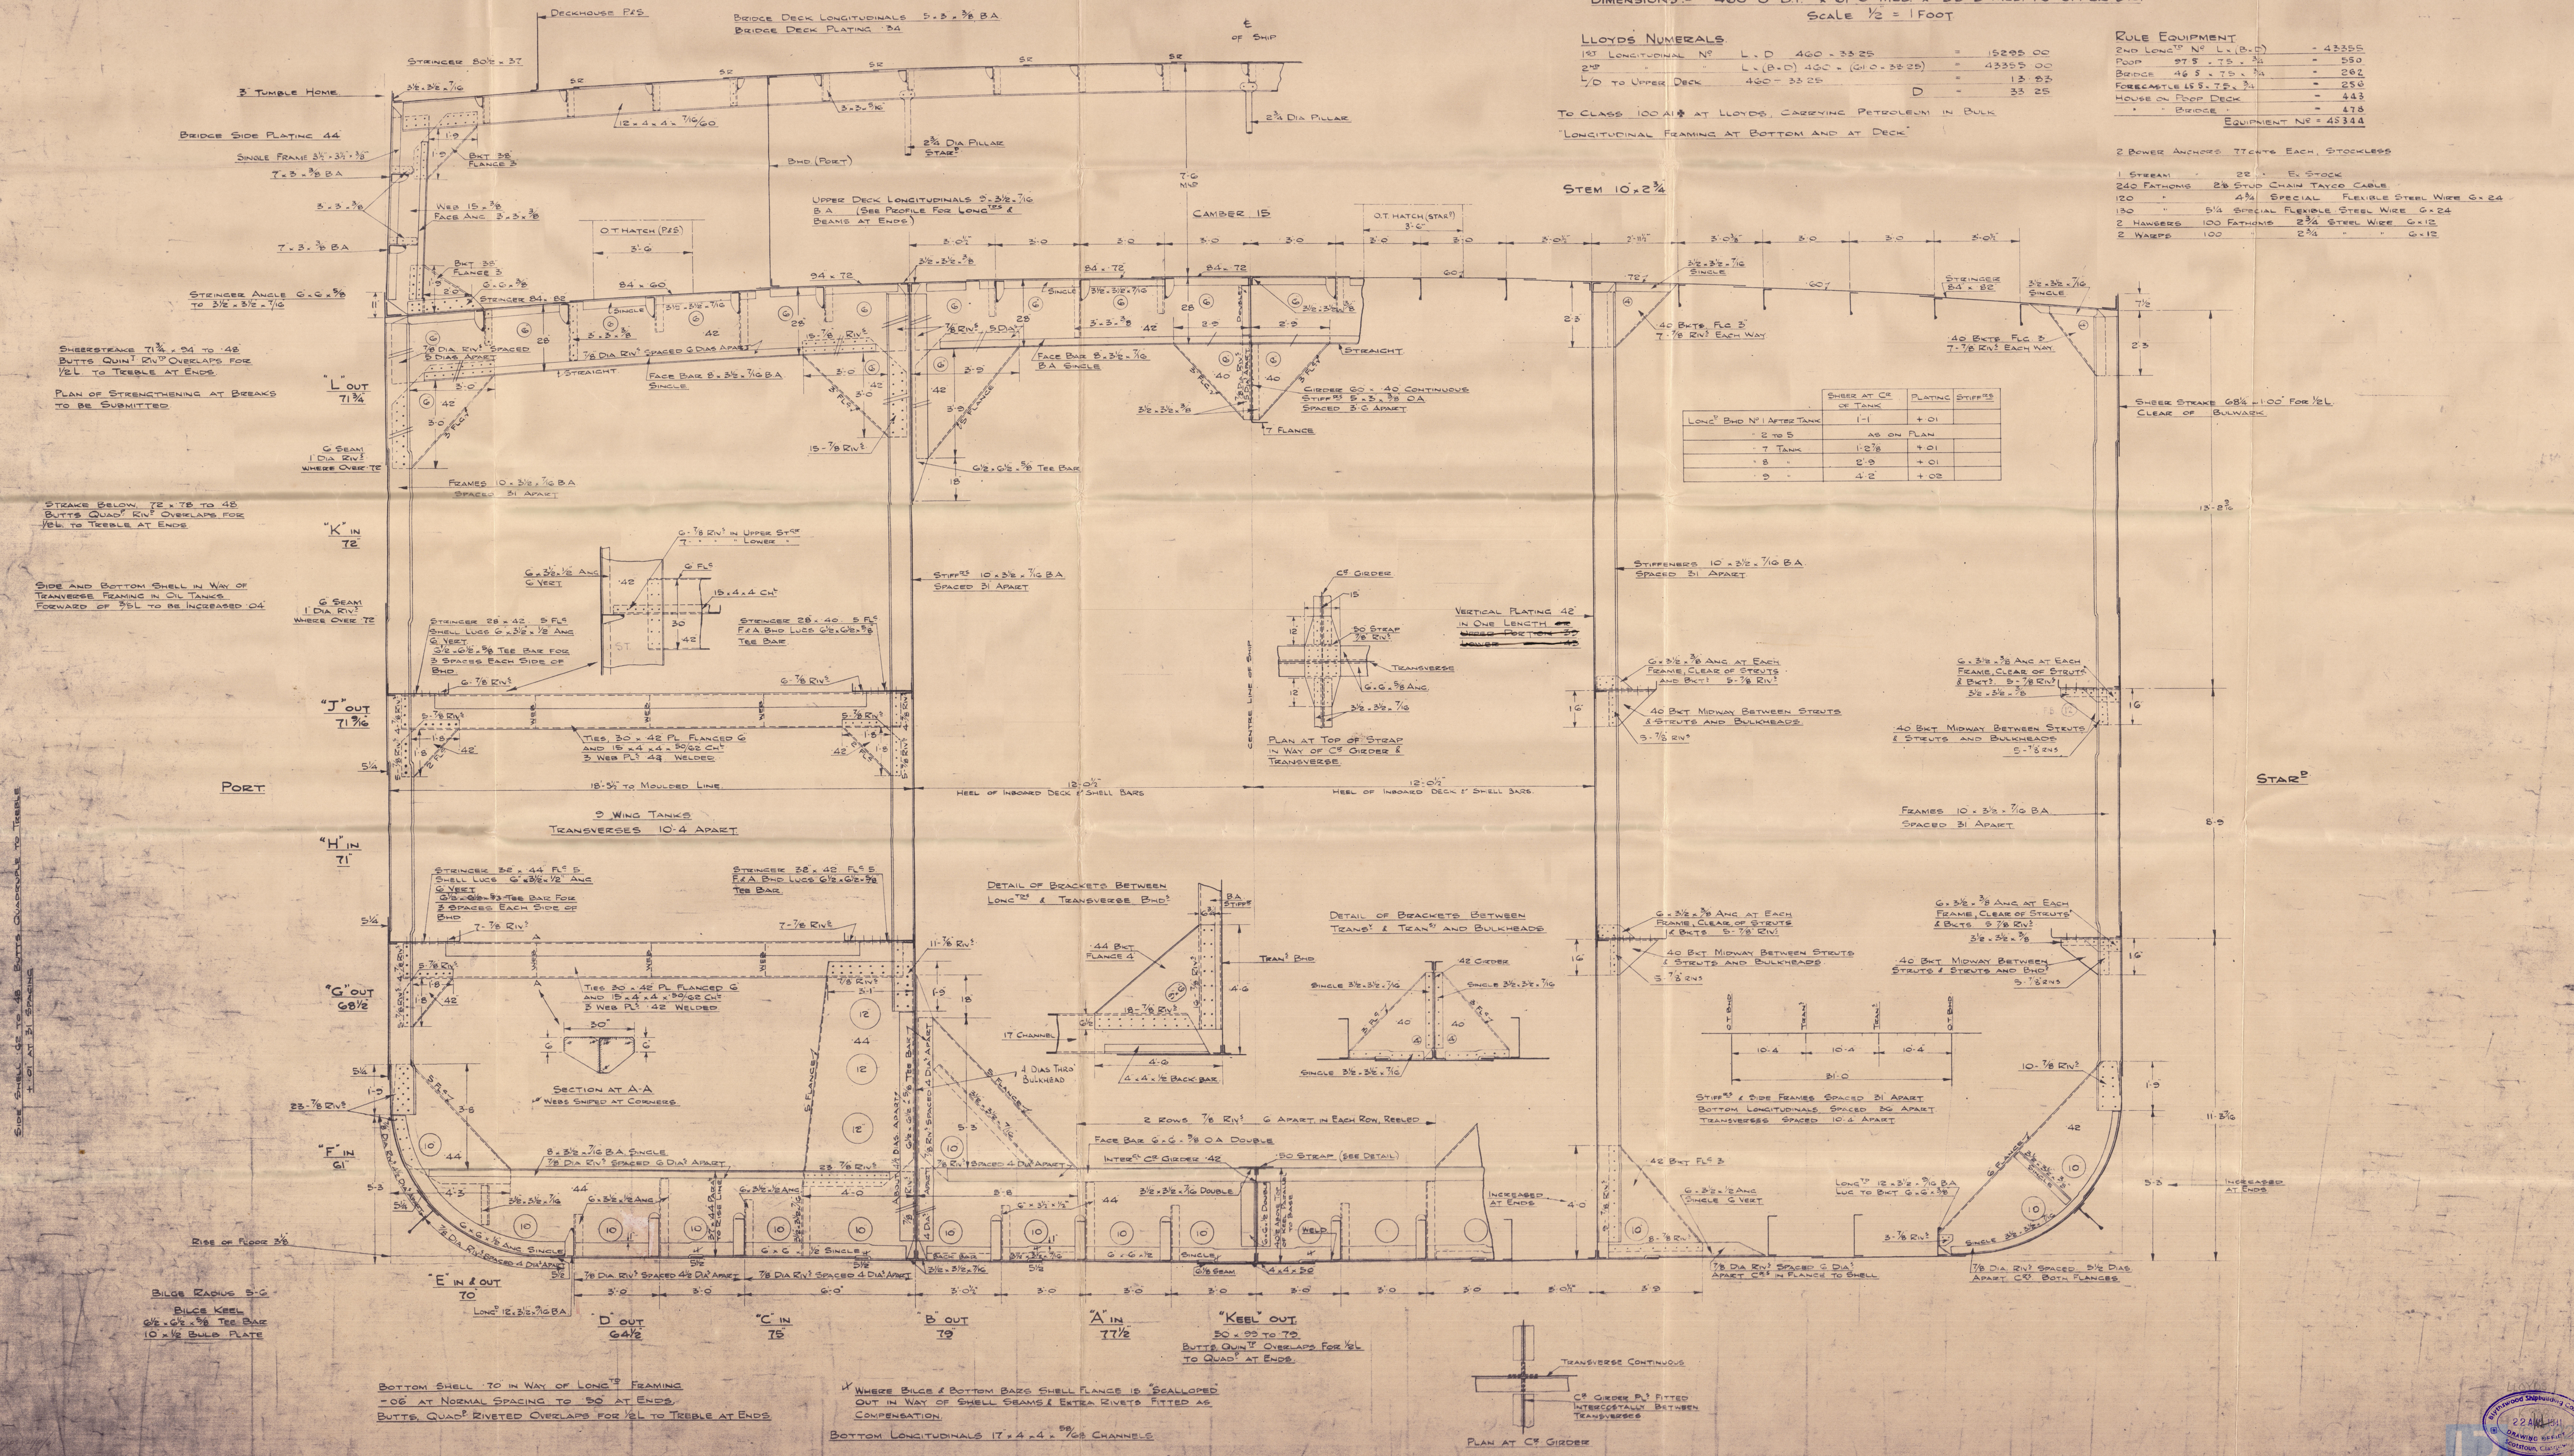

22
Blythwood S. B. Coy. Ltd

63

Empire Jet

in "Regent Jaguar"

Midship Section

(As built)

GLASGOW REPORT No. 64260



© 2020

Lloyd's Register
Foundation

003706-003711-0224