

For the information of Surveyors and the Committee only.

Received at \_\_\_\_\_ Office \_\_\_\_\_ 19

# Lloyd's Register of Shipping.

(Report on Vessel No. 22439 Port Roh)

No. 443

## SHIP FORGINGS OR CASTINGS.

I have to report that the undermentioned ~~XXXXXX~~ Steel Forgings ~~XXX~~  
~~XXXXXX~~, manufactured by Werkspoor N.V.  
of Amsterdam for the Vessel No. 872, being built  
by L.Smit & Zoon of Rotterdam  
have been inspected by me as set forth below and found to be, so far as can  
be seen, free from defects.


Report on Forgings or Castings.

Lloyd's  
No. 325  
F.N.B. 15.3.33

Port of AMSTERDAM, 30th March, 1933.

*P. N. Bennen*

	STERN FRAME.	<del>BUDDER</del> <del>IRON</del>	<del>STEEL</del>
Material* ...	S.M. Steel		
How made ...	Forged		
Annealed ...	Yes		
Dimensions ...	As per plan		
Progress on Inspection ...	black forged & finished		
When Inspected ...	19/1 - 15/3		
CASTINGS.			
Tests on Standard Test Pieces.			
Tensile Test— Tons per square inch ...	30.1		
Elongation per cent. ...	28%		
Bending Test— Angle before fracture ...	Good		
Height from ground ...	-		
Hardening Test— made according to Rules and found satisfactory ...	-		

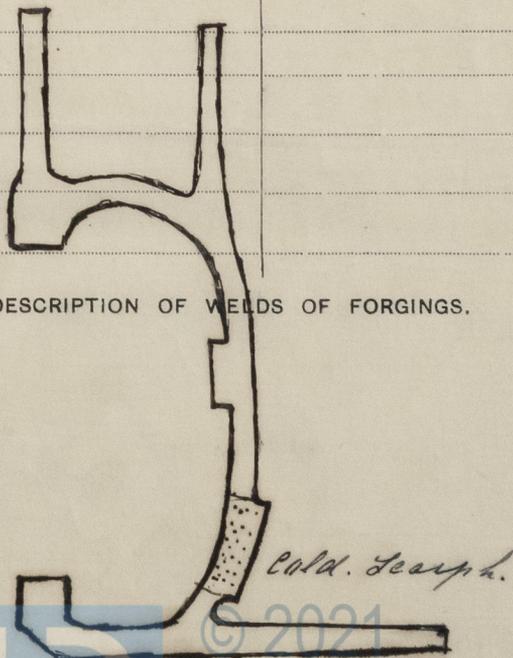

SKETCHES OF FRAMES SHOWING POSITION AND DESCRIPTION OF WELDS OF FORGINGS.

Fee (if any chargeable) £ 11.5  
8.0 To be paid at Amsterdam

of Iron, state whether scrap or puddled Iron. If of Steel, state whether made on the Open Hearth process.