


396

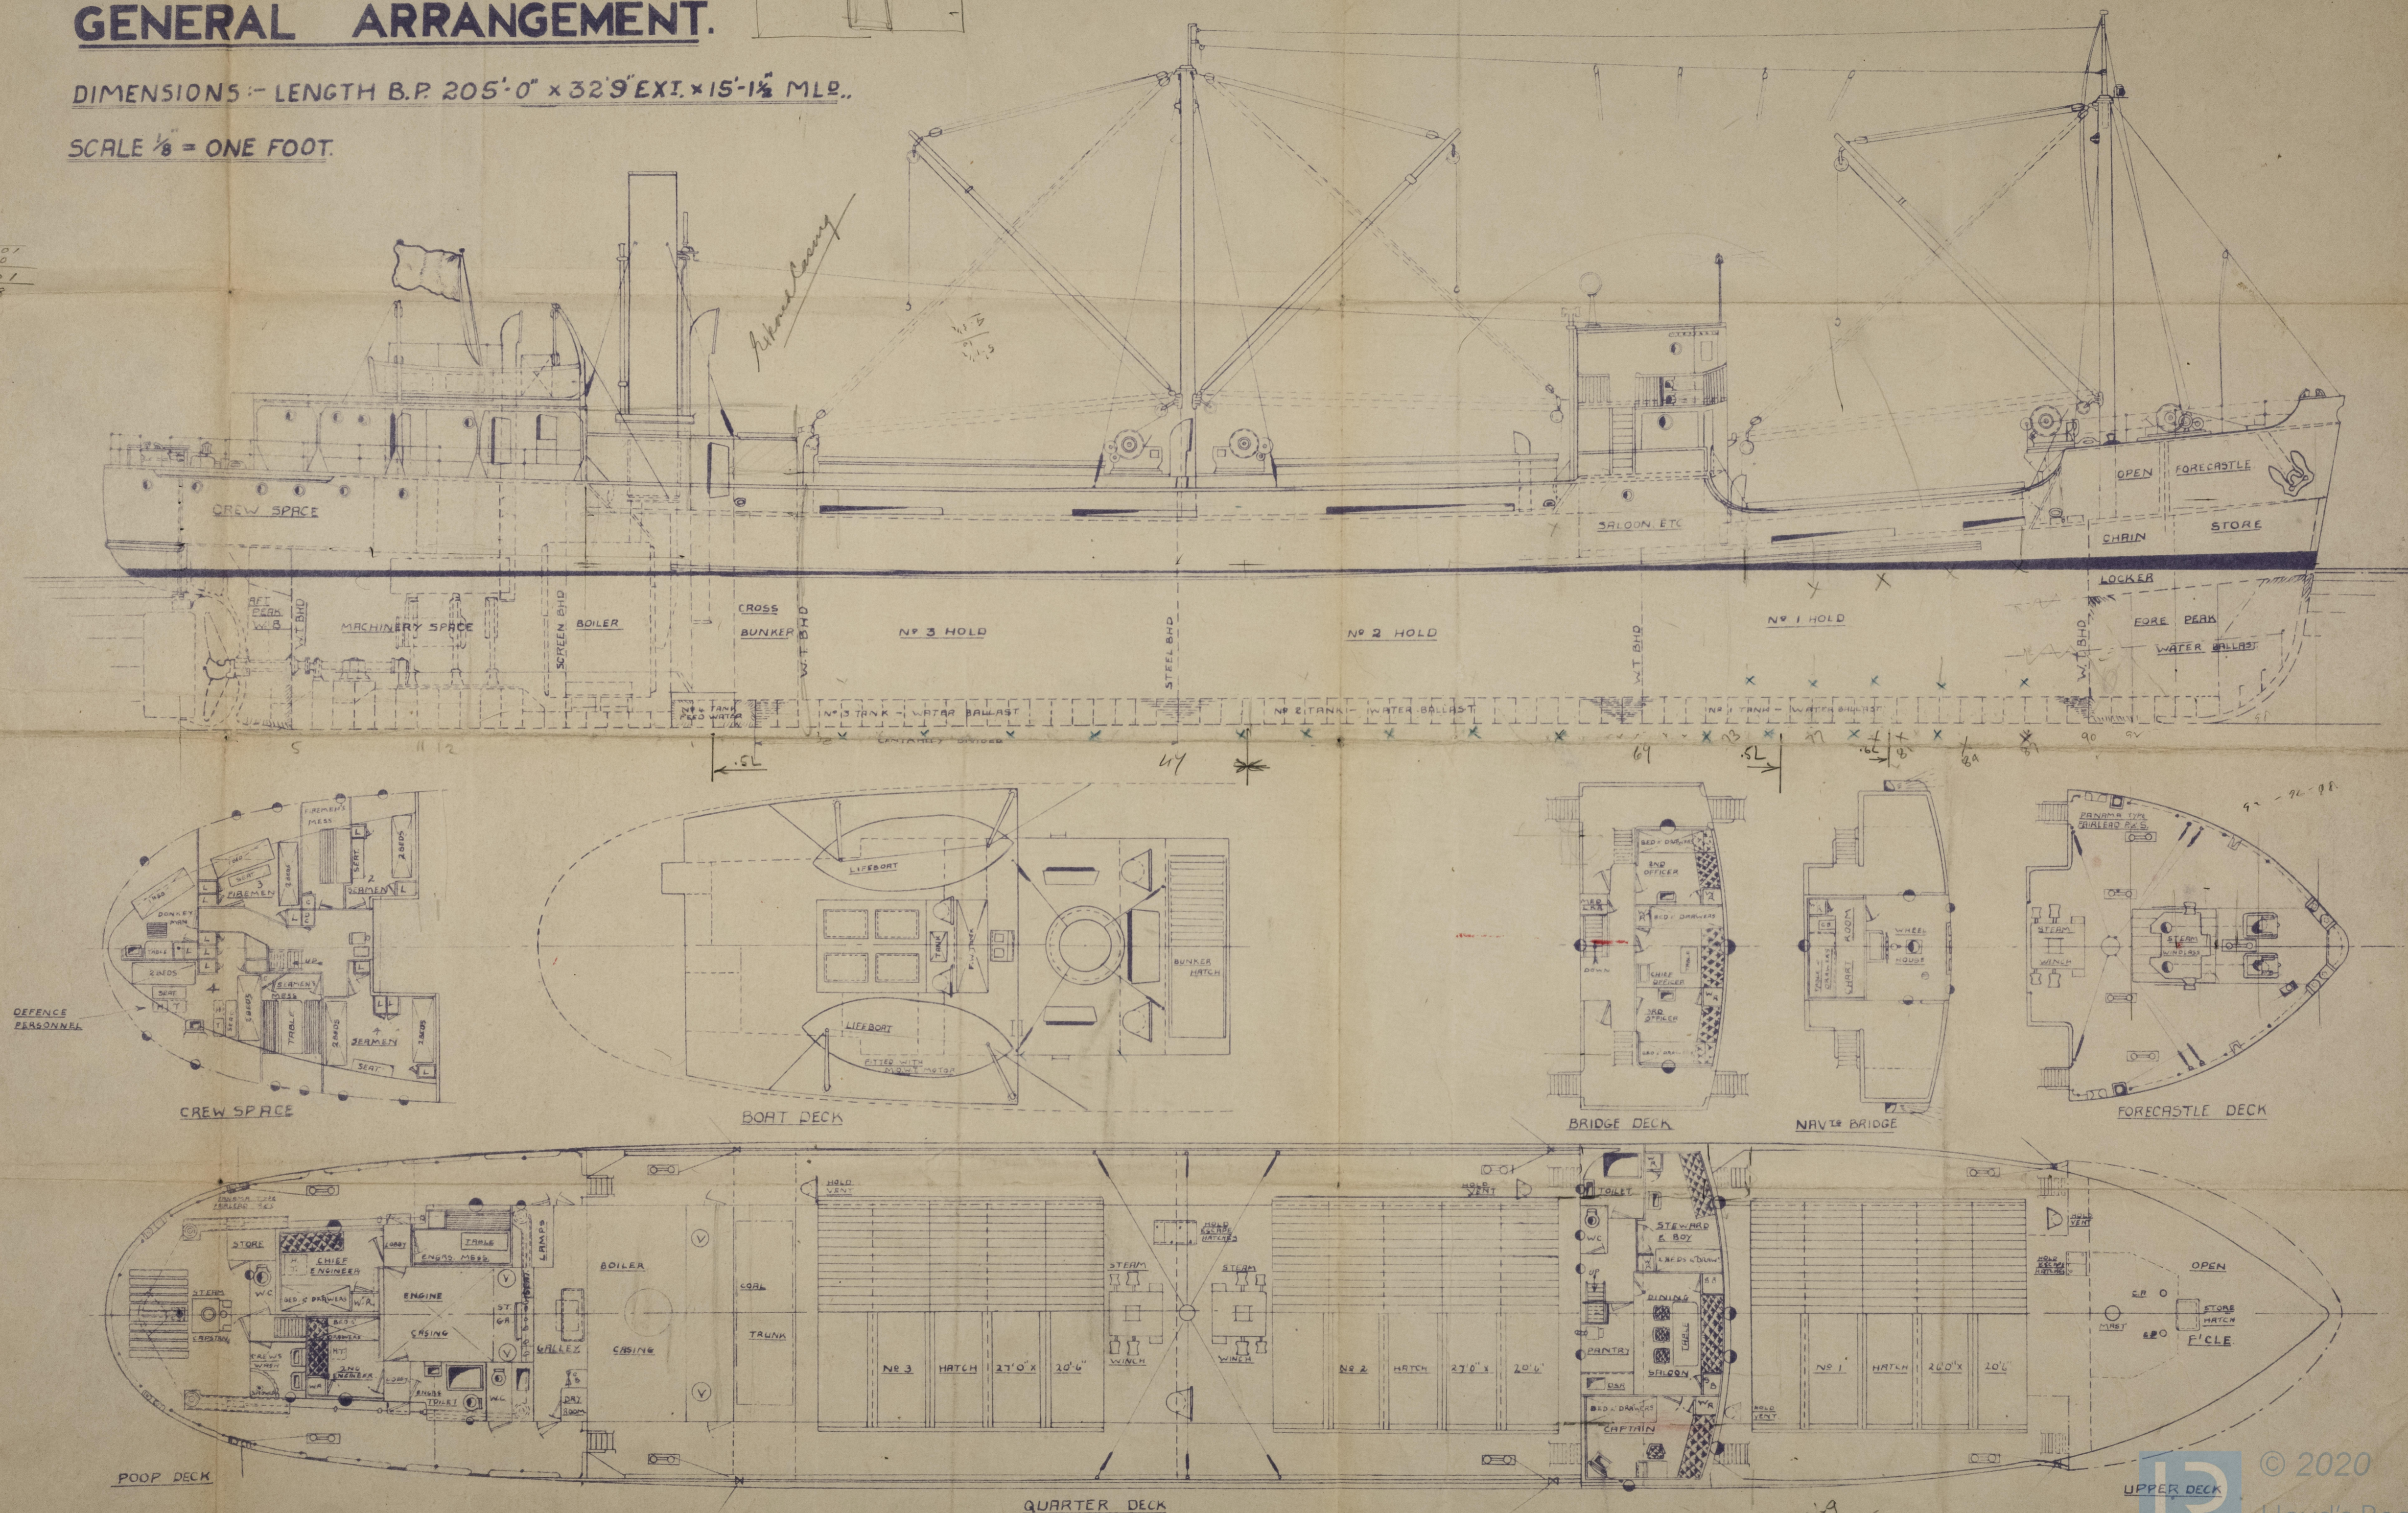

003788-003799-013

EA

General Arrangement

Ordoszan Blvd. Ltd.

No 297. 8.-9.0.

T.C. 2. 5. 42. 41. 9. 42 (Scotts)

T.C. 1-12. 43 (299.0).

NORMAN. QUEEN. H.

also for

Scott & Sons 2 1/2.

Ordoszan Blvd 297



© 2020

Lloyd's Register  
Foundation

003788-003799 -0132