

Lloyd's Register of Shipping.

Ship's Name S/S "TEMPLE PIER"

Official No. 160509

Memorandum of alterations reported since ship was surveyed for assignment of Load Lines
in GENOA - NOVEMBER 1946


ALTERATION.

Additional crews quarters fitted in shelter tween deck on port side as shown in sketch. Companionsway built leading from port side after deckhouse to accommodations. Door to the same on upper deck constructed of teak and operating both sides. Sill 18".

9 additional sidescuttles 12" \square fitted in the above accommodations, properly constructed with strong

deadlights. Deckhouse abaft tonnage opening enlarged to provide 2 cabins.

N.B. Deadlights to sidescuttles in former crew spaces aft, previously reported not fitted, now found in place and of satisfactory construction.

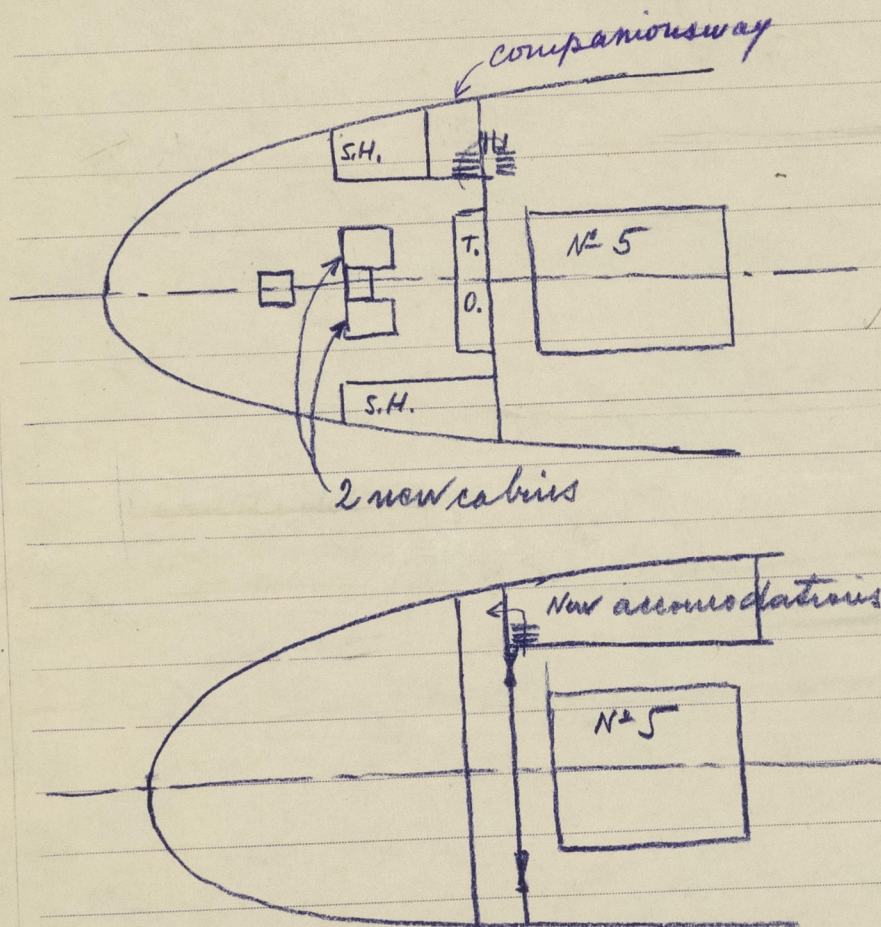

One new ventilator fitted on shelter deck aft leading to shelter tween deck. Coaming 31" X 40.
Closing - wood plug & canvas cover.

A. V. Giacomini