

M.S. "YENANGYAUNG".







PROFILE & DECKS. AS BUILT. (385)

DIM<sup>NS</sup>. <sup>415</sup>~~385~~' BP x 54'-0" B.M.<sup>LD</sup> x 31'-0" D.M.<sup>LD</sup> TO U.D.K.


SCALE  $\frac{1}{16}'' = 1'-0''$

LENGTHENED NWC 3/54 SEE REPORT

## MODIFICATIONS EFFECTED TO DESIGN OF BULKHEADS ETC

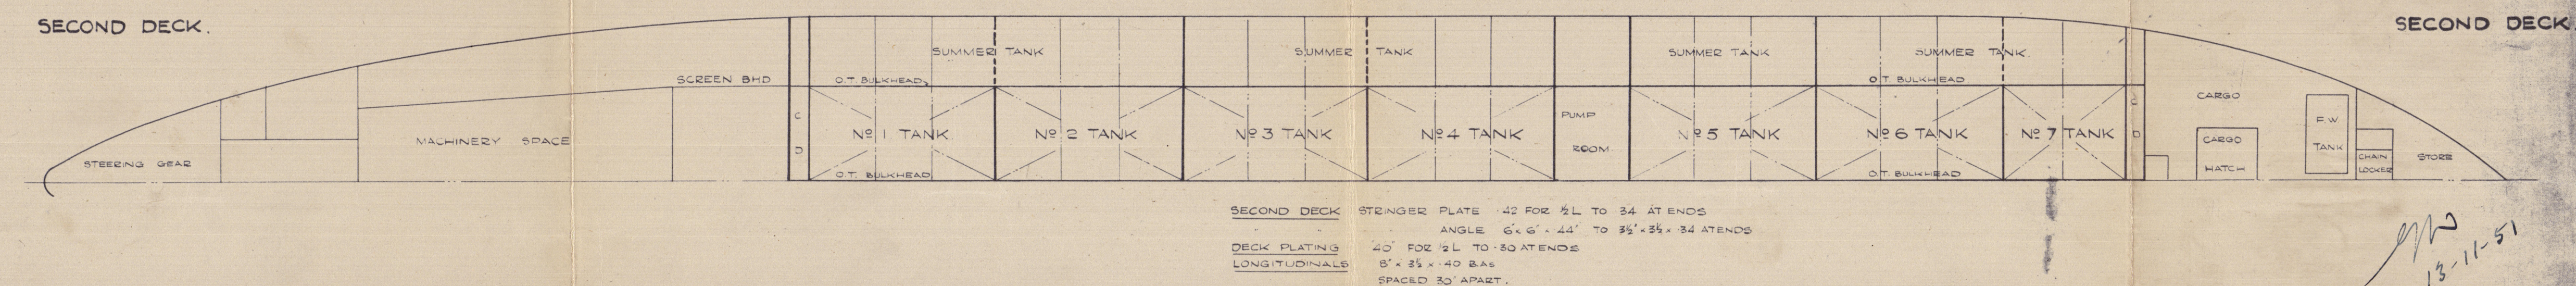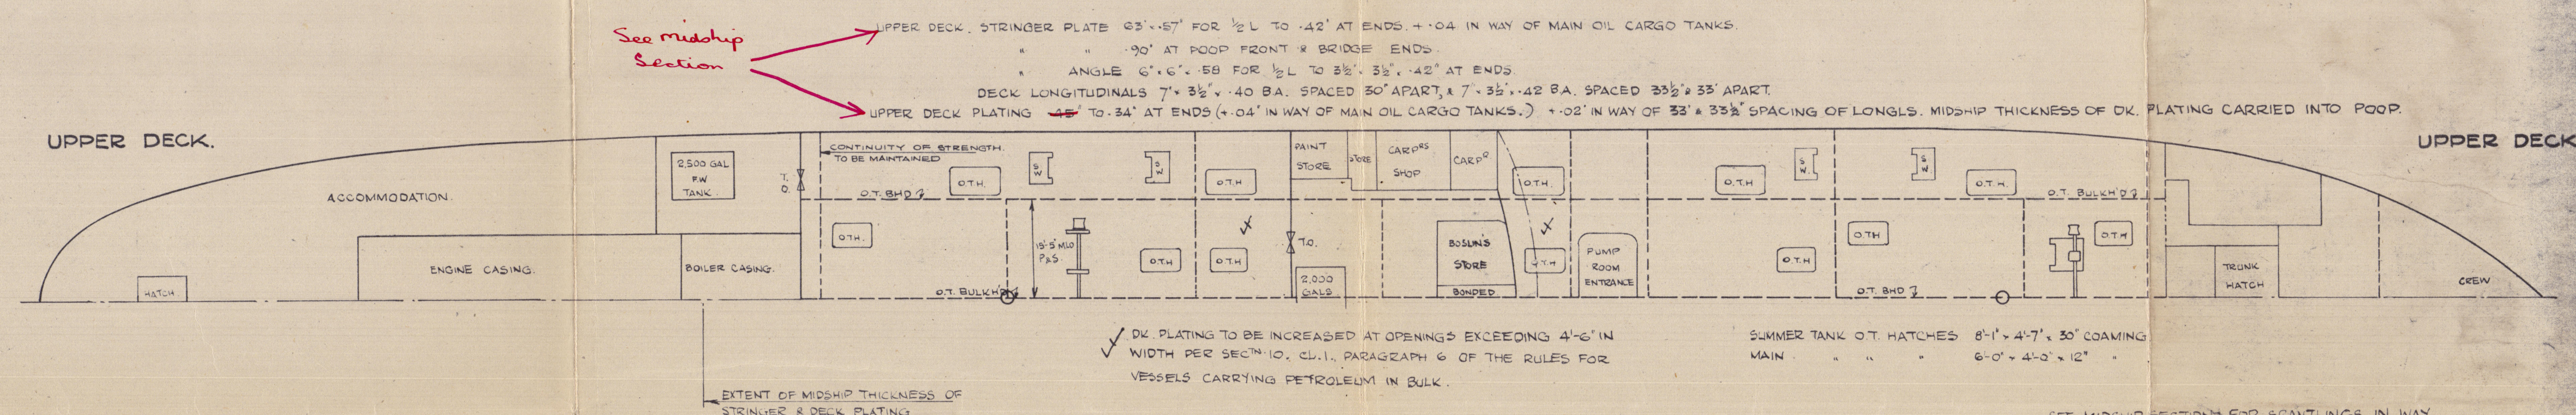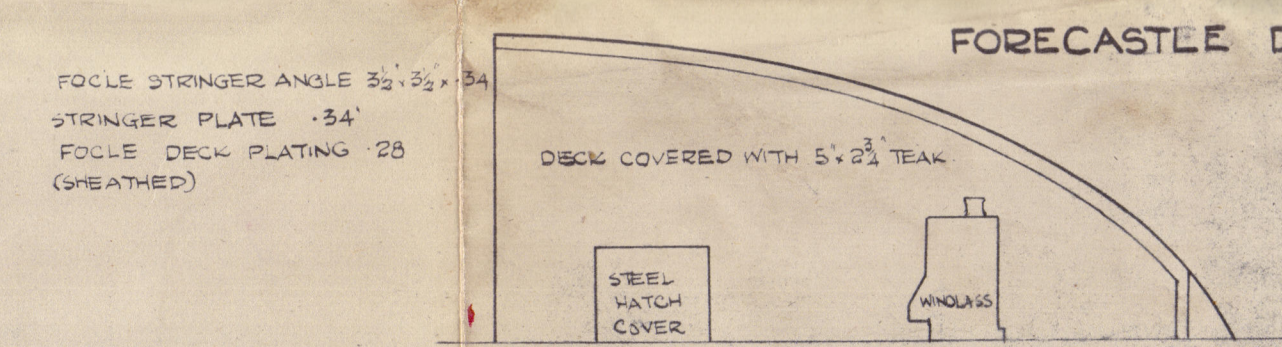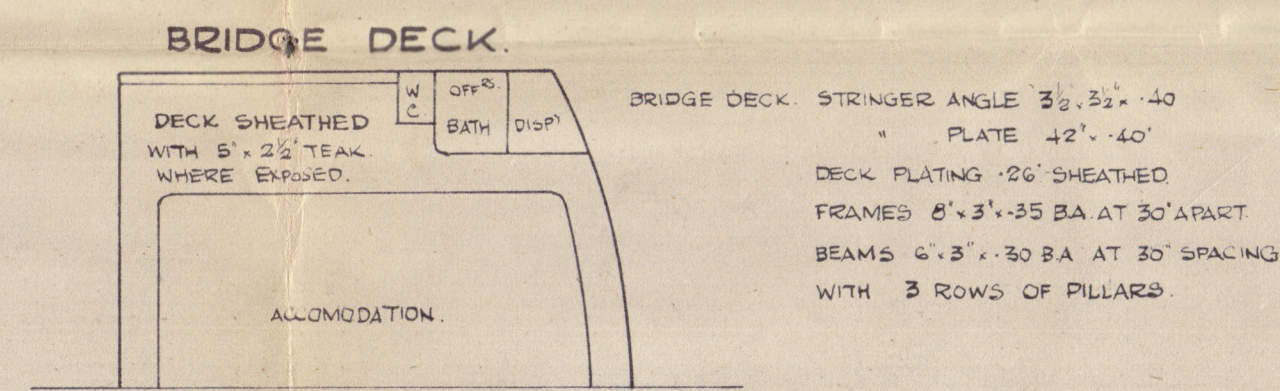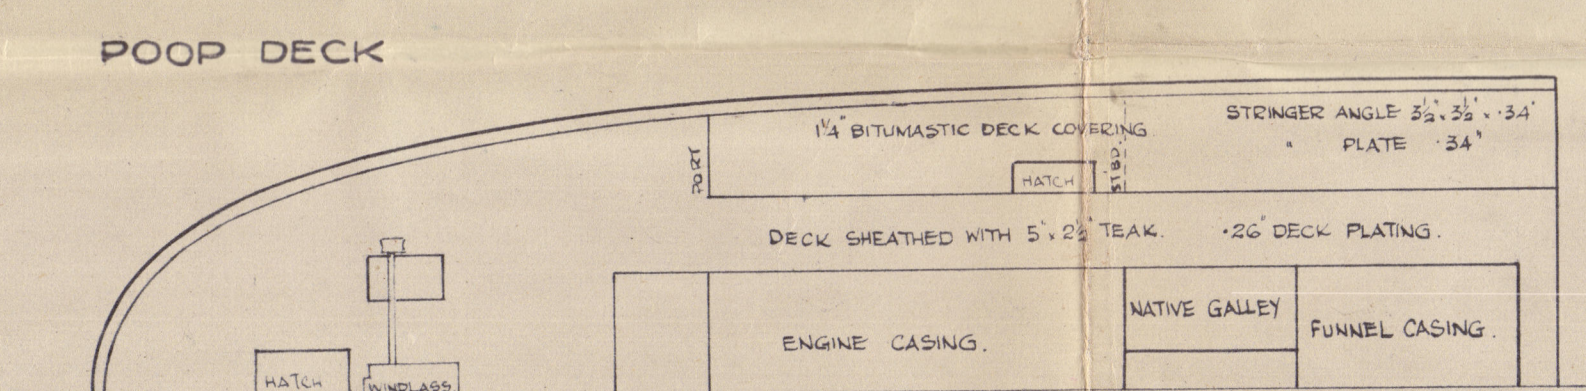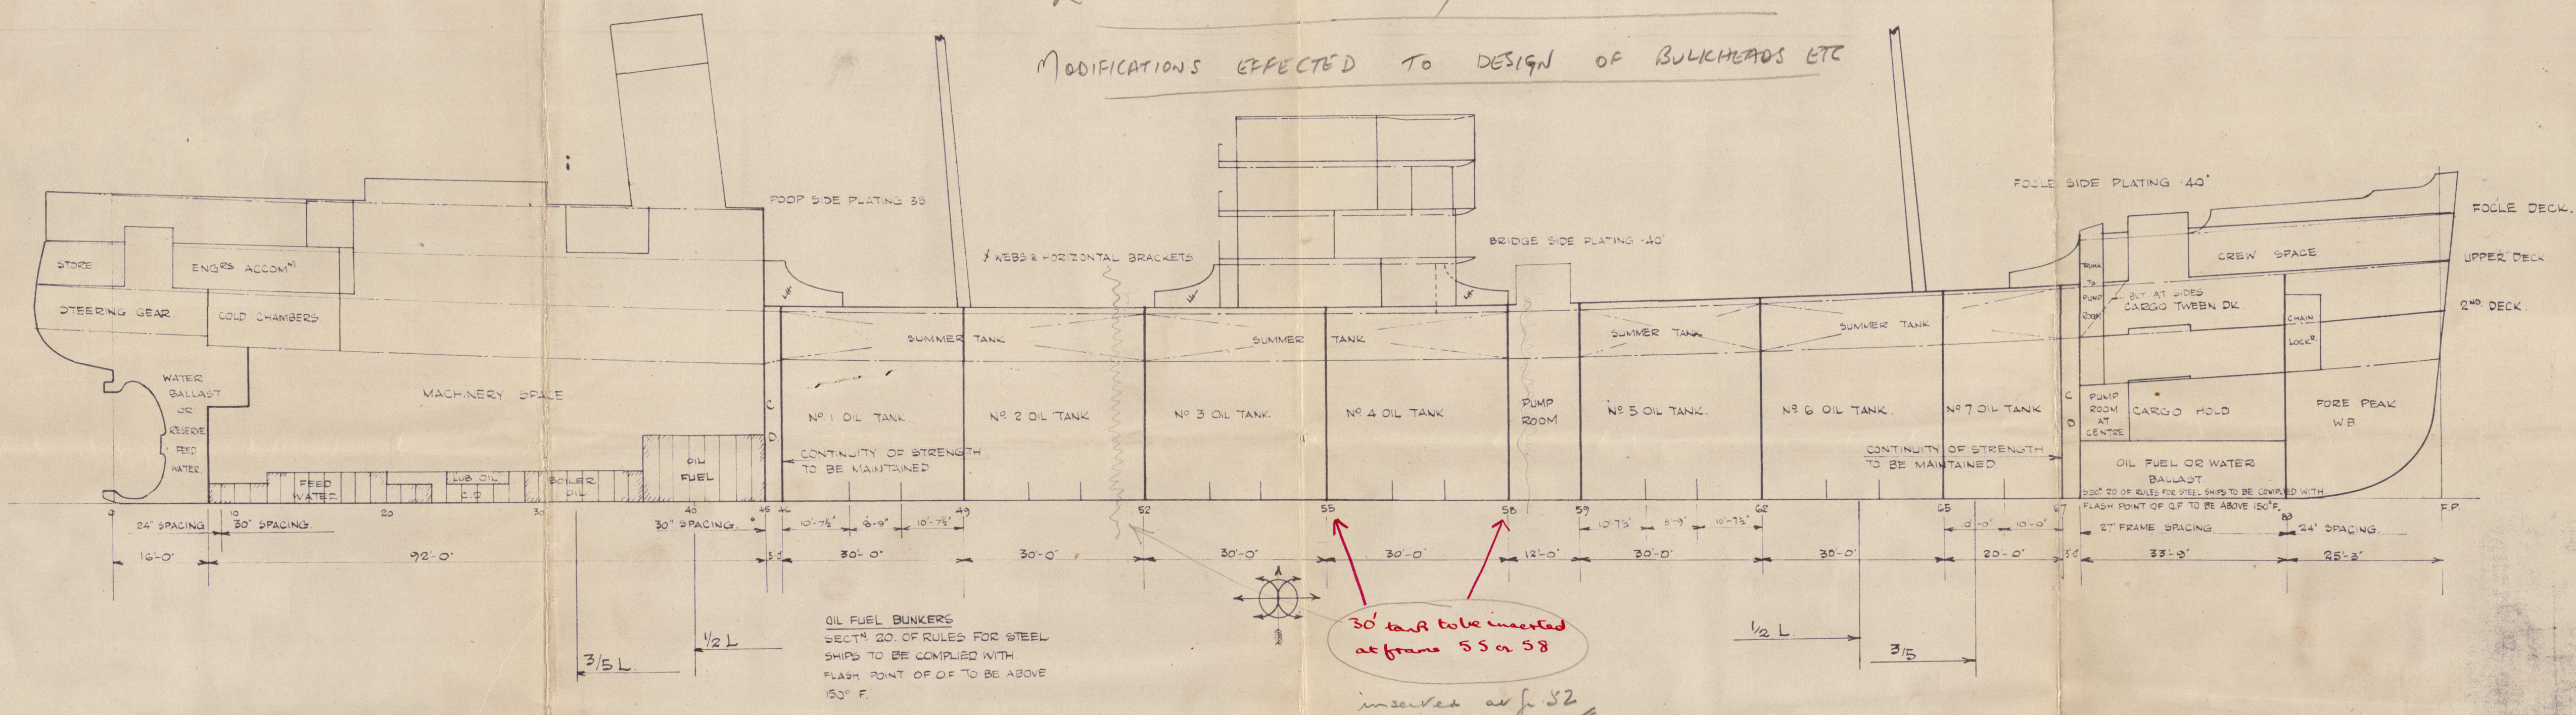



"YENANG YOUNG" 

PROFILE & DECKS (as built)

NEWCASTLE REPORT N°

NEWCASTLE-ON-TYNE, No. 111223

RETAIN

RECORDS DEPT:  
LONDON

2



© 2020

Lloyd's Register  
Foundation

003937-003947-0198