

**Lloyd's Register of Shipping.**  
**SURVEYS FOR FREEBOARD.**  
 (COMPUTATION FOR STEAMER, SAILING SHIP, TANKER.)

Ship's Name <i>Marcella</i>	Official Number <i>1872</i>	Nationality and Port of Registry <i>Panama</i> <i>Panama City</i>	Gross Tonnage <i>3483</i>	Date of Build <i>1920</i>	Port of Survey <i>Genoa</i>
Moulded Dimensions: Length <i>328.5</i> Breadth <i>46.0</i> Depth <i>25.5</i>					Date of Survey <i>11 mo 1947</i>
Moulded displacement at moulded draught = 85 per cent. of moulded depth _____ tons					Surveyor's Signature <i>F. S. J. P. O. R.</i>
Coefficient of fineness for use with Tables <i>.78 (assumed)</i>					Particulars of Classification <i>. 100 A 7</i>

<b>DEPTH FOR FREEBOARD (D).</b> Moulded depth ... .. <i>25.50</i> Stringer plate ... .. <i>.03</i> Sheathing on exposed deck $T \left( \frac{L-S}{L} \right) =$ Depth for Freeboard (D) = <i>25.55</i>		<b>DEPTH CORRECTION.</b> (a) Where D is greater than Table depth (D - Table depth) R = <i>(25.55 - 21.90) 2.527 = + 9.22</i> (b) Where D is less than Table depth (if allowed) (Table depth - D) R = If restricted by superstructures		<b>ROUND OF BEAM CORRECTION.</b> Moulded Breadth (B) <i>46.0</i> Standard Round of Beam = $\frac{B \times 12}{50} =$ <i>11.04</i> Ship's Round of Beam Difference <i>11.50</i> Restricted to Correction = $\frac{\text{Diff}^*}{4} \times \left( 1 - \frac{S}{L} \right) =$ <i>- .05</i>	
---	--	---	--	--	--

## DEDUCTION FOR SUPERSTRUCTURES.

	Mean Covered Length (S)	Equivalent Enclosed Length (S)	Height	Height Correction	Effective Length (E)
Poop enclosed ... ..	42.50	42.50	7.50	-	42.50
" overhang ... ..					
R.Q.D. enclosed ... ..					
" overhang ... ..					
Bridge enclosed ... ..	94.00	94.00	7.50	-	94.00
" overhang aft ... ..					
" overhang forward ... ..					
Feble enclosed <del>0 ft</del> (ca 4 ft)	36.50	32.76	7.50	-	32.76
" overhang ... ..					
Trunk aft ... ..					
" forward ... ..					
Tonnage opening aft ... ..					
" forward ... ..					
Total ... ..	173.00	164.26			164.26

URES.

Standard Height of Superstructure

" " R.Q.D. 6785

Deduction for complete superstructure 37.23

Percentage covered  $\frac{S}{L} = 52.66$

" "  $\frac{S}{L} = 51.53$

" "  $\frac{E}{L} = 51.53$

Percentage from Table, Line A.  
(corrected for absence of forecaste (if required))

Percentage from Table, Line B. 37.53  
(corrected for absence of forecaste (if required))

Interpolation for bridge less than .2L (if required)

Deduction =  $37.23 + 37.53 \times 13.97$

**SHEER CORRECTION.**

Station	Standard Ordinate	S M	Product	Actual Ordinate	Effective Ordinate	S M	Product
A.P. ...	42.95	1	42.95	30.0	30.00	1	30.00
½ L from A.P. ...	19.06	4	76.24	8.0	8.00	4	32.00
¾ L " ...	4.71	2	9.42	—	—	2	—
Amidships ...	—	4	—	—	—	4	—
¾ L from F.P. ...	9.42	2	18.84	12.0	12.00	2	24.00
½ L " ...	38.12	4	152.48	35.5	35.50	4	142.00
F.P. ...	85.70	1	85.70	73.5	73.50	1	73.50
Total ...			365.53				301.50

Mean actual sheer aft =  $\frac{85.70}{38.17} = 2.246$

Mean standard sheer aft =  $\frac{73.5}{35.5} = 2.070$

Mean actual sheer forward =  $\frac{85.70}{38.17} = 2.246$

Mean standard sheer forward =  $\frac{73.5}{35.5} = 2.070$

$$\frac{\text{Length of enclosed superstructure}}{L} \text{ forward of amidships} =$$

aft of

$$\text{Correction} = \frac{\text{Difference between sums of products}}{18} \left( \frac{.75 - .8}{21} \right) = \frac{24.03}{18} (.75 - .7633) = +2.27$$

If limited on account of midship superstructure. If limited to maximum allowance of 1½ ins. per 100 ft.


<p>If limited on account of midship superstructure.</p> <p><b>Deduction for Tropical Freeboard.</b></p> <p><b>Addition for Winter and Winter North Atlantic Freeboard.</b></p> <p>Depth to Freeboard Deck = <math>\frac{\text{Ft.}}{25.53}</math></p> <p>Summer freeboard = <math>\frac{\text{Ft.}}{4.27}</math></p> <p>Moulded draught (d) = <math>\frac{\text{Ft.}}{21.26}</math></p> <p><b>Deduction for Tropical freeboard and addition for Winter freeboard = <math>\frac{\text{d}}{4}</math> inches = 5.4</b></p> <p><b>Addition for Winter North Atlantic Freeboard (if required) = 7.4</b></p>		<p><b>Deduction for Fresh Water.</b></p> <p>Displacement in salt water at summer load water line</p> <p><math>\Delta =</math></p> <p>Tons per inch immersion at summer load water line</p> <p>T =</p> <p><b>Deduction = <math>\frac{\Delta}{40 \text{ T}}</math> inches =</b></p>		<p><b>TABULAR FREEBOARD</b> corrected for Flush Deck (if required)</p> <p>Correction for coefficient <math>\frac{70 + .66}{1.36}</math></p> <table border="1" style="width: 100%; border-collapse: collapse;"> <thead> <tr> <th></th> <th style="width: 10%; text-align: center;">+</th> <th style="width: 10%; text-align: center;">-</th> </tr> </thead> <tbody> <tr> <td>Depth Correction ... ..</td> <td style="text-align: center;">9.22</td> <td style="text-align: center;">-</td> </tr> <tr> <td>Deduction for superstructures ... ..</td> <td style="text-align: center;">-</td> <td style="text-align: center;">13.97</td> </tr> <tr> <td>Sheer correction ... ..</td> <td style="text-align: center;">2.27</td> <td style="text-align: center;">-</td> </tr> <tr> <td>Round of Beam correction ... ..</td> <td style="text-align: center;">-</td> <td style="text-align: center;">.05</td> </tr> <tr> <td>Correction for Thickness of Deck amidships ... ..</td> <td style="text-align: center;">-</td> <td style="text-align: center;">.19</td> </tr> <tr> <td>Other corrections, scantlings, etc. to envelope</td> <td style="text-align: center;">-</td> <td style="text-align: center;">.42</td> </tr> <tr> <td><b>Inter-fld. previously added</b></td> <td style="text-align: center;"><b>11.44</b></td> <td style="text-align: center;"><b>14.63</b></td> </tr> <tr> <td><b>Summer Freeboard = 51.20</b></td> <td></td> <td></td> </tr>

**SUMMER FREEBOARD** amidships from Centre of Disc to top of Deck Line, ~~Wood~~, Steel, Deck :—

Tropical Fresh Water Line above Centre of Disc	...	...	11"	Tropical Fresh Water Freeboard	...	...	3'-4 1/2"
Fresh Water Line	"	"	5 3/4"	Fresh Water	"	"	3'-4 1/2"
Tropical Line	"	"	5 1/2"	Tropical	"	"	3'-10"
Winter Line	"	"	5 1/2"	Winter	"	"	4'-8 1/2"
Winter North Atlantic Line	"	"	7 1/4"	Winter North Atlantic	"	"	4'-10 1/2"



A new form should be prepared if any alterations that affect the freeboard have been made. If no such alterations have been made, the Surveyor should endorse the form on this side with his signature and the date.

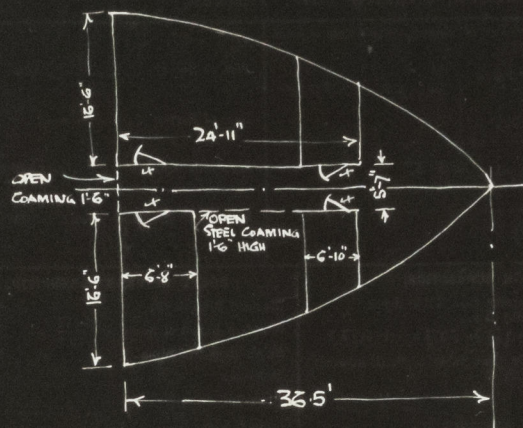

Freeboard treated as open because  
surveyor is unable to report details of  
done marked x

$$32.85 \times .942 = 30.94$$

$$3.65 \times .50 = 1.82$$

$$32.76$$

FORECASTLE

Trade of ship \_\_\_\_\_

Names of sister ships \_\_\_\_\_

Builder's name and yard number \_\_\_\_\_

Owners Cia Panamena Marittima San Gerassimo I.A

Fee £ 28 : 0 : 0 d. } PAYABLE IN LONDON  
Exp. £ 1 : 16 : 0 d. } (20. 10. 1944)  
 } (20/1/48)



© 2021

Lloyd's Register  
Foundation