

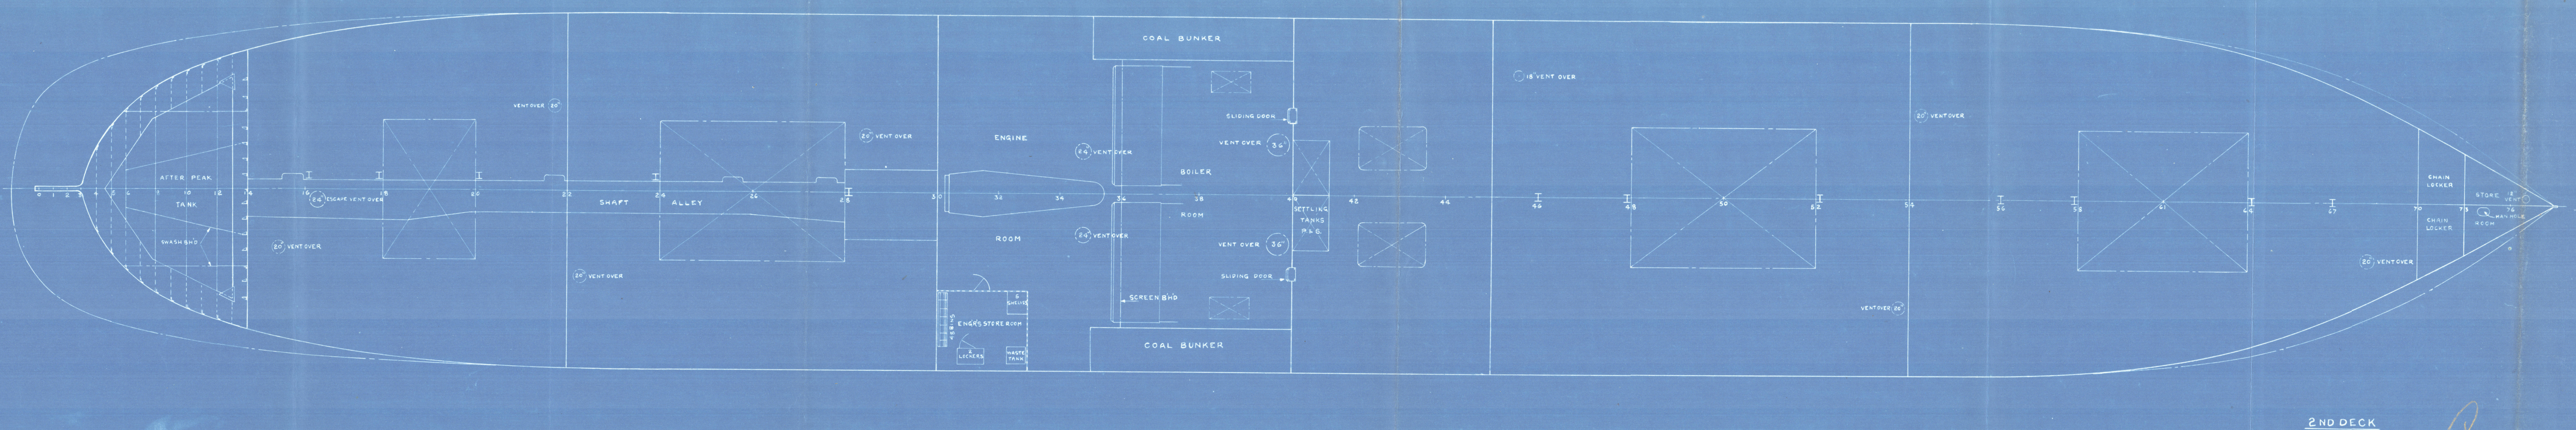
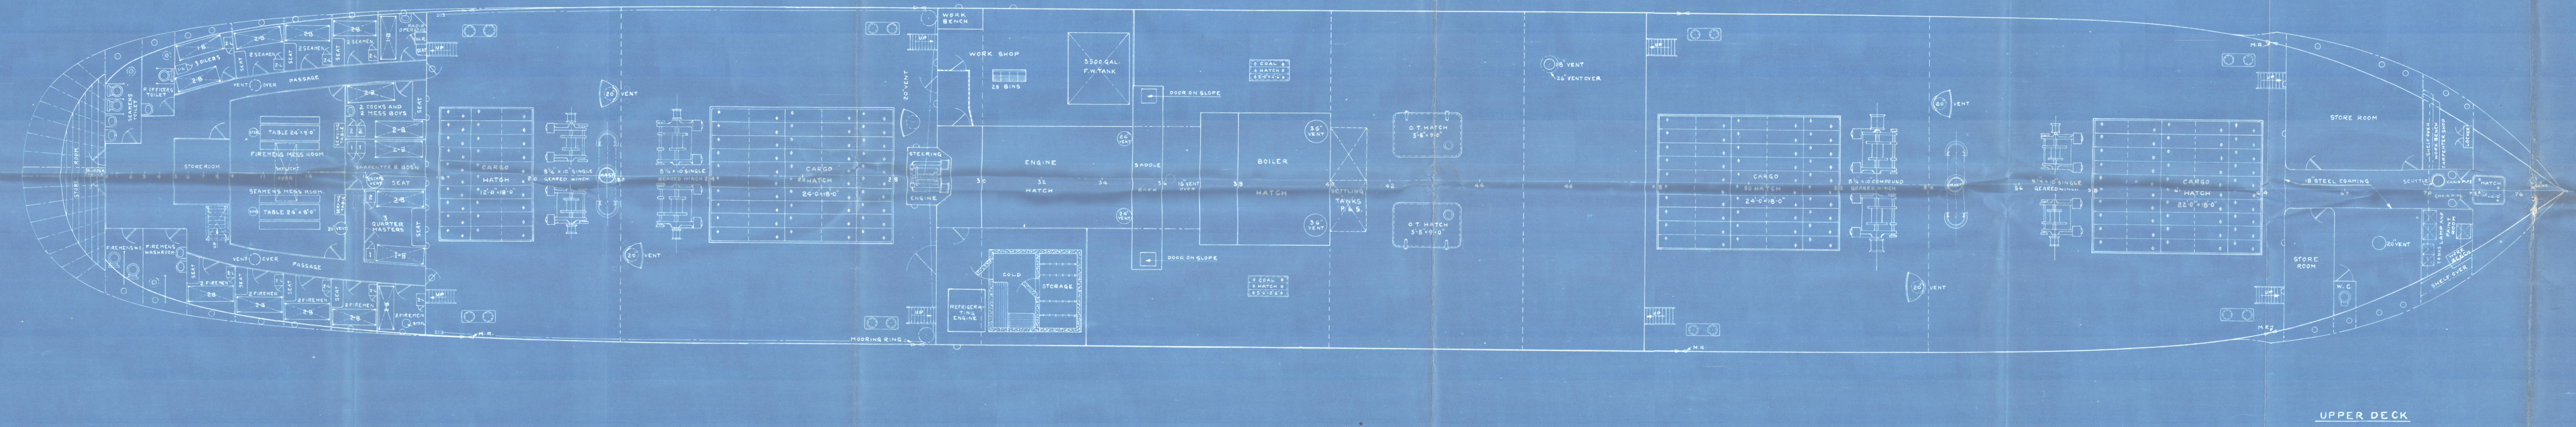


21" CLOSED CHUCK 53" 7/8" ADDED BETWEEN PROCS. 6904
FOR CASTLE OR FOR HULLS 3466 & 47 HARLAN PLANT AND 1911
248 & 49 HULLS. ONLY AS REQUESTED IN U.S. SHIPPING
BOARDS LETTER 3463-220 DATED DEC. 11, 1911.

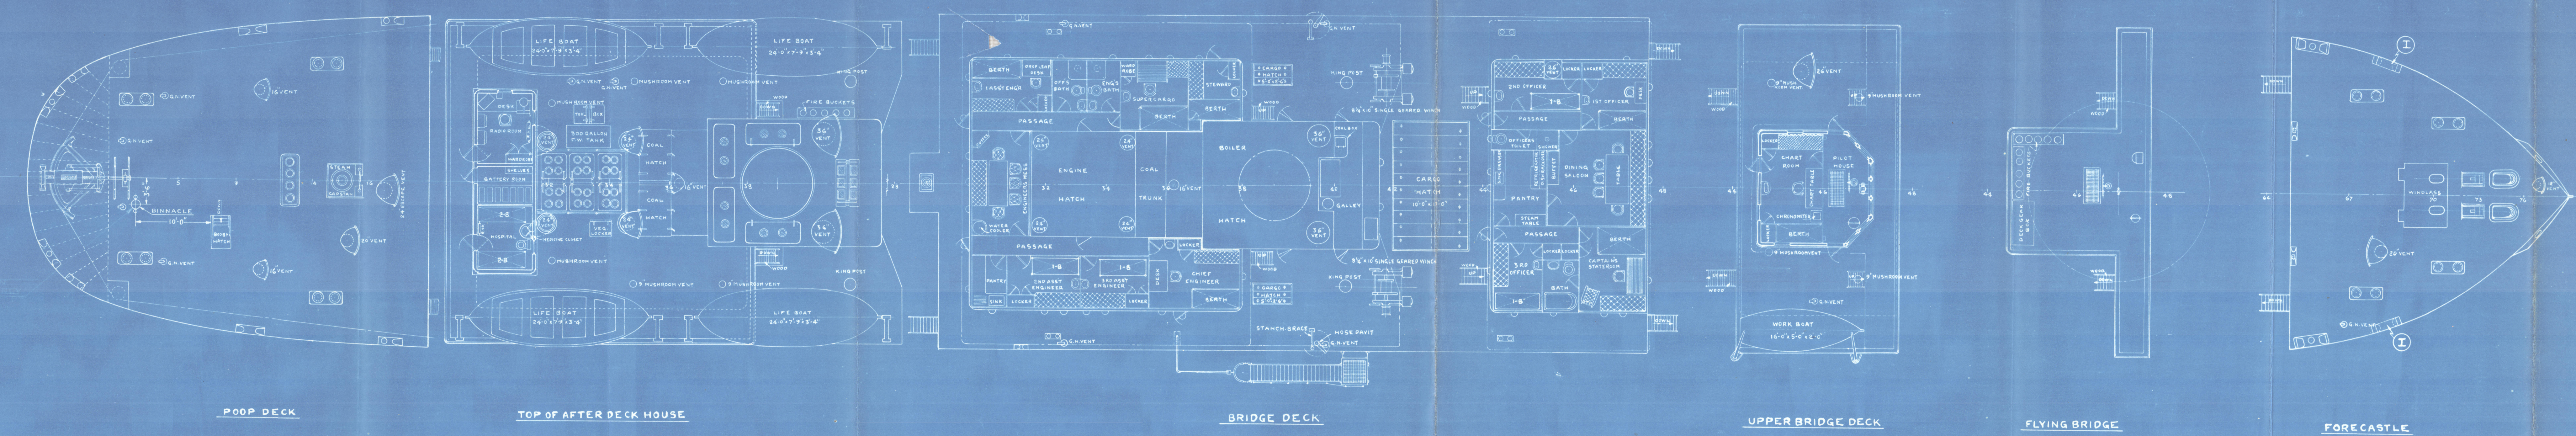

NOTE:
TRACED FROM PLAN WITH SAME NUMBER, DATED 23-AG-16.

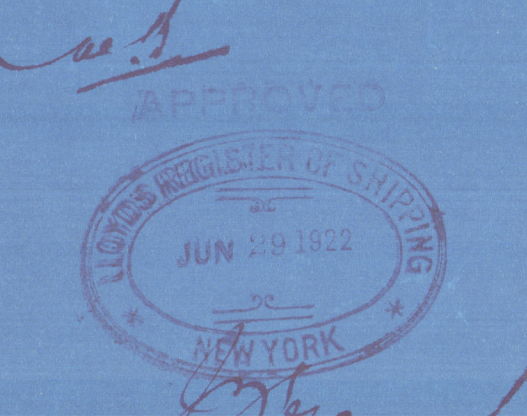

French Transferred to Harlan

DUPLICATE FOR H-3464 TO H-3469

H-3463-11-8A HARLAN PLANT
BETHLEHEM SHIPBUILDING CORP., LTD.
BETHLEHEM, PA.
GENERAL ARRANGEMENT
DECKS

SCALE 1/8" = FOOT
DRAWN 521
TRACED 521
CHECKED 42

DATE 12-AG-19
APPROVED *W. M. 3609*
APPROVED *W. M. 3609*