

# MIDSHIP SECTION

S. S. N° 294.

SCALE 1/2" = ONE FOOT

DIMENSIONS: 185'-0" x 28'-6" x 13'-0" MLD

## BRIDGE DECK


BEAMS 6" x 3" x 3/4"  
STRINGER BAR 3" x 3" x 26"  
WATERWAY BAR 3" x 3" x 36"  
STRINGER PLATE 31" x 26"  
TIE PLATES 7" x 26"  
SIDE PLATING 26"  
WOOD DECK 5" x 3" PITCH PINE.

## FORECASTLE DECK


BEAMS 6" x 3" x 3/4" B. ANGLE  
STRINGER BAR 3" x 3" x 26"  
WATERWAY BAR 3" x 3" x 36"  
STRINGER PLATE 17" x 26"  
PLATED IN WAY OF WINDLASS & WINCH 26"  
SIDE PLATING 26"  
WOOD DECK 5" x 3" PITCH PINE.

## SECTION IN WAY OF QUARTER DECK

## SECTION IN WAY OF UPPER DECK

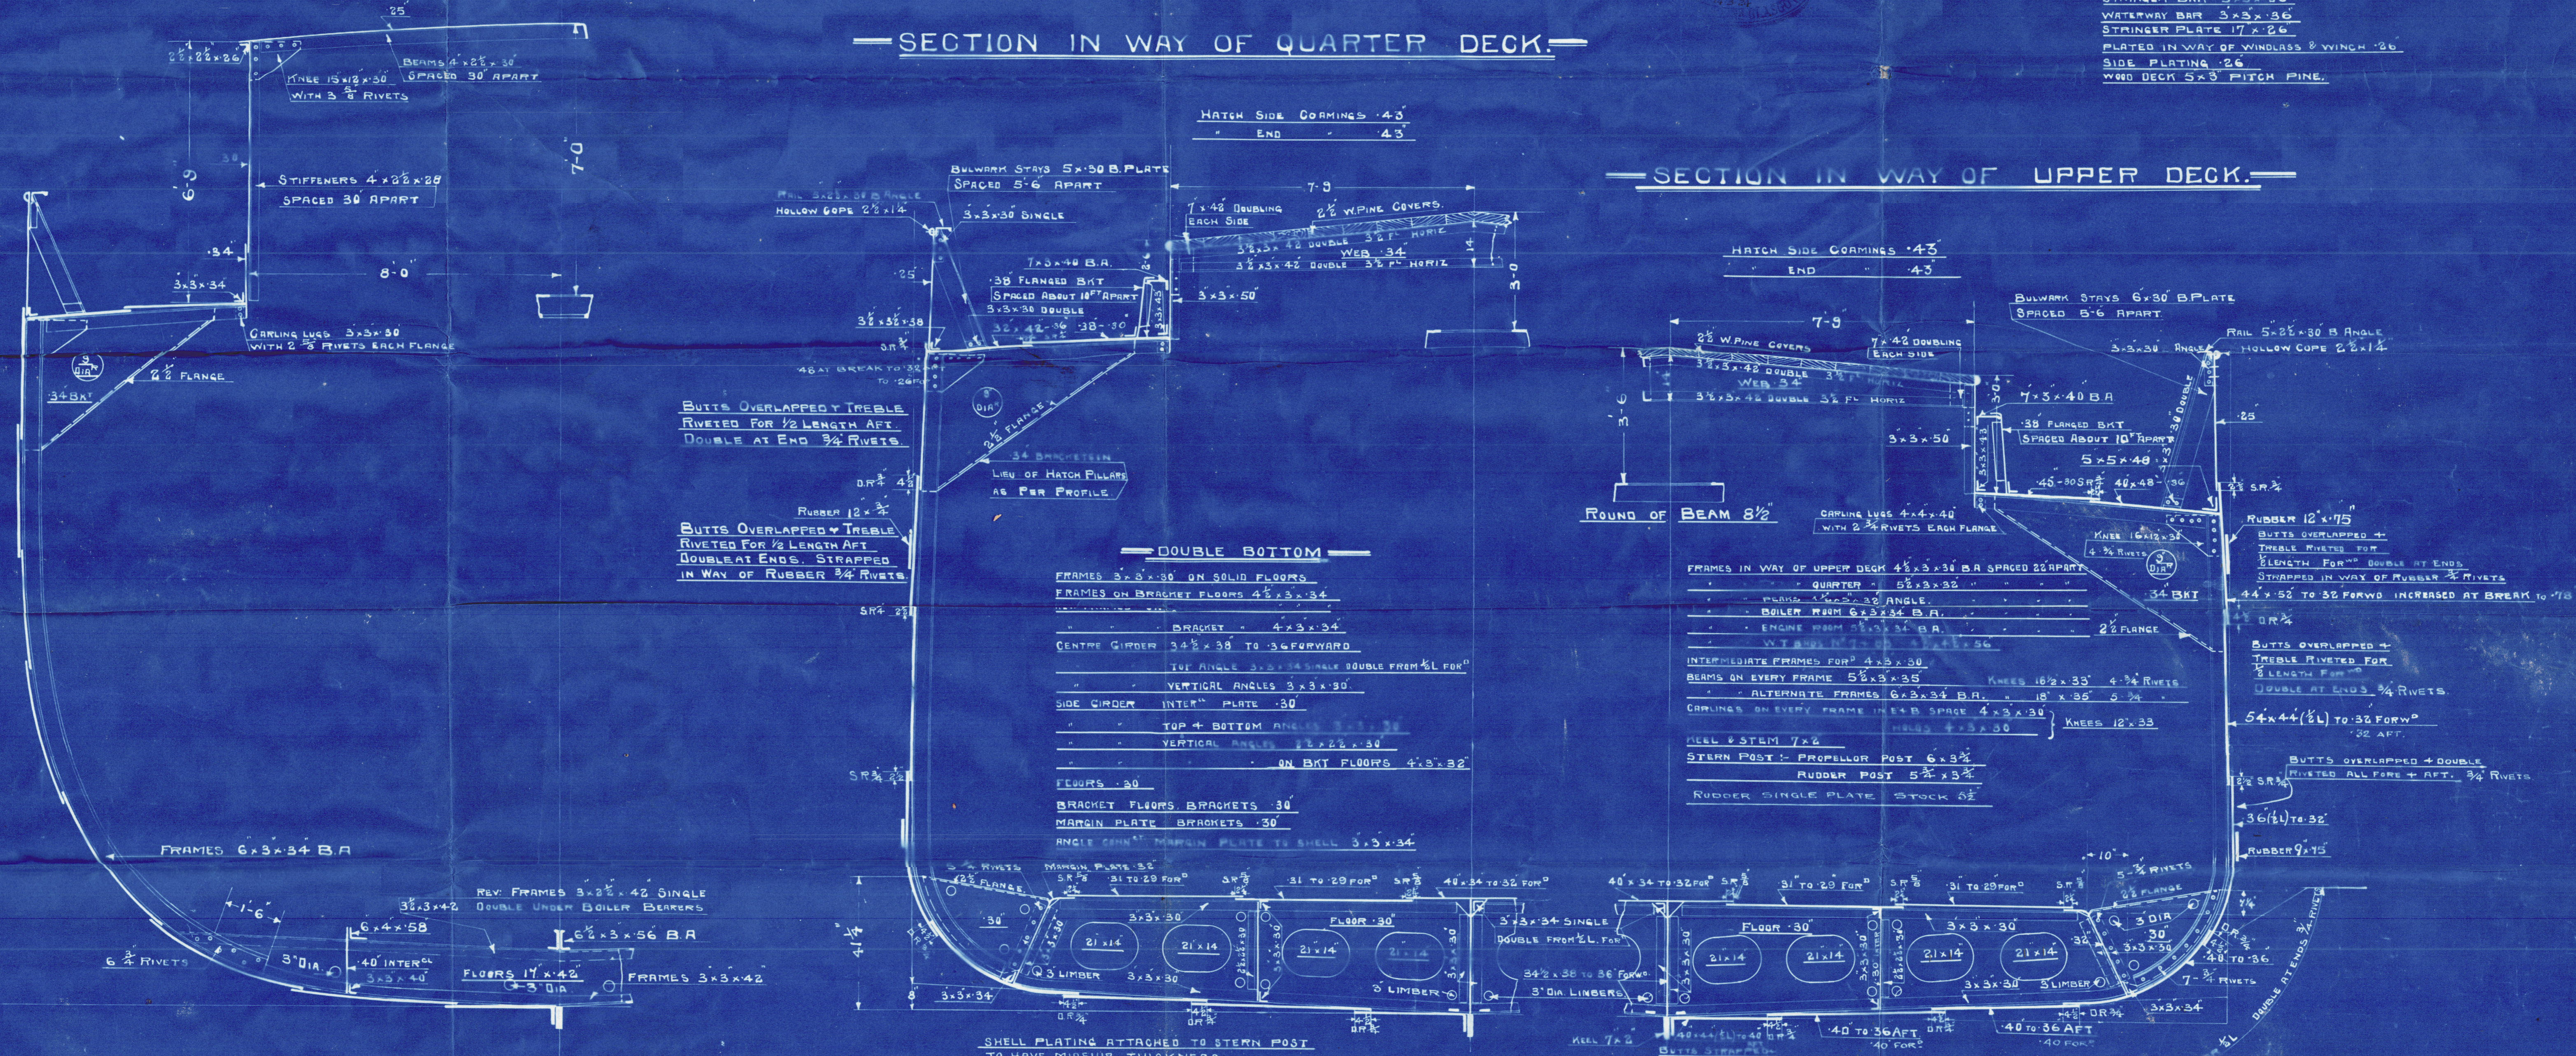

## SECTION IN WAY OF BOILER ROOM

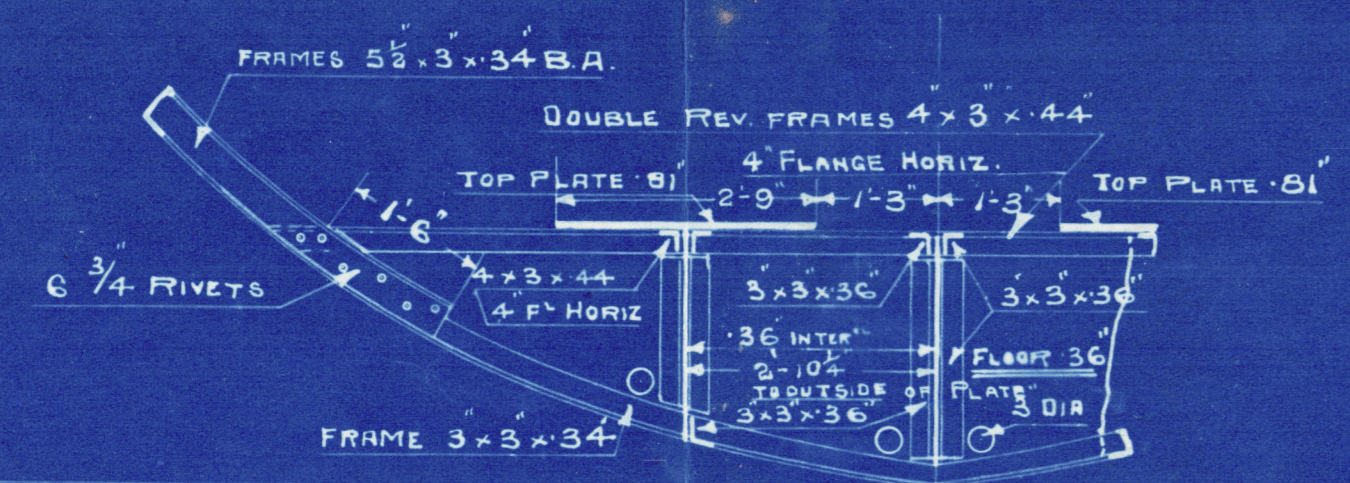

## SECTION IN WAY OF ENGINE FLOOR

## SECTION OF BRACKET FLOOR

## ON ALTERNATE FRAMES



S.S. 294-

50077X52

MIDSHIP SECTION

A.S. BUILT.

---

'Saint Kenneth'

---

Glasgow Rpt No 43597

---

M/S SEC

004024-004036-0078



© 2020

Lloyd's Register  
Foundation