
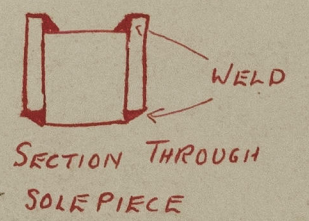
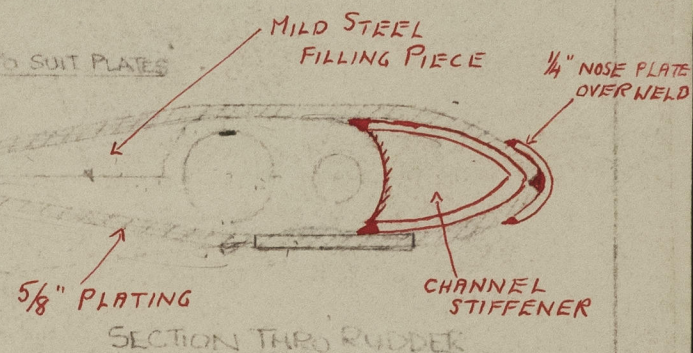


S.S. ST KENNETH

PROPOSED NEW RUDDER


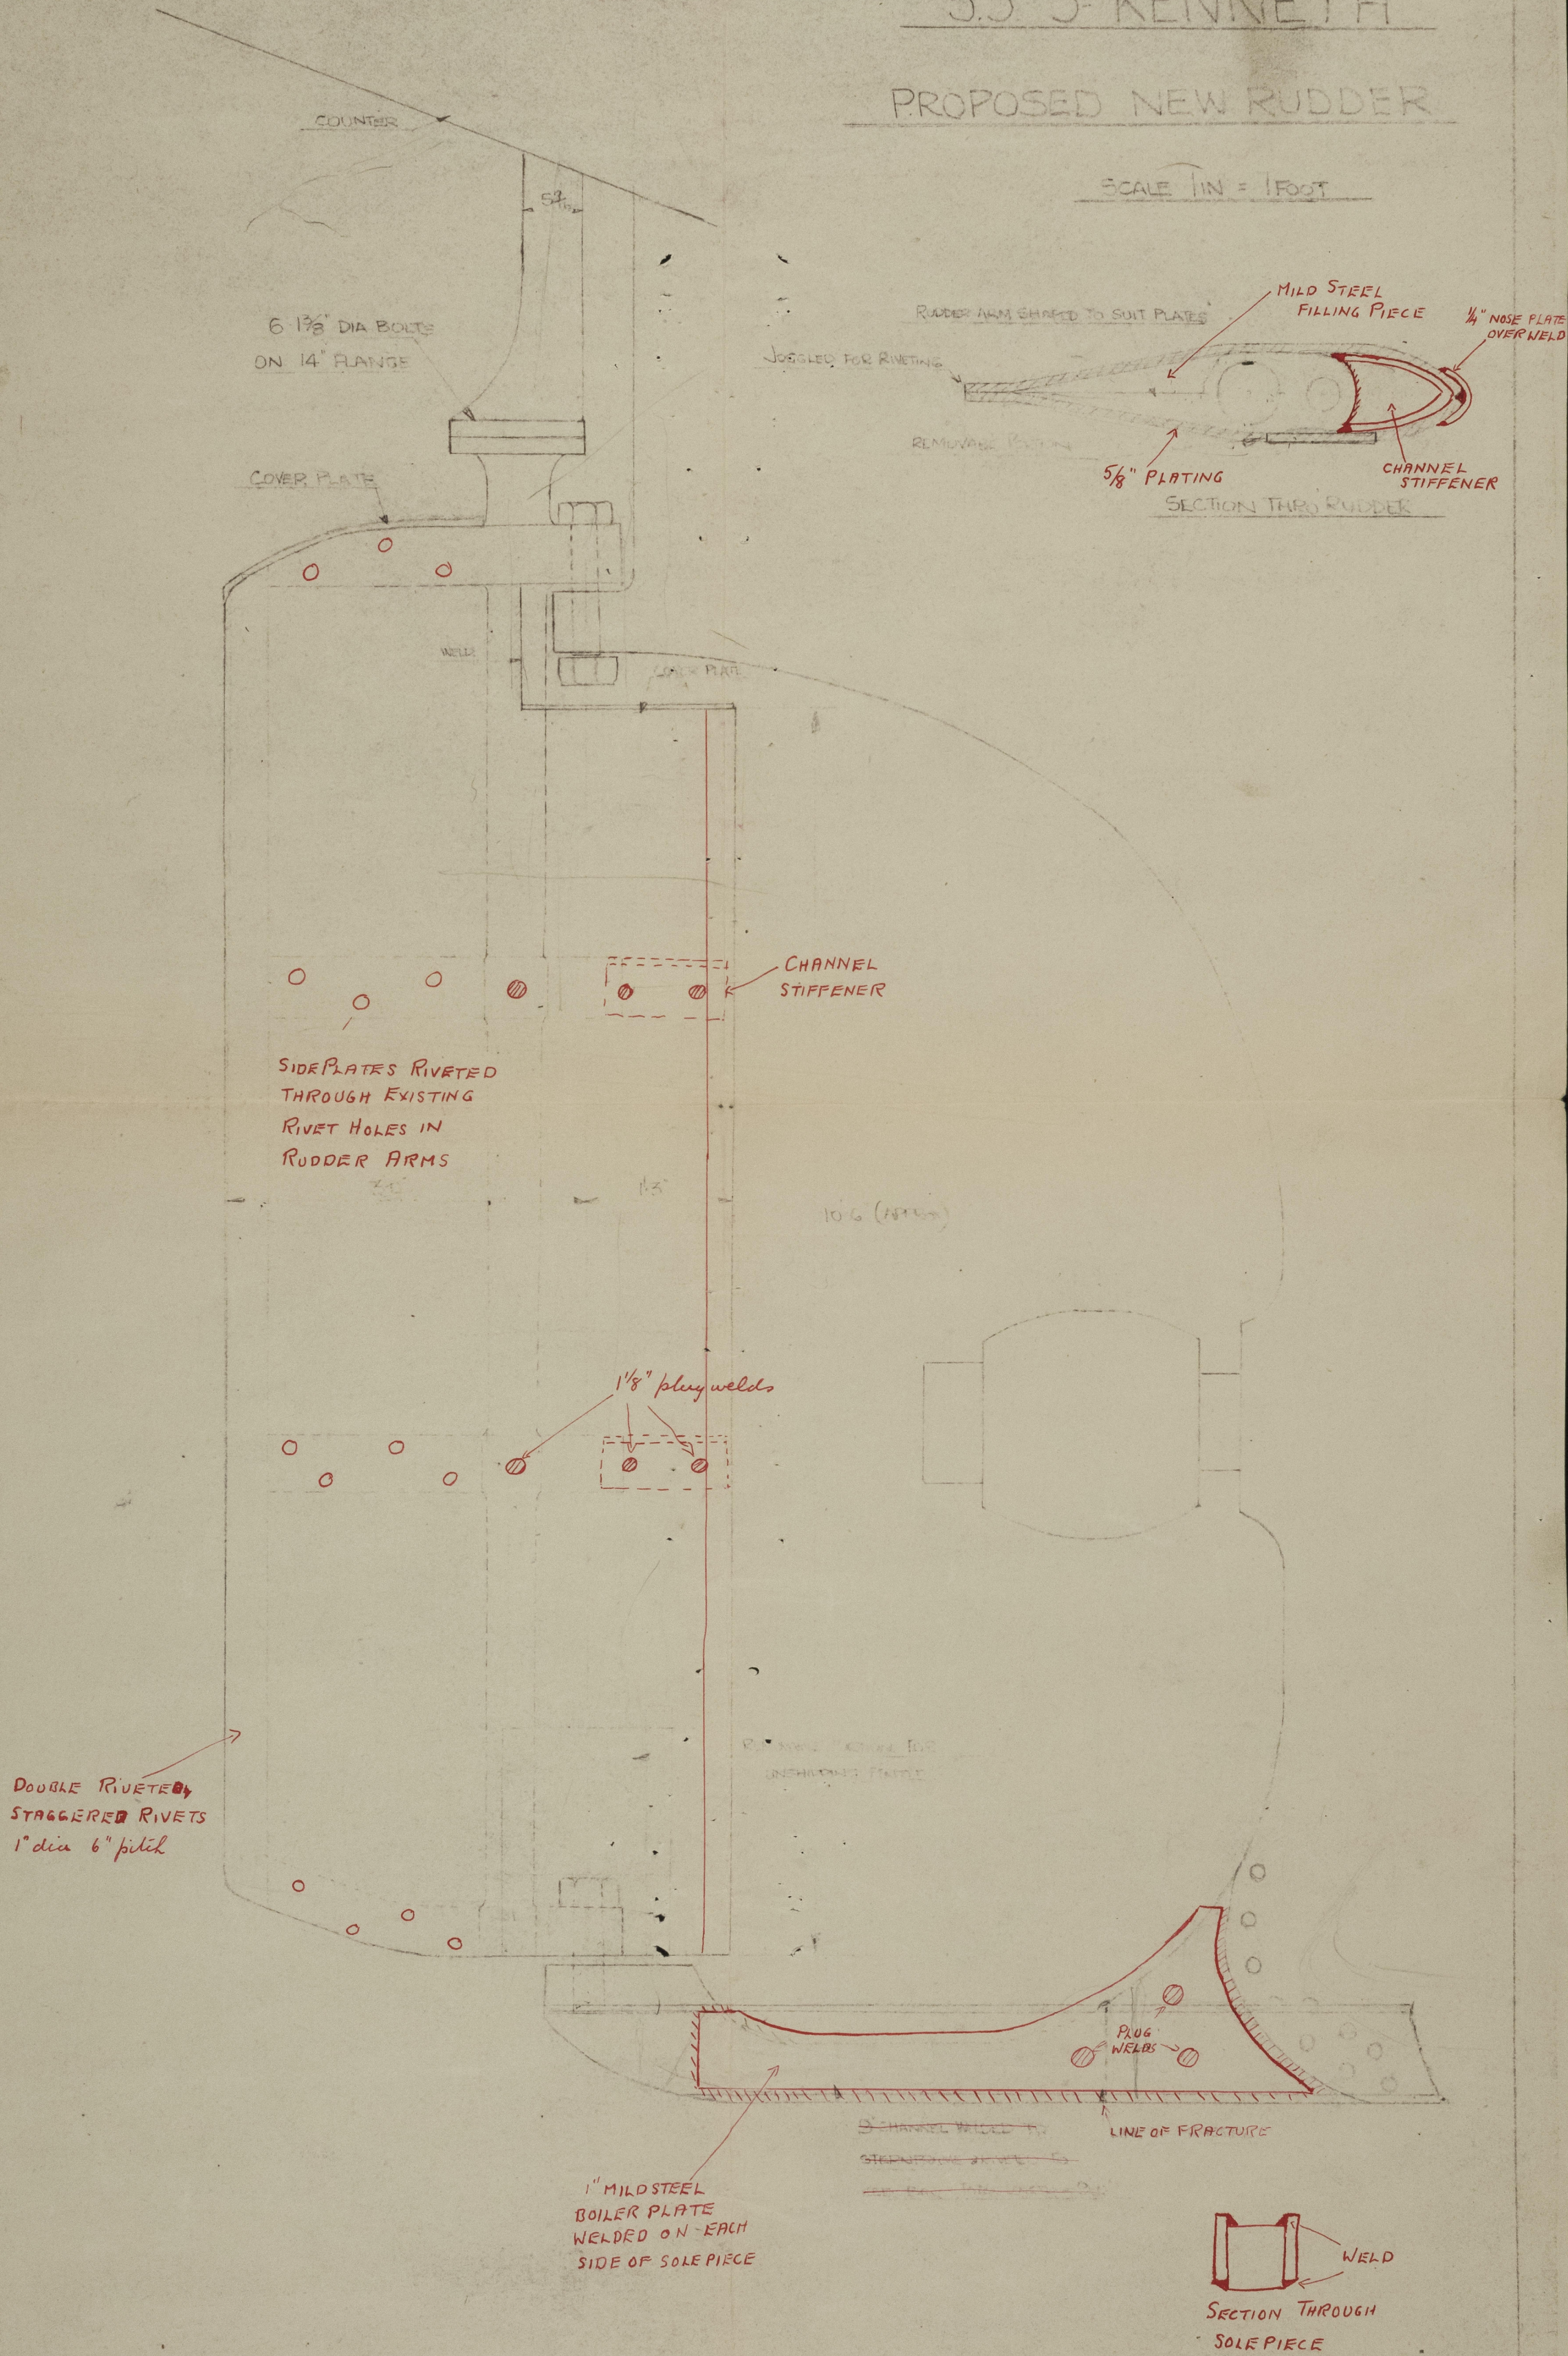

St. Kenneth

Bel. 12938.

004029-004036-0101



© 2020

Lloyd's Register
Foundation