

93

Gaspar Report 71046^A

Rpt. C. 11 (Contd.)

Index No.

Lloyd's Register of Shipping.

Ship's Name "SAINT KENNETH" Official No. 146145.


Memorandum of alterations reported since ship was surveyed for assignment of Load Lines in

FORECASTLE FRONT.

PLATING . 30"

STIFFENERS . 3 x 3 x .30 . SPACED NOT MORE THAN 30" APART.

ALL DOORS 4'6" x 1'10" OPENING. OPERATED FROM BOTH SIDES.

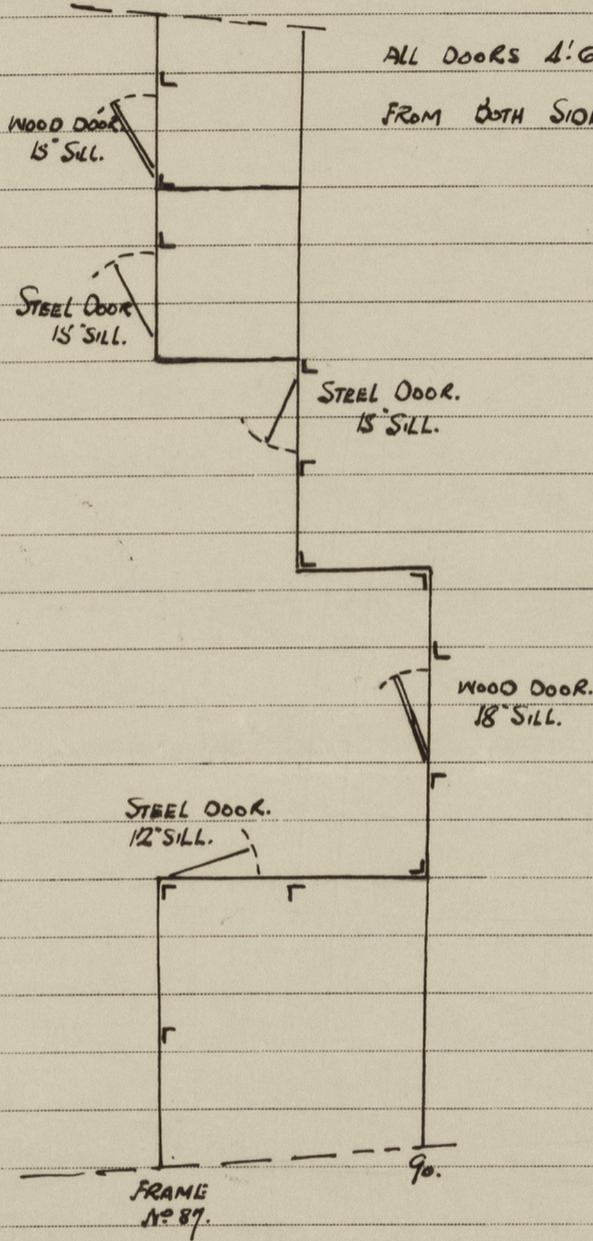

77L-10

004074-004036-0101

J. Perry
16.9.46.

Filed
J.B.D.
26 SEP 1946

Agreed with Mr. [unclear] new comp. not required as alteration very small.