

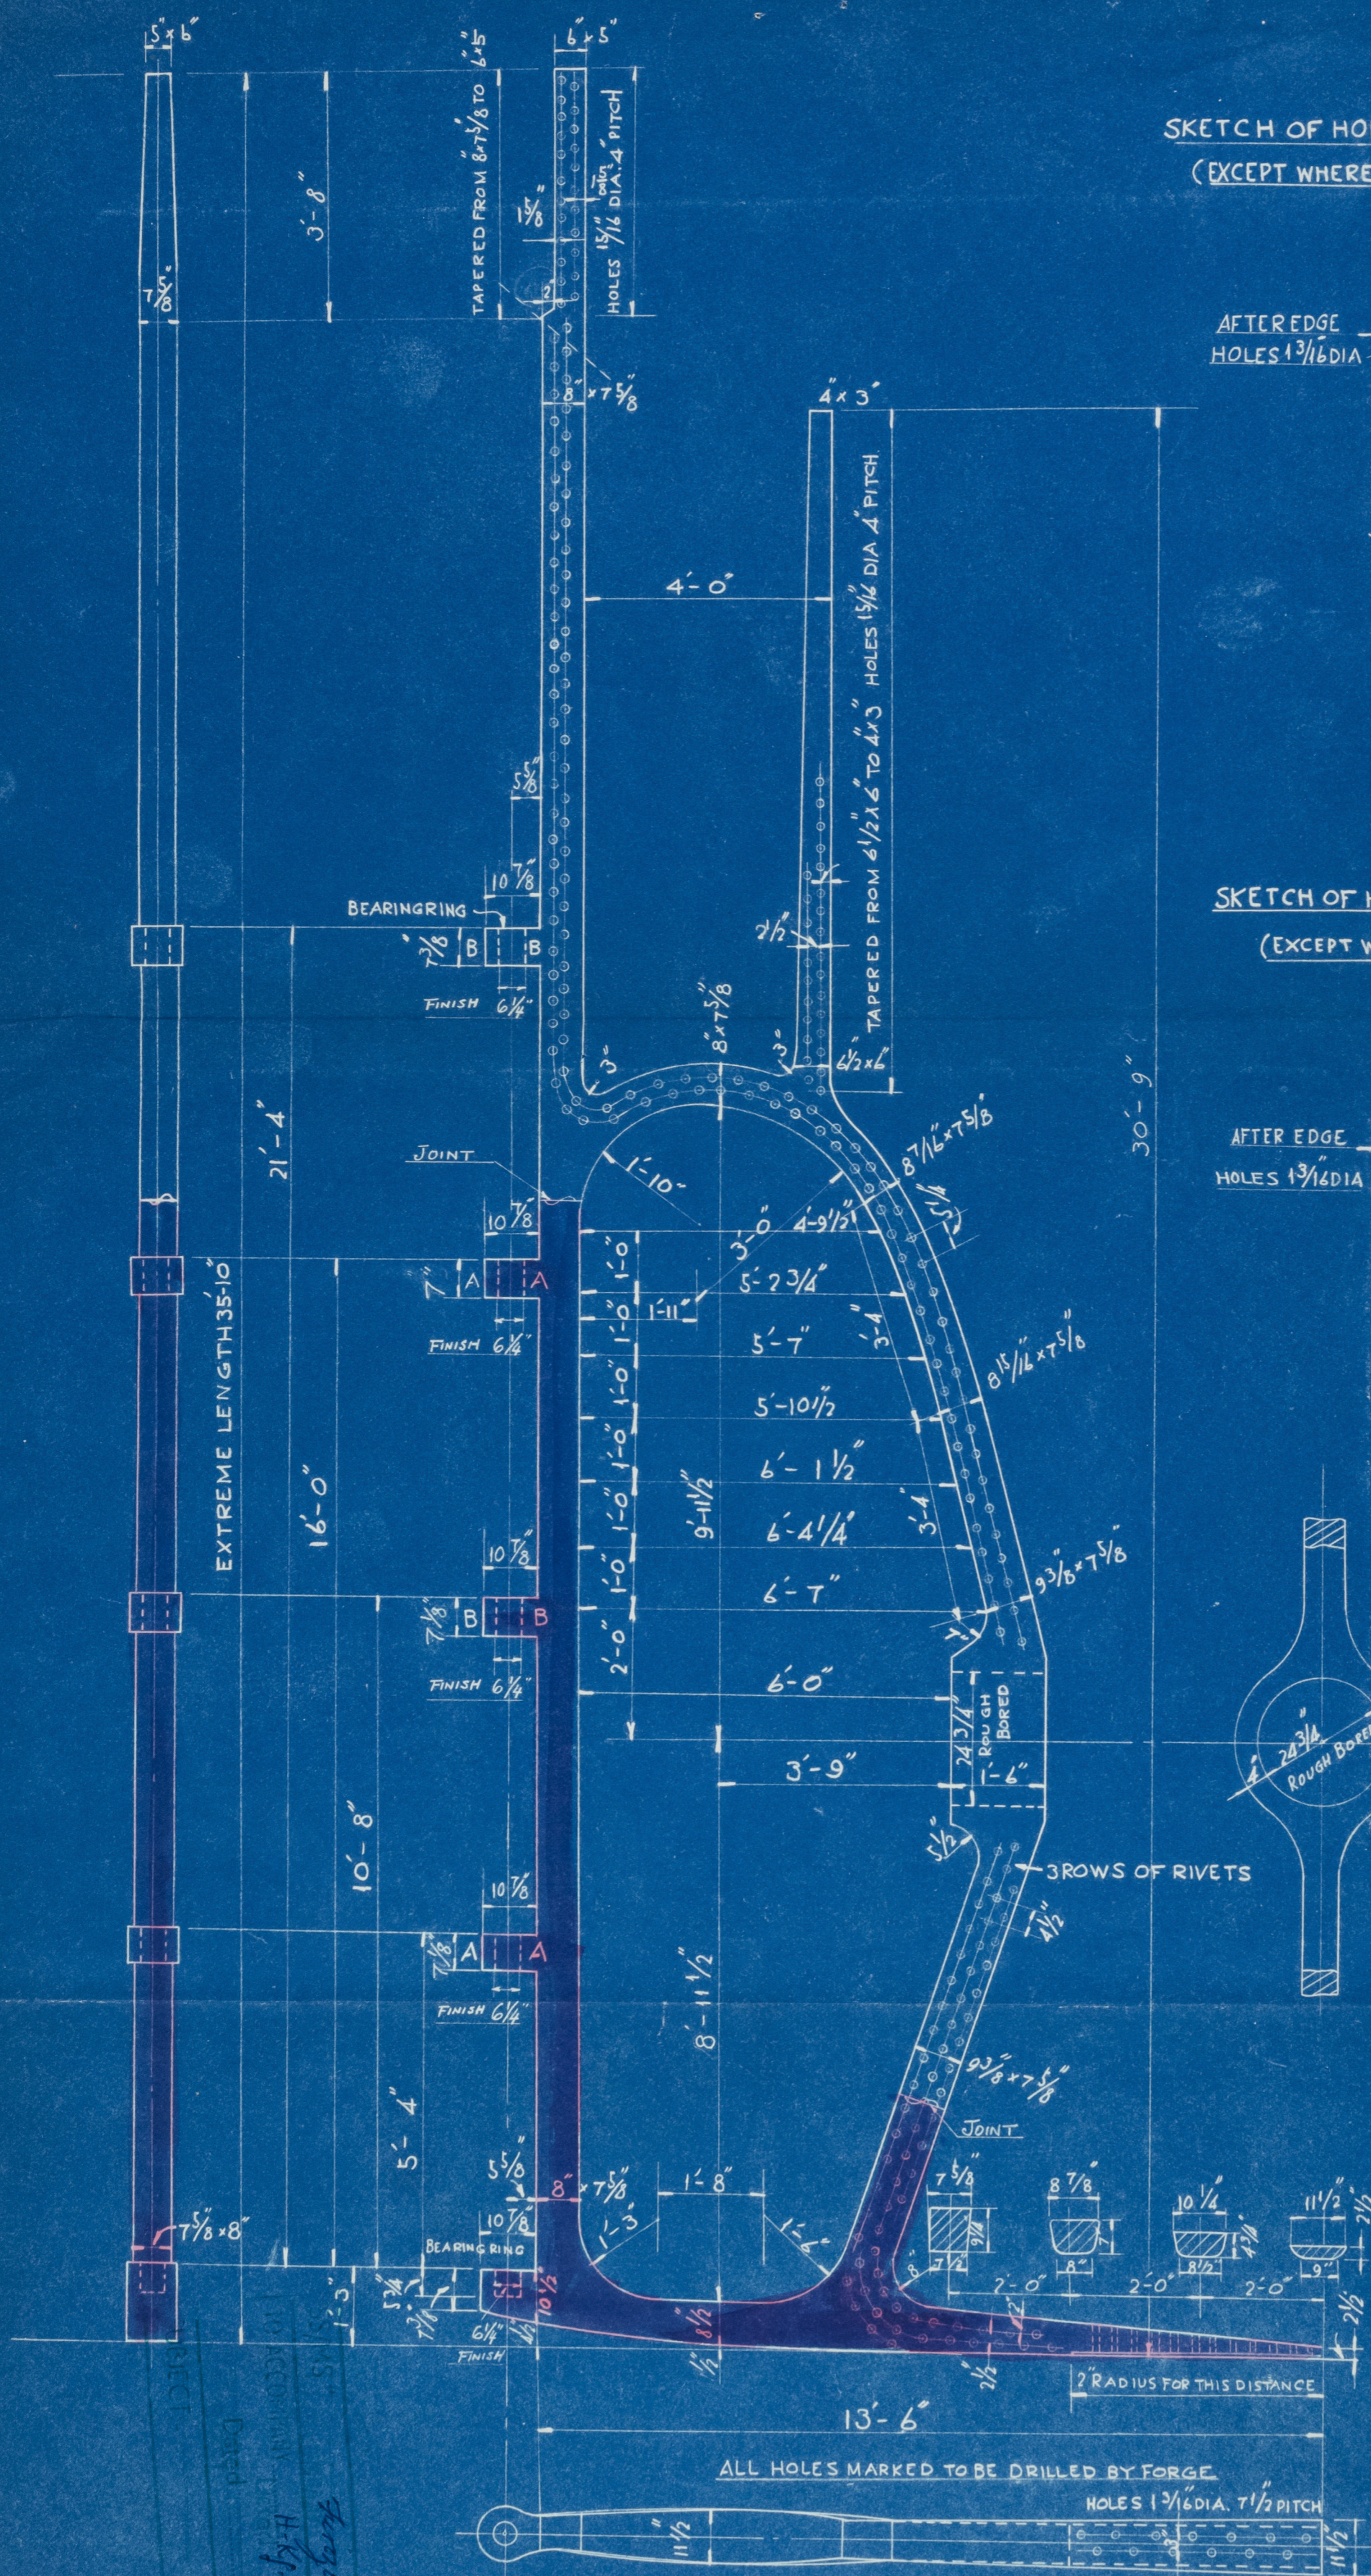




SCALE: $1/2" = 1 \text{ FOOT}$

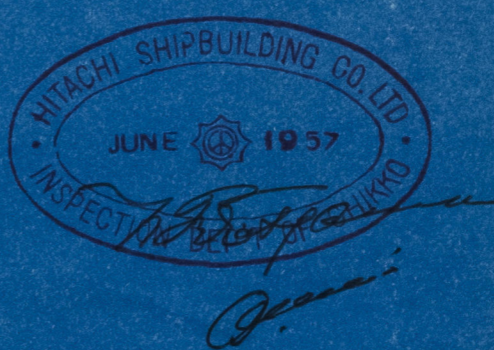

SKETCH OF HOLES ABOVE BOSS
(EXCEPT WHERE MARKED OTHERWISE)

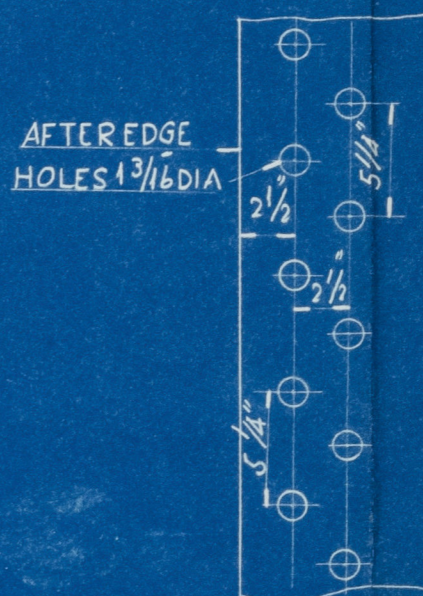

SKETCH OF HOLES BELOW BOSS
(EXCEPT WHERE MARKED OTHERWISE)

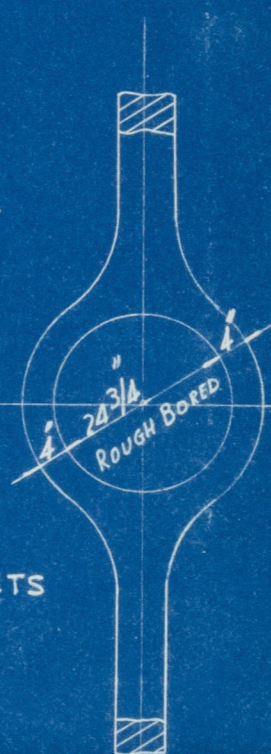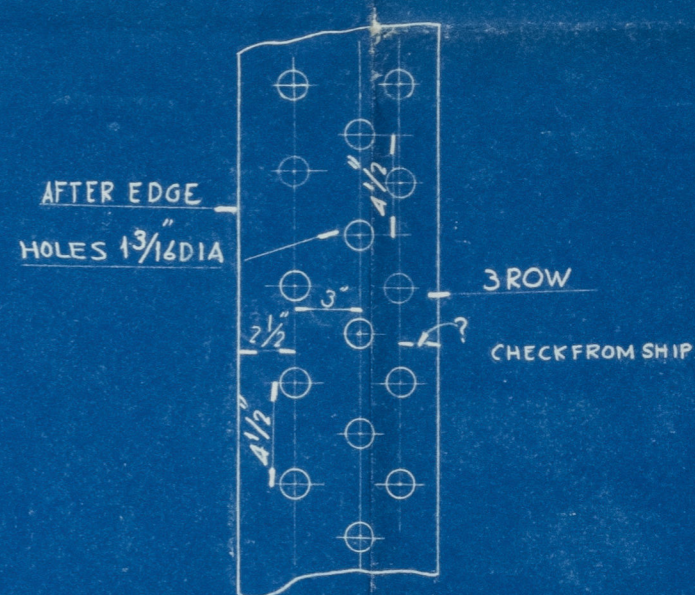

NOTE:-

1. STERN FRAME HAVE BEEN PARTLY RENEWED ACCORDING TO THIS ORIGINAL PLAN
2. RED SHOWN PARTLY RENEWED.

BRITISH INDIA ENG. WORKS
DRG. NO. SR/185
TRACED BY:
DATE 15/10/56

TRACED BY HITACHI CHIKKO
DATE DEC. 21. 1956
DRG NO. 1368

004107-004115-0102