

NYK 24/6/32

9 - DEC 1929

Index No. 33310
(For London Office only.)

Lloyd's Register of Shipping.

SURVEYS FOR FREEBOARD.—STEAM SHIPS.

Hull No. 40412

Port of Survey

Date of Survey

Name of Surveyor

7-12-29

G. Semarist

Ship's Name.

Port of Registry
and Nationality.Official
Number.Gross
Tonnage.

Date of Build.

Particulars of Classification.

MARKLAND

Canadian
Liverpool

161135

✓

1929

100 A 1
contemplated

Register Book ✓

LENGTH. 327.3 52.7 27.3 3555.12
BREADTH. 326.5
DEPTH. 27.3
UNDER DECK TONNAGE. 3555.12

Frame Depth 11' 6" Ceiling fitted 6' 6" Sheer -1.03' Peak Tanks included
Rule "6 1/2" To Tank Top 37.34
x 2 = 74.68
For "Sparrow" 4.17
52.64 48
3555.12

3555.12
44558.12
48
0.18
0.77
0.78

13 8 1/2 21.5 ÷ 2 = 10.75 Mean 36138.82
1.06


Moulded Depth as measured..... 30'-0"

Addition for Keel below base line
for draught record..... inches. 1.39"NOTE.— If the
depth is measured
when vessel is
afloat, the details
of measurement
should be reported.30-0
1-1
31-1
3-6 1/2
27-6 1/2

CORRECTION FOR LENGTH.

Length of Ship on Loadline..... 326.5
Length in Table 360.0
Difference 33.5
Correction for 10ft., Table A. 1.5 Table C. .8
× Difference divided by 10 50.25 (if required.) 2.68
If 1/10ths length covered divide by 2 - 2 1/2 "5" - 2 3/4

CORRECTION FOR IRON DECK.

Proportion covered, if less than 1/10ths length covered 0.631
Thickness of usual wood deck, less stringer 3.3" 14 3/4 " 33x724=2.39
=-2 1/2

CORRECTION FOR ROUND OF BEAM.

Breadth at Gunwale amidships..... 52.5
Round of Beam 13"
Normal round..... 13.12
Difference 8.12 2 = .06
Proportion of Deck uncovered (Para. 19) ✓ NIL

NOTE.— The
round of beam
should be reported
on the full
breadth of vessel
at the gunwale.

Freeboard, Table A (Summer 4 1/2") 7' 4 1/2 " 6 3/4

Correction for Sheer 19 1/2 " 12

Correction for Length 8-4 3/4 " 14

Allowance for Deck Erections 2-9 " 1 3/4

Correction for Round of Beam..... 5-5 1/4 " 6-7 1/2

Correction for fall in Sheer (if any)..... nil

Correction for Steel Deck (if required) 2 1/2

Additions for non-compliance with provisions of
Para. 11 (d) and (e) 5-1 3/4

Other Corrections (if any) 6-5

Winter Freeboard 5' 1 3/4 " 6-5

Summer Freeboard (4 1/2") - 5 1/2 - 5 1/4 4-8 1/4 5-11 1/4

Indian Summer Freeboard 4-2 3/4 5-6 1/2

N. A. Winter Freeboard 5-3 1/4 6-7

Correction necessary because clearside amidships, measured
in accordance with the Statute is not taken at the
intersection of the wood or steel deck with side. + 1 3/4

Winter Freeboard from deck line, 5-3 1/2 " 6-6 3/4

Summer " " " 4-10 " 6-1 1/2

Indian Summer " " " 4-4 1/2 5-8 1/4

N. A. Winter " " " 5-5 1/2 6-8 1/4

Fresh Water Line above centre of Disc 6'-1 1/2" 4-10 1/2

Indian Summer Line " " " 5 1/2 5 1/2

Winter Line below " " " 5 1/2 5 1/2

Winter North Atlantic Line " " " 7 1/2 7 1/2

State dimensions of freeing port area on back of this form.

The Surveyor should state whether the fall in sheer as reported is measured relatively to the straight
line of keel or to the water line. If measured relatively to water line the vessel's draft at time of
survey, and also the usual load draft forward and aft, should be reported.

(Para. 11, 12, 13, or 14)

FREEBOARD recommended amidships from centre of Disc to top of Statutory Deck Line, Wood (Steel) Deck :—

Fresh Water Line above centre of Disc

Indian Summer Line " " "

Winter Line below " " "

Winter North Atlantic Line " " "

If the frames, skin planking, or ceiling are of unusual thickness the breadth of vessel to inside
of ceiling should be reported if possible.
If vessels obtaining an allowance for deck erections under Para. 11 where the sheer drops abaft amid-
ships the height of the R.Q.D. is to be taken from the level of the top of the amidship beam.
In flush-decked vessels the total standard mean sheer means the sheer measured at the stem and stern-
post. In vessels having poops and forecastles, it means the sheer measured at points distant
one-eighth of the vessel's length from stem and stern-post.

+ State dimensions of freeing port area on back of this form.

The Surveyor should state whether the fall in sheer as reported is measured relatively to the straight
line of keel or to the water line. If measured relatively to water line the vessel's draft at time of
survey, and also the usual load draft forward and aft, should be reported.

© 2020

Lloyd's Register
Foundation

13/12/29

004153-004159-0037

Do all the Frames extend to the top height in the Poop? *Yes* Raised Quarter Deck? ☒ Bridge House? ☒ Forecastle? ☒

To what height do the Reverse Frames extend? *channel frames*

Has the Poop or Raised Quarter Deck an efficient Iron Bulkhead at the fore end? *Yes protected by bulk in ce*

Give particulars of the means for closing the openings in Bulkhead *none No opening*

Is the Poop or Raised Quarter Deck connected with the Bridge House? *TRUNK Yes* Has the Bridge House an efficient Bulkhead at the fore end? ☒

Give particulars of the means for closing the openings in Bulkhead ☒

What is the thickness of the Bridge Front plating? ☒ and Coaming plate? ☒

Give scantlings and spacing of the Stiffeners ☒

Are bracket plates fitted at each end of the Stiffeners? ☒ Are hor'l. brackets fitted connecting Bridge Bulk'd. with Bulwarks? ☒

Has the Bridge House an efficient Iron Bulkhead at the after end? ☒

How are the openings closed? ☒

Is the Forecastle at least as high as the main or top-gallant rail? *Yes* Has the Forecastle an efficient Iron or Wood Bulk'd. at after end? ☒

Are the Engine and Boiler openings covered by a Bridge, Poop, Raised Quarter Deck, or enclosed by a Strong Iron or Steel Deckhouse? *enclosed in steel deckhouse*

If the openings are not so protected are the exposed parts of the Casings efficiently constructed? ☒

Give thickness of plating; scantlings and spacing of Stiffeners ☒

What is the height of the exposed Casings? ☒ Are suitable means provided for closing all openings in them in bad weather? ☒

Are the Weather Deck Hatchways efficiently constructed and at least equal to the requirements of the Rules? Give particulars below:— *Yes*

Position.	F	No. 1 - 24' x 24' 11" to 24' 7"	No. 2 - 31' 6" x 30' 6"	No. 3 - 31' 6" x 30' 6"	No. 4 - 31' 6" x 30' 6"
Size.					
Height above top of DECK		2' 3"	2' 3"	2' 3"	2' 3"
COAMING Thickness		Sides 1/4"			
		Ends 1/4"			
SHIFTING BEAMS OR WEB PLATES		Number 3	4	4	4
		Section and Scantlings plate 25' x 1/2"			
		Material Steel			
* FORE AND AFTERS		Number 4 angles			
		Section and Scantlings 6 x 3 1/2 x 50			
		Material horizontal stiffener	B.A.	7 x 3 1/2 x 40	2 - 2" stays.
HATCHES Thickness		3"			
Remarks		<i>✓</i>			

* The depth of Fore and Afters should be stated from the underside of the hatches in all cases.

(If the sill of the lowest side scuttle will be less than 6 inches above the Indian Summer Load Line if assigned under tables, state vertical distance from top of keel to lower edge of lowest side scuttle.) *See plan forwarded*

The following information is to be given in all Cases of vessels dealt with under Paras. 11, 12 (under 15 feet Moulded depth) and under Shell

What is the thickness of the Bridge Sheerstrake? ☒ Strake between Main and Bridge Sheerstrakes? ☒


Delete the words { The Crew ~~are~~, are not, berthed in the bridge house.
that do not apply { The arrangements to enable them to get backwards and forwards from their quarters ~~are~~, are not satisfactory.

Length of Bulwarks in well *24 ft. 5*

Area of Freeing Ports required by Para. 11 (e) each side of vessel = *55 Sq. ft. 0*

Ft.	Tenths.	Ft.	Tenths.	No.	Freeing Ports (each side of vessel)	= <i>54.4</i> } <i>57</i> Sq. ft. <i>4</i>
<i>1.5</i>	<i>x</i>	<i>1.45</i>	<i>x</i>	<i>25</i>		
<i>1.5</i>	<i>x</i>	<i>1.00</i>	<i>x</i>	<i>2</i>		

Total deficiency or excess = *in Bulkheads 2* Sq. ft. *4*

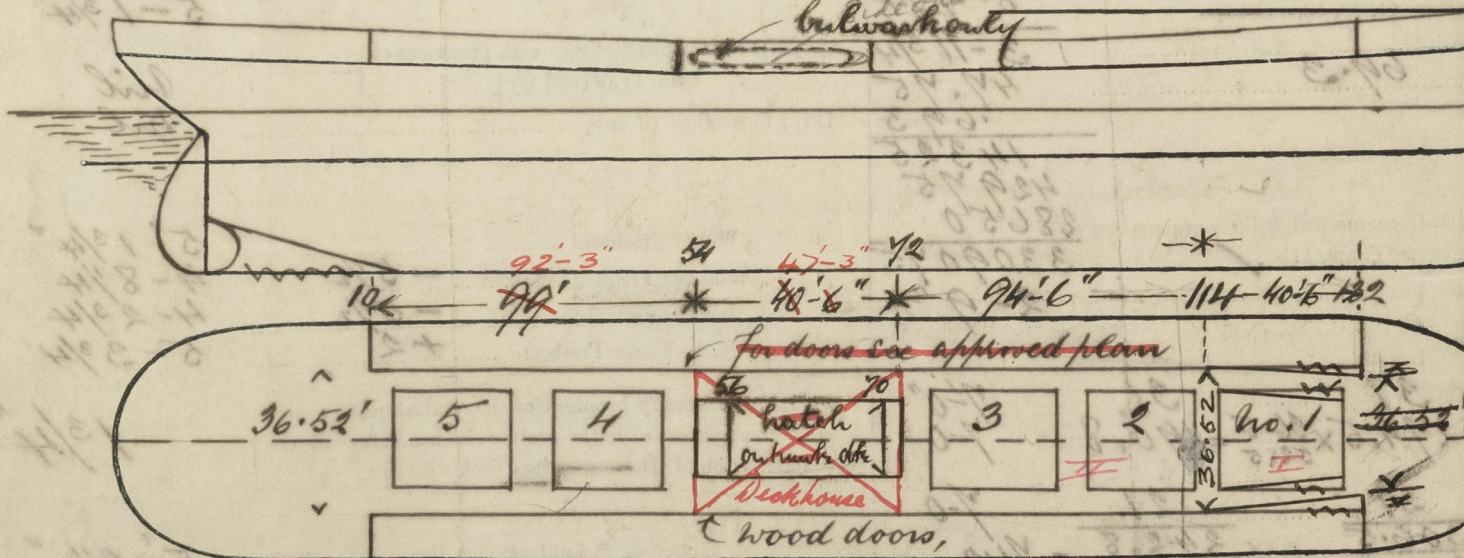

Show hereon line of Floors or Tank Top with position of any Breaks in same; also height of Peak Tank tops, &c., &c.

State any special features in the construction of the Vessel *bulk 52.52 / 36.52 = .69 - height 39*

Builder's name and yard number *Earle's S. B. & E. Co's No. 677*

Names of sister vessels ☒

Owners *Mercer Shipping Co., Ltd.*

Address *Liverpool, Nova Scotia.*

Fee £ *8 : 6 : 8*

To be applied for with F. & F. pers.
Received by me

Insert fee gross tonnage not yet calculated.

© 2020

Lloyd's Register
Foundation