


POOP DECK

26 OCT 1946

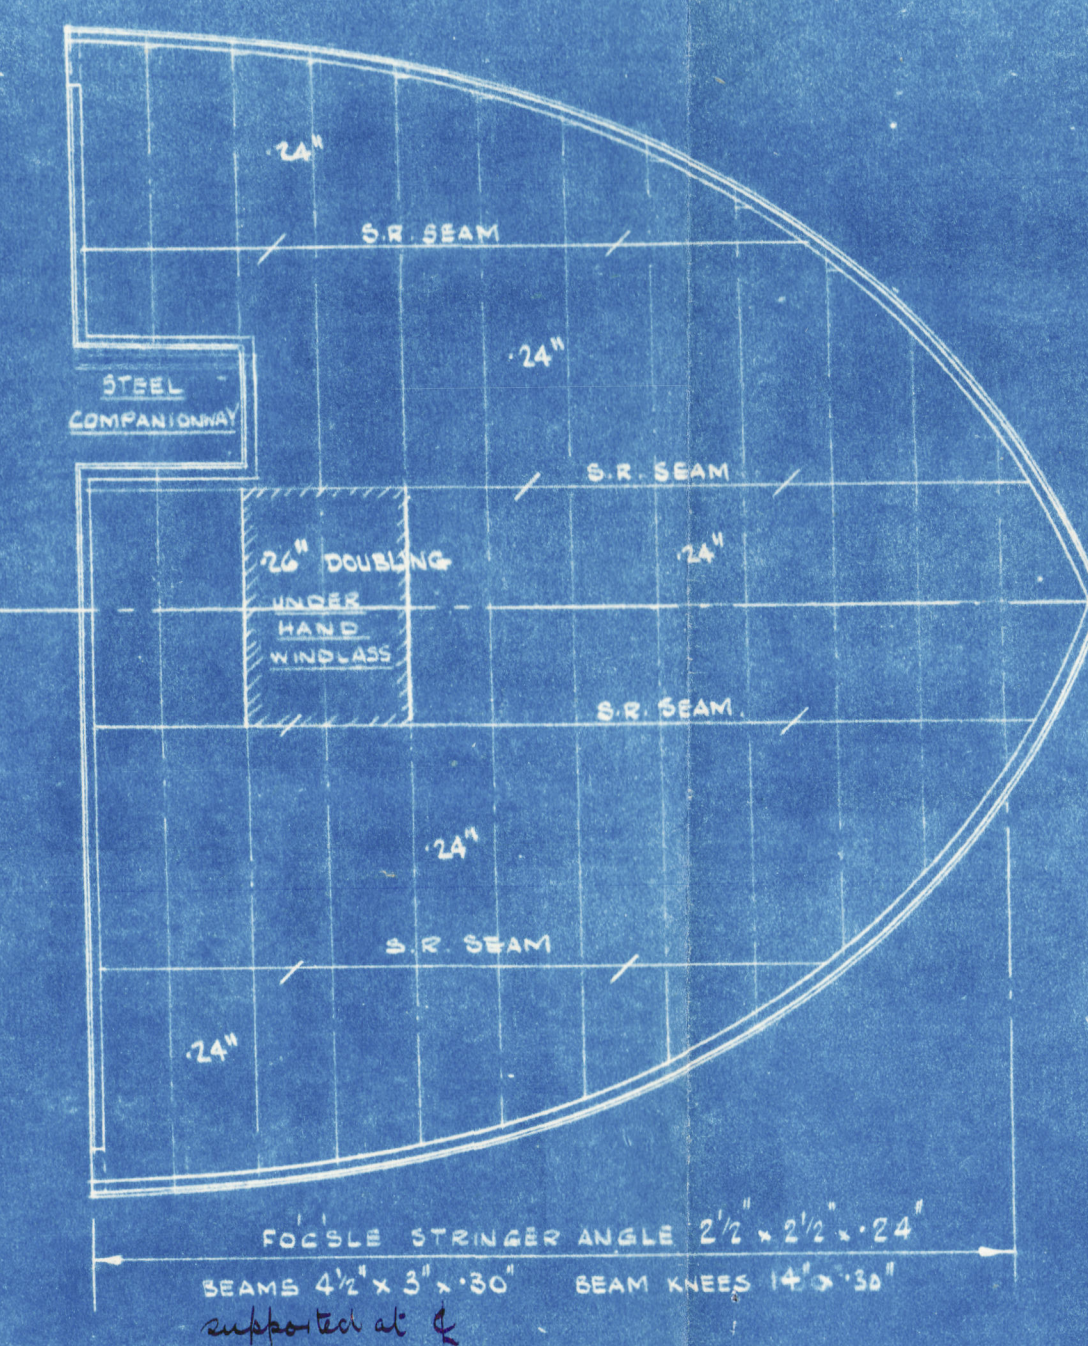

NOTE - FRAMES SPACED 21" THROUGHOUT
GENERALLY OF RIVETTED CONSTRUCTION
EXCEPT BHDS WHICH ARE WELDED CONSTRUCTION

TORQUAY RPT. No 4888.

POLURRIAN ★

PROFILE

APPD 28-10-46

RECORDS DEPT.,
LONDON



RECORDS DEPT.,
LONDON

2

RETAIN



© 2021

Lloyd's Register
Foundation

004222-004224-0006