

PLAN No 87

SHIP No 274


PROFILE & DECKS

SCALE: 1/4" INCH = 1 FOOT

CLASS 100 A.I. AT LLOYDS



Latest Plan

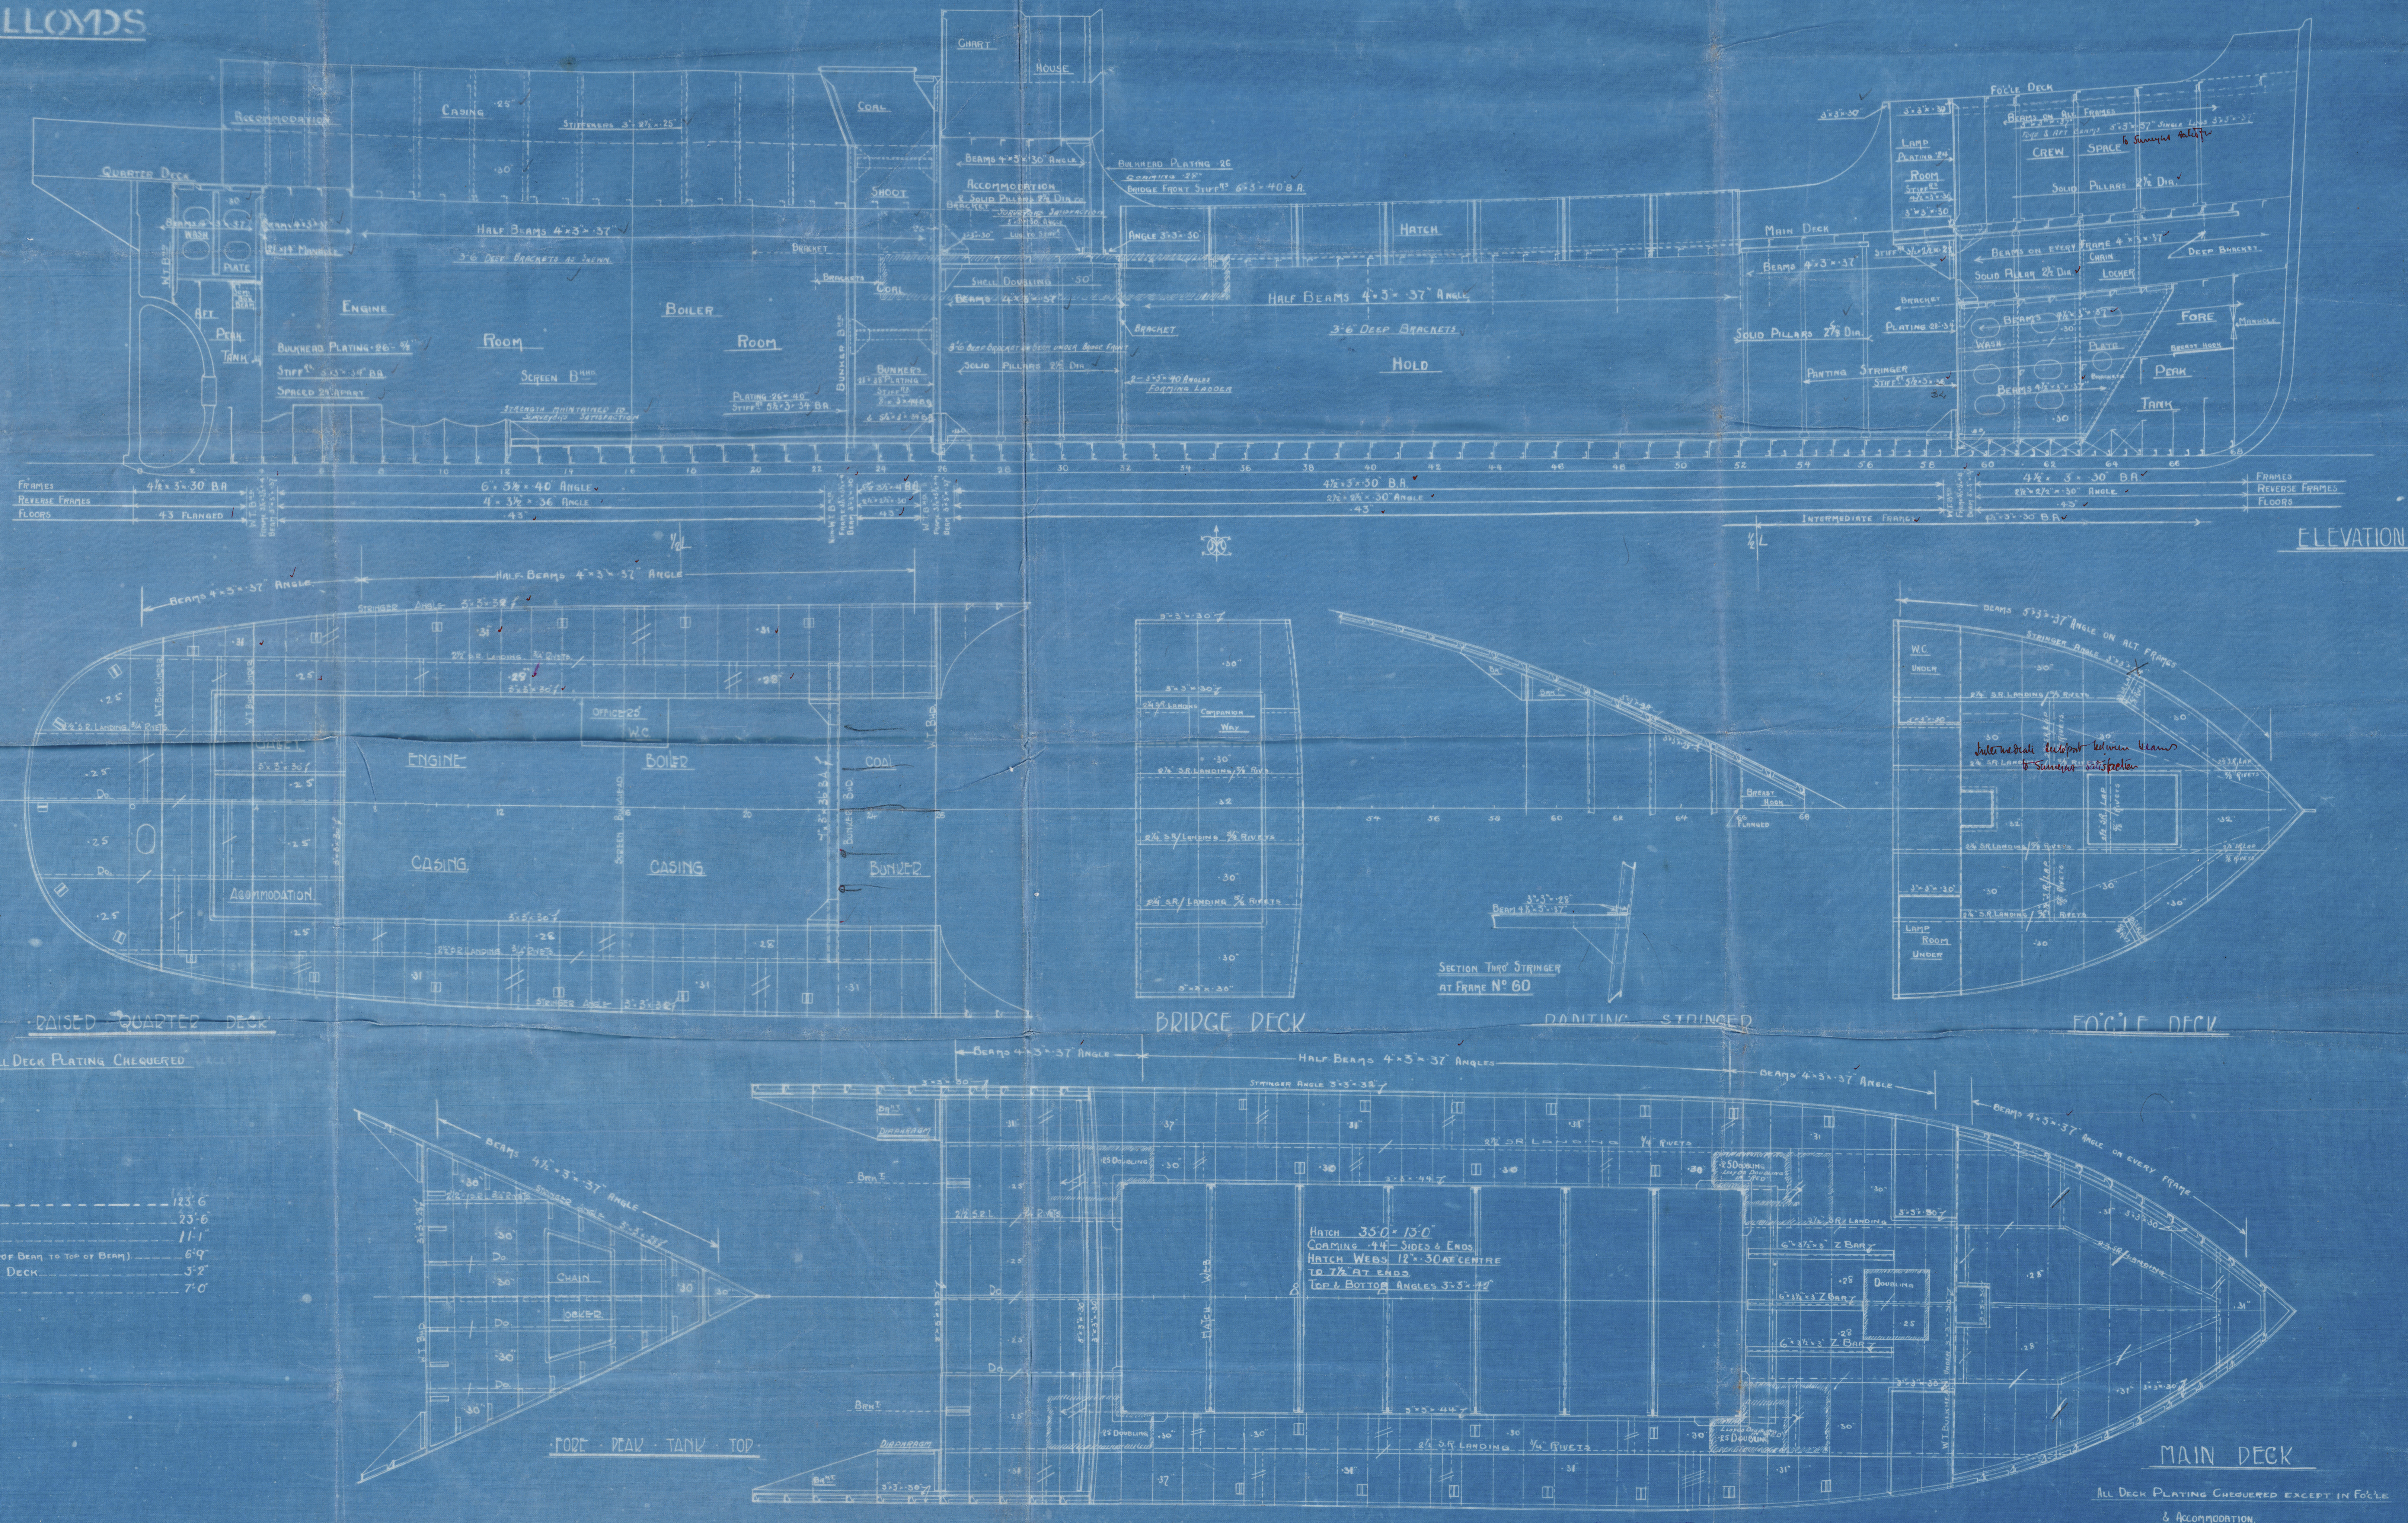

LENGTH B.P. 123' 6"
 BREADTH M.L.D. 23' 6"
 DEPTH M.L.D. 11' 1"
 MAIN DECK TO FORE DECK (TOP OF BEAM TO TOP OF BEAM) 6' 9"
 RAISED QUARTER DECK 3' 8"
 ENGINE & BOILER CASING 7' 0"

APPROVED
 LLOYDS REGISTER OF SHIPPING

15.12.10

Ardrossan D.D. S.B. Cold.
no 274.

Profile & Deck

Profile & Deck

Graham F.

GLASGOW REPORT No. 39909.

% Lady Thomas

n.m.

WARREN COURT

RETAIN

004222-002224-008



© 2021

Lloyd's Register
Foundation