

SHIP N° 173.
PROFILE & DECKS.

SCALE :- 1/8" = 1 FOOT. DETAILS :- 1/4" = 1 FOOT.
DIMENSIONS: 235'-6" L.W.L. x 37'-10" MLD. x 18'-6" MLD. TO UPPER DR. (+4'-0" R.Q.D.K.)
To LLOYDS SURVEY. CLASS * 100 A.I. WITH NEW LOAD LINE FREEBOARD
CORRESPONDING TO A MOULDED DRAFT OF 15'-10 3/8".

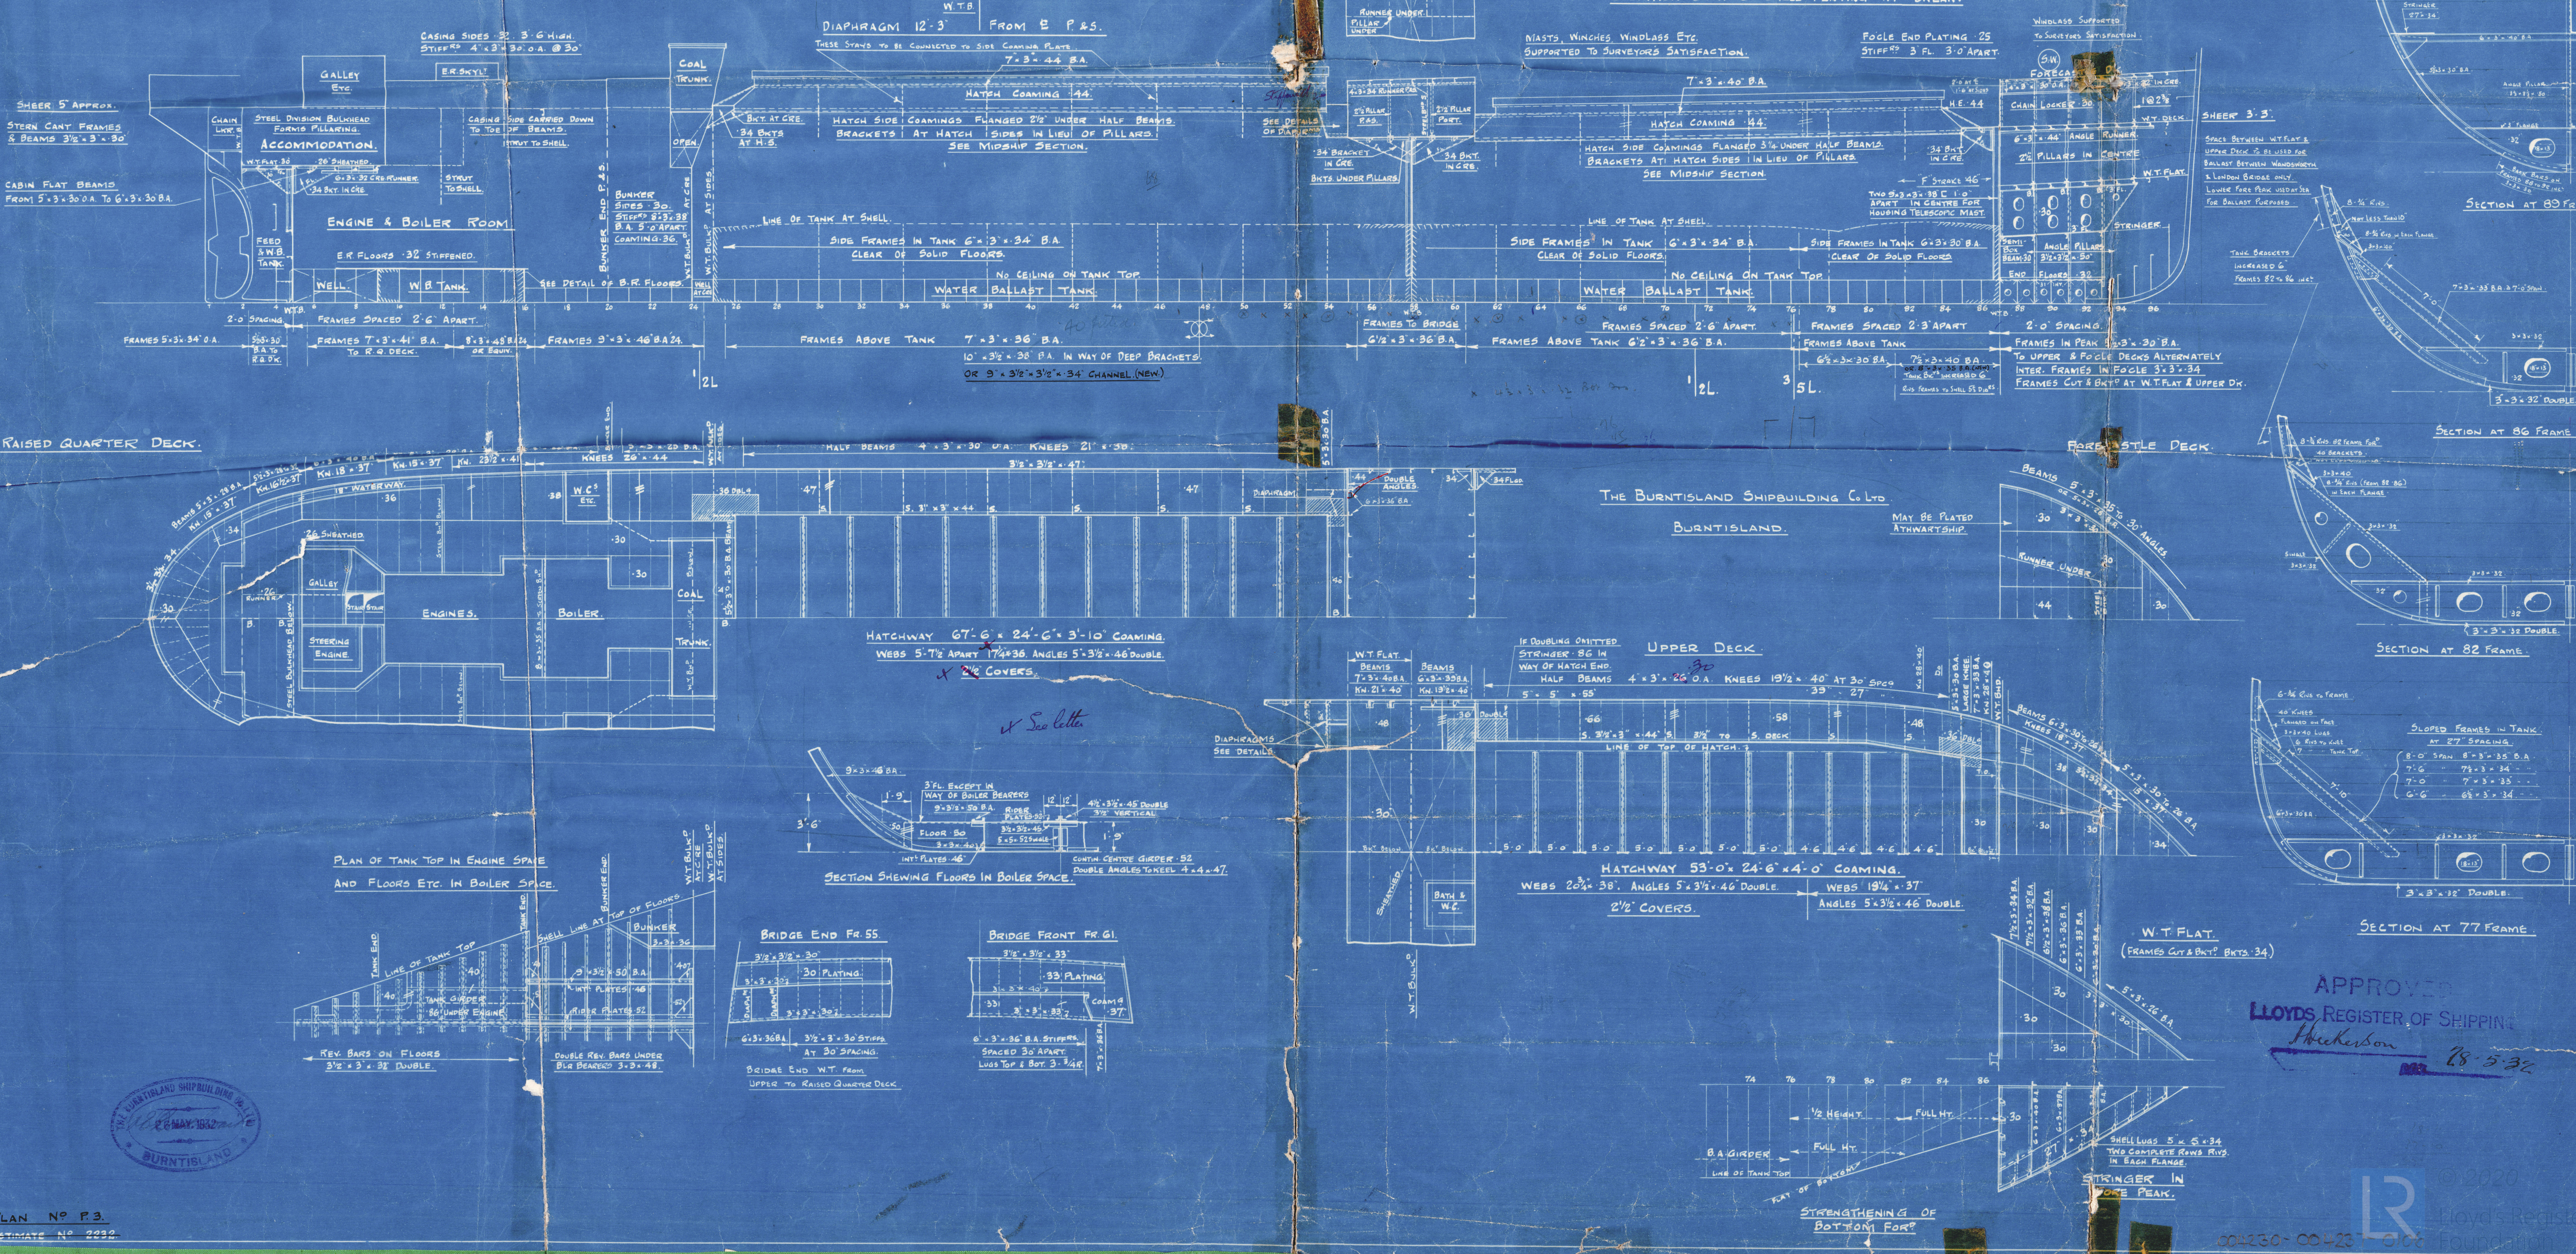


TABLE OF BULKHEAD SCANTLINGS.

| ID | COAMING | PLATING | STIFFS | SPACING OF STIFFS | KNEES | RIVETS | BEAM | FRAME | TO TANK TOP |
|----|---------|-------------|---------------|-------------------|-------------|--------|--------|--------|-------------|
| 5 | 36x42 | 30 | 7 1/2 x 36 BA | 24 | 19x40 | 4-3/4 | 3x3x36 | 3x3x40 | - |
| 24 | 44x44 | 26-32 | 9x3x44 BA | 30 | 22 1/2 x 34 | 6-3/4 | 3x3x36 | 3x3x42 | - |
| 25 | 44x44 | 43 IN LIMBS | 8x3x44 BA | 30 | 20x42 | 5-7/8 | 3x3x36 | 3x3x41 | 3x3x42 |
| 58 | 36 | 26-31 | 8x3x44 BA | 24 | 12 1/2 x 36 | 3-3/4 | 3x3x36 | 3x3x43 | - |
| 87 | 39 | 30-33 | 6x3x36 BA | 24 | 15x36 | 3-3/4 | 3x3x36 | 3x3x43 | - |



APPROVED
LLOYDS REGISTER OF SHIPPING
Hickinson
28.5.32

THE BURNTISLAND, S.B. CO.
N^o 173

PROFILE & DECK

Lt. Rpt. No 18282

S/S Wandle

RETAIN

004230-004231-0106

© 2020

Lloyd's Register
Foundation