

OFFICE COPY

| KLINKWERK                                   |            |            |           |
|---------------------------------------------|------------|------------|-----------|
| DEKBALEN HOOFDEK BUITEN TANKS               | DIAM. NAG. | AANT. RYEN | AVST. AD. |
| BAKDEK                                      | 5/8        | 1          | 7         |
| HOOFDEK                                     | 5/8        | 1          | 7         |
| HOOFDEK T.V. OLIETANKS                      | 5/8        | 1          | 7         |
| PLATZER MET SWINGSCHOTEN EN KRIESEN         | 5/8        | 1          | 7         |
| SPANTEN MET SPAREN IN VOERPIER              | 5/8        | 1          | 7         |
| STRINGER X T.V. OLIETANKS (IN DEK) SIG. 2-2 | 5/8        | 1          | 5         |
| X BAK-DEK                                   | 5/8        | 1          | 7         |
| DEKBALEN HOOFDEK BUITEN OLIETANKS BOVENDEK  | 5/8        | 1          | 6         |

TREKKERS X 115x52 1/2  
AAN STIJLEN EN  
AAN SCHOTEN

LANGSCHOT O.D.  
LANGSCHOT NIETWA

WEG. 7% TENS. 55%

KRIE 7% PL. 65%

# STRINGERS




## BOUW N° 253 LANGSDOORSNEDE EN DEKKEN

SCHAAL 1:50

HOOFDREKMETINGEN:  
LENGTE OVER ALLES 46.00 M. 150' 11"  
LENGTE TUSSEN LL 42.00 M. 137' 4 3/8"  
BREEDTE OP SPANTEN 7.40 M. 24' 3 3/8"  
HOLTE TOT HOOFDEK 5.15 M. 16' 11"  
KLASSE LLOYDS + 100 A.I. (CARRYING PETROLEUM IN BULK)


# HOOFD-DEK

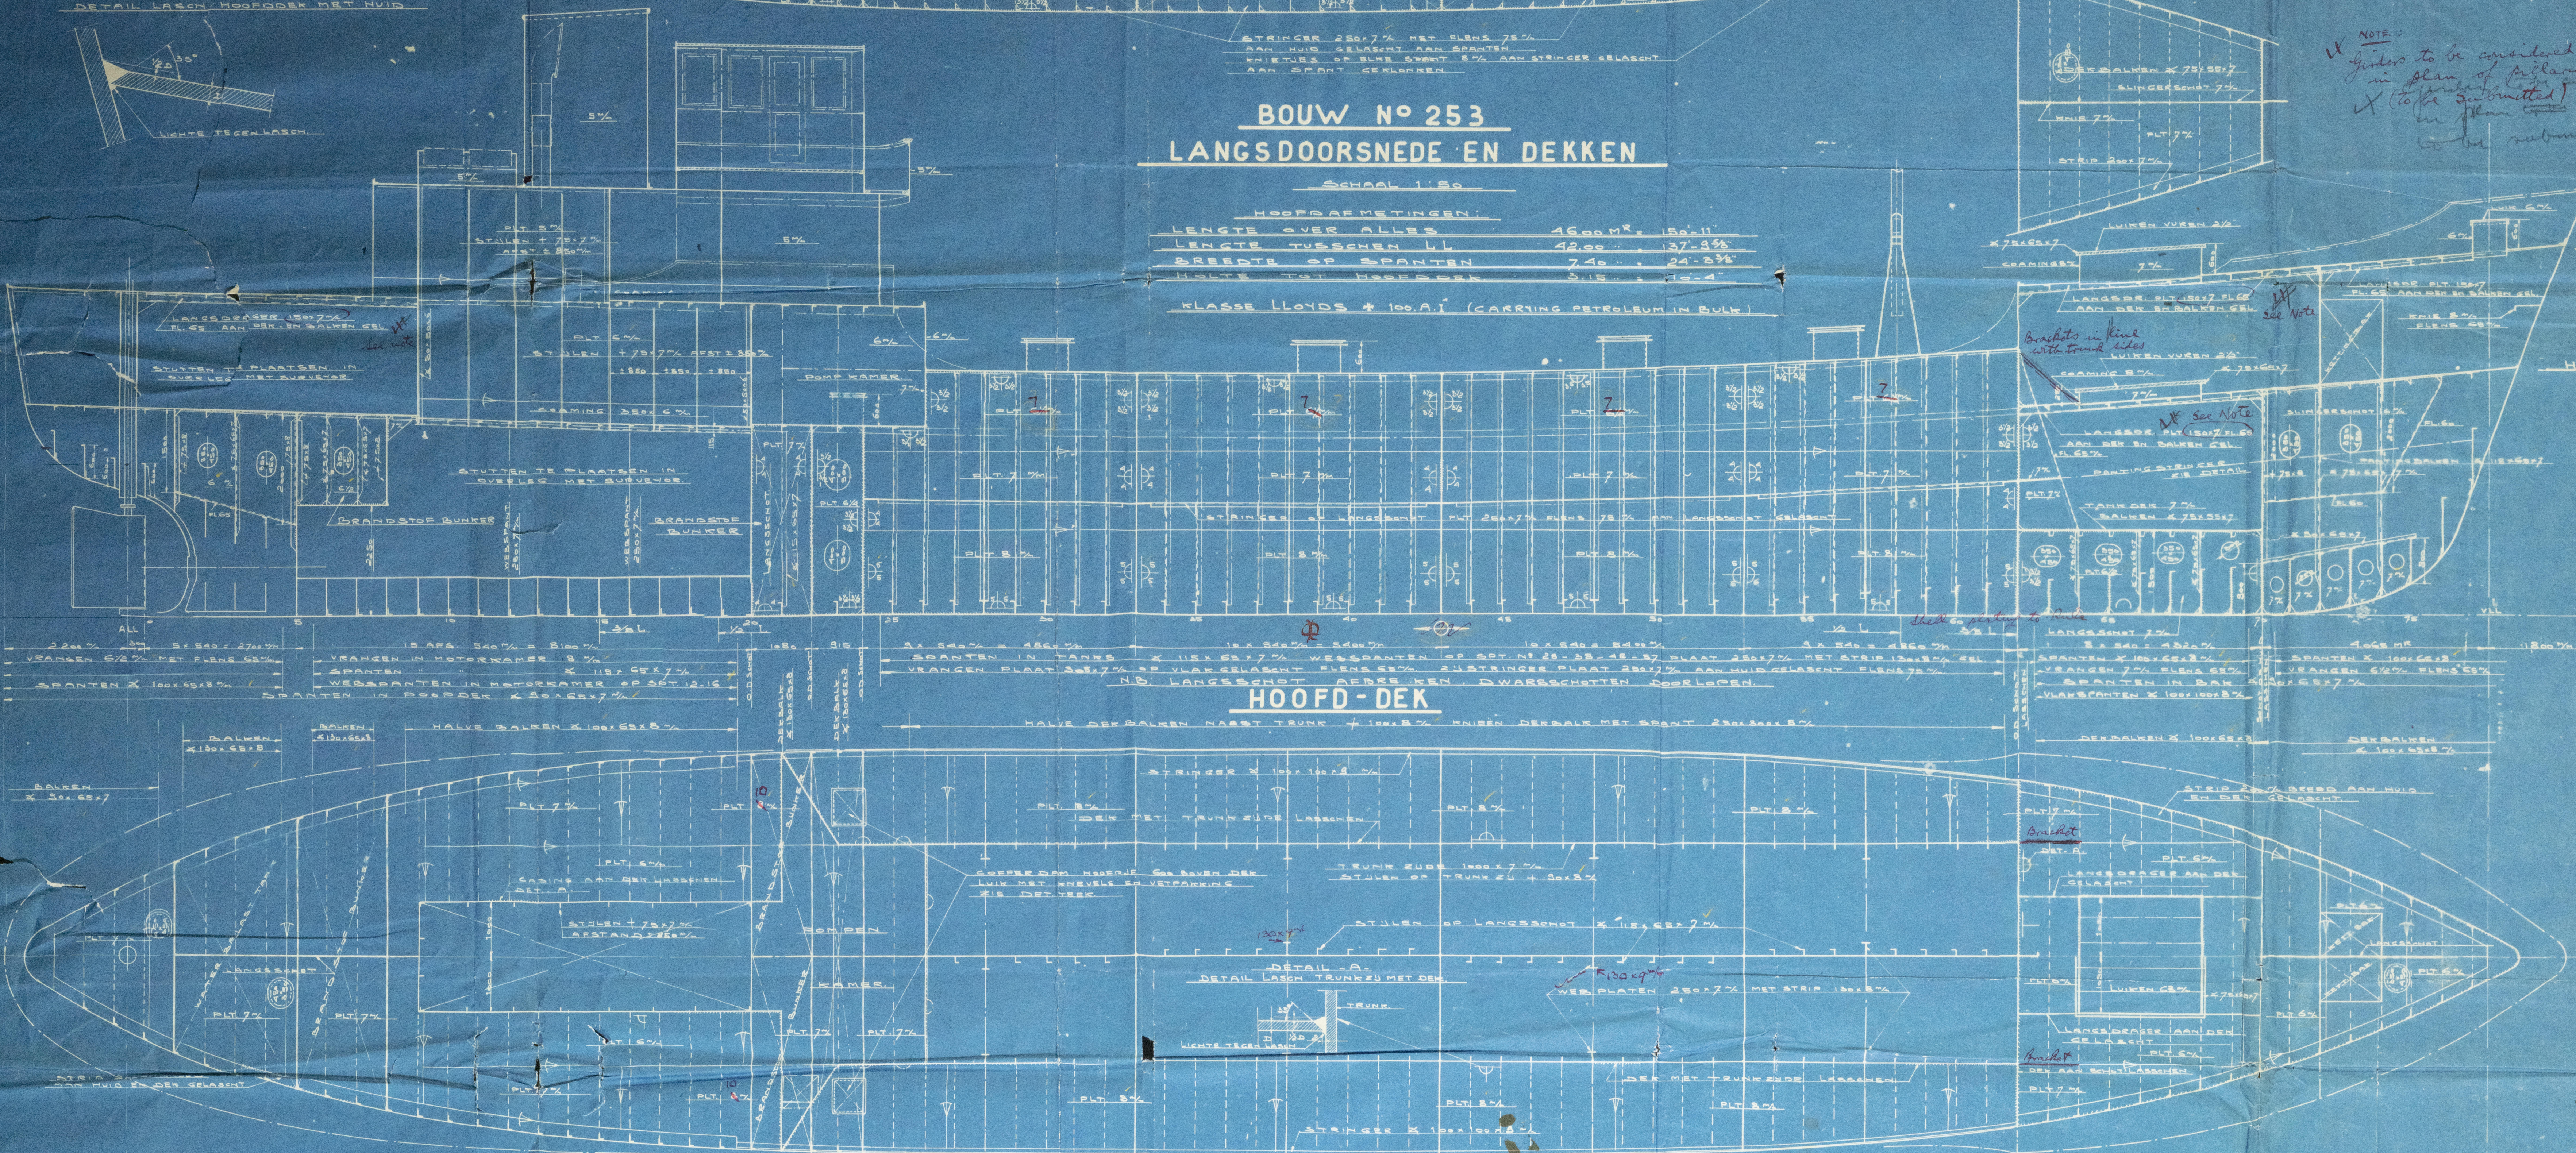

# POOP-DEK

# TRUNK-DEK

# BAK-DEK

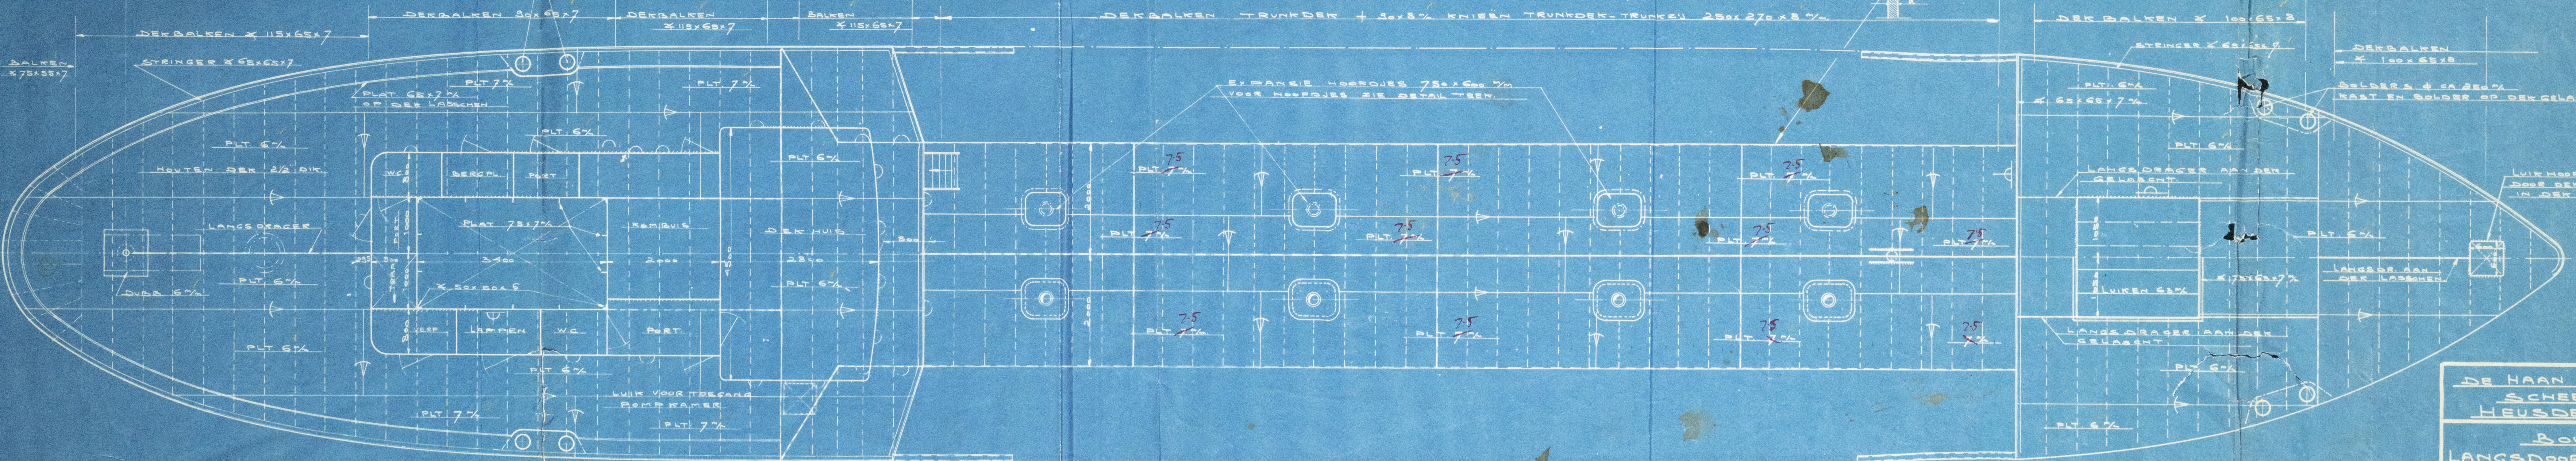

NOTE:  
finders to be provided  
in plan of pillars  
(to be submitted)  
in plan of pillars  
to be submitted

DE HAAN & GERLEMAN'S  
SCHEEPSWERF  
HEUSDEN - HOLLAND  
BOUW N° 253  
LANGSDOORSNEDE EN DEKKEN  
SCHAAL 1:50  
TEK. N° 253.51



DE HAAN & OERLEMANS.

YARD No 253.

PROFILE OF DECKS.



© 2021

Lloyd's Register  
Foundation

004263-004274-0165



RETAIN

RECORDS DEPT.,  
LONDON

2

"ELIZABETH B. ★"

CO 4263-004274-0165

DE HAAN & OERLEMANS  
YARD NO. 253

PROFILE



© 2021

Lloyd's Register  
Foundation