

## Lloyd's Register of Shipping.

## SURVEYS FOR FREEBOARD.

11 JAN 1950

(CONDITIONS OF ASSIGNMENT.)

Ship's Name "FELIPES"

Port of Survey SUNDERLAND

Official Number ✓


Surveyor's Signature

Alfred T. J. Sheffer

Nationality and Port of Registry DUTCH 'S - GRAVENHAGE

Date of Survey WHILE BUILDING.

Disposition and dimensions of superstructures, trunks, deckhouses and machinery casings to be inserted in the diagrams and tabular statement:--

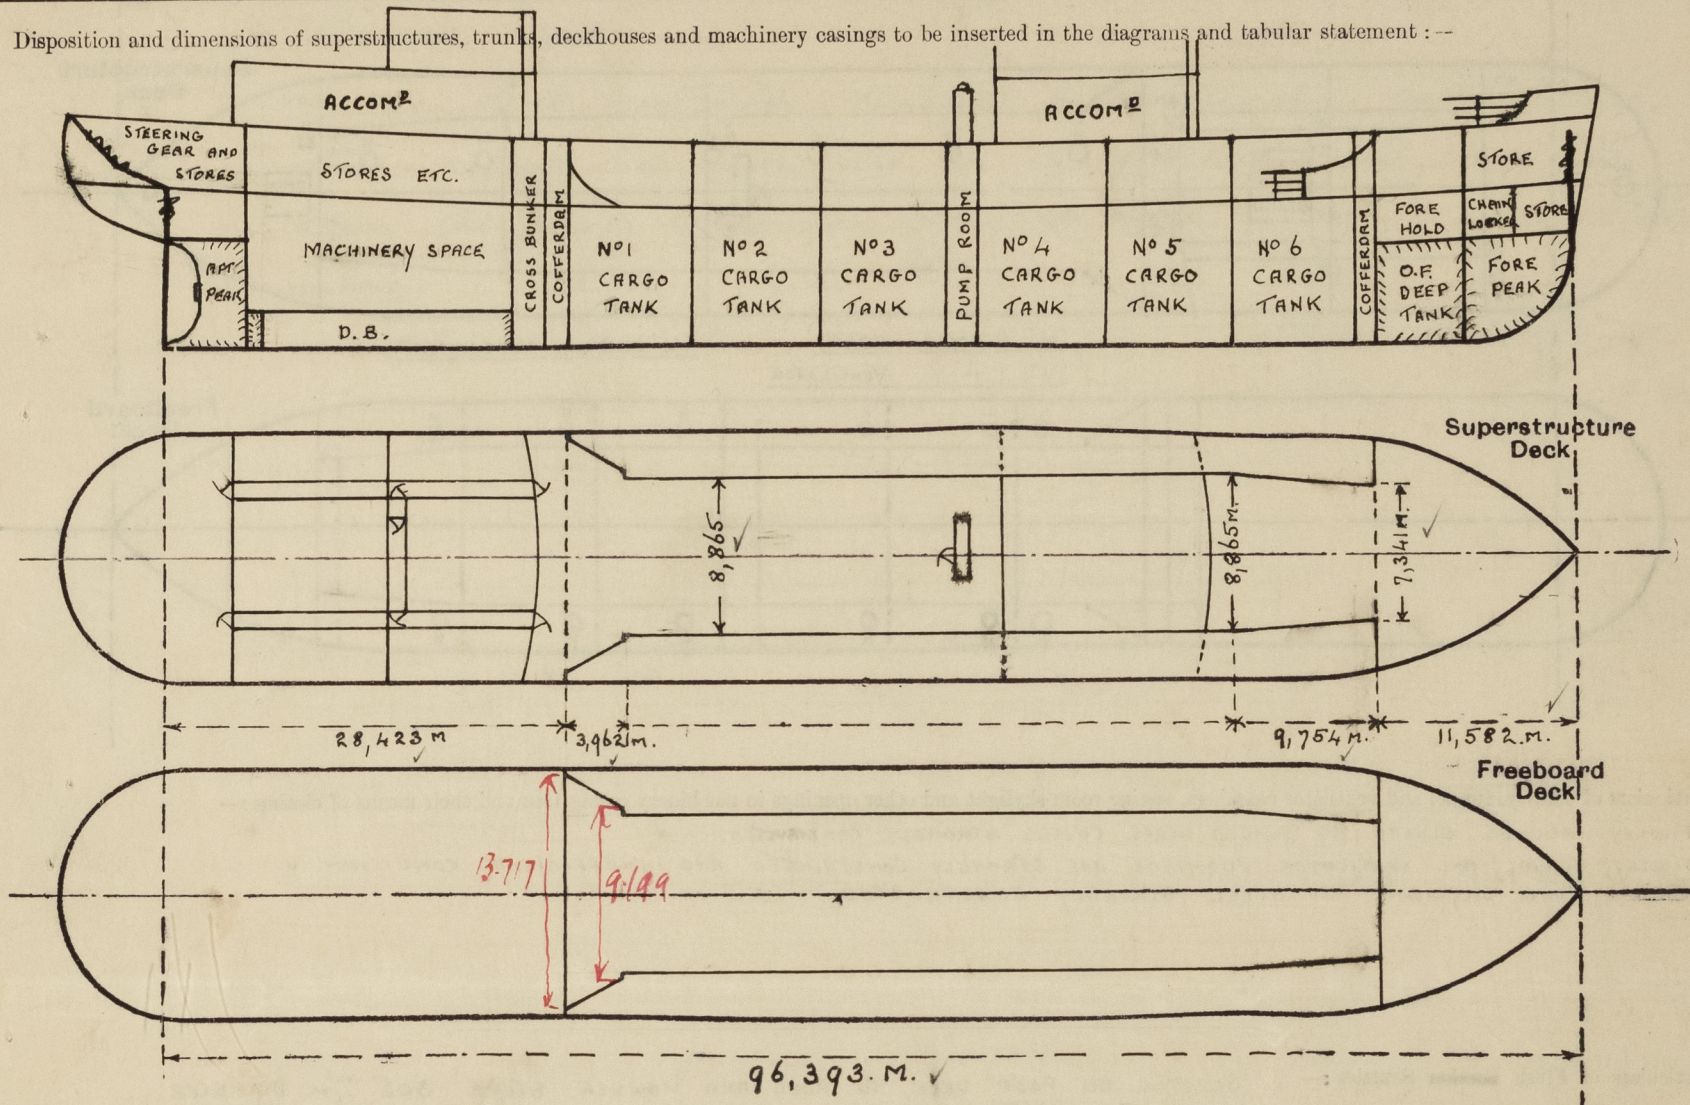

Particulars of Superstructures, Trunks, Casings, Deckhouses.

	Coaming	Plating	Stiffeners	Spacing	End Attachments of Stiffeners	Size of Openings	Height of Sills	Height of Casings
Poop Bulkhead ...	NONE	10 mm	HORIZONTAL B.P. WELDED TOE ON 203 x 10 mm SUPPORTED BY FLANGED WEBS 475 x 10 mm.	711 mm	BRACKETS	NIL	NIL	2,134 M.
Raised Quarter Deck Bulkhead ...	✓							
Bridge, After Bulkhead ...	✓							
Bridge, Forward Bulkhead ...	✓							
Forecastle Bulkhead ...	NONE	10 mm	BULB PLATE WELDED 178 x 10 mm	737 mm	BRACKETS	NIL	NIL	2,134 M.
Trunk, Aft ...	NONE	12 mm	HORIZONTAL B.P. WELDED TOE ON 152 x 10 mm WITH WEBS AND TRANSVERSE Blds. AS APPROVED.	711 mm	BRACKETS	NIL	NIL	2,134 M.
Trunk, Forward ...								
Exposed Machinery Casings on Freeboard or Raised Quarter Decks ...			NIL.					
Exposed Machinery Casings on Superstructure Decks IN POOP DECK HOUSE	NONE	7 mm	76 x 64 x 7 mm OR	1,067 M.	LUGS	1 P. 1,829 x 610 mm I.S. DITTO	152 mm	2,286
Machinery Casings within Superstructures not fitted with Class I Closing Appliances ...			NIL.			HEIGHT OF SILLS OF DOORWAYS TO DECKHOUSE ALLEYWAY =	381 mm	
Deckhouses on Flush Deck Ships ...			✓					


Particulars of Closing Appliances (state if capable of being manipulated from both sides).

Poop Bulkhead	...	...	...	NO OPENINGS ✓	
Raised Quarter Deck Bulkhead	...			✓	
Bridge, After Bulkhead	...	...		✓	
Bridge, Forward Bulkhead	...	...		✓	
Forecastle Bulkhead	...	...	...	NO OPENINGS. ✓	
Exposed Machinery Casings on Freeboard or Raised Quarter Decks	...			✓	
Exposed Machinery Casings on Superstructure Decks IN POOP DECK HOUSE.				PORTSIDE. 1 HINGED STEEL DOOR	EACH STRONGLY CONSTRUCTED AND CAPABLE OF BEING OPERATED FROM BOTH SIDES.
Machinery Casings within Superstructures not fitted with Class I Closing Appliances	...	...	...	STARBOARD. 1 " WOOD "	
Deckhouses on Flush Deck Ships	...			✓	
				✓	



# PARTICULARS OF PROTECTION TO OPENINGS, ETC.

The following diagrams should be used to indicate the positions of cargo and coaling hatchways, gangway, cargo and coaling ports, ventilators, companionways, etc., which would affect the seaworthiness of the ship:-

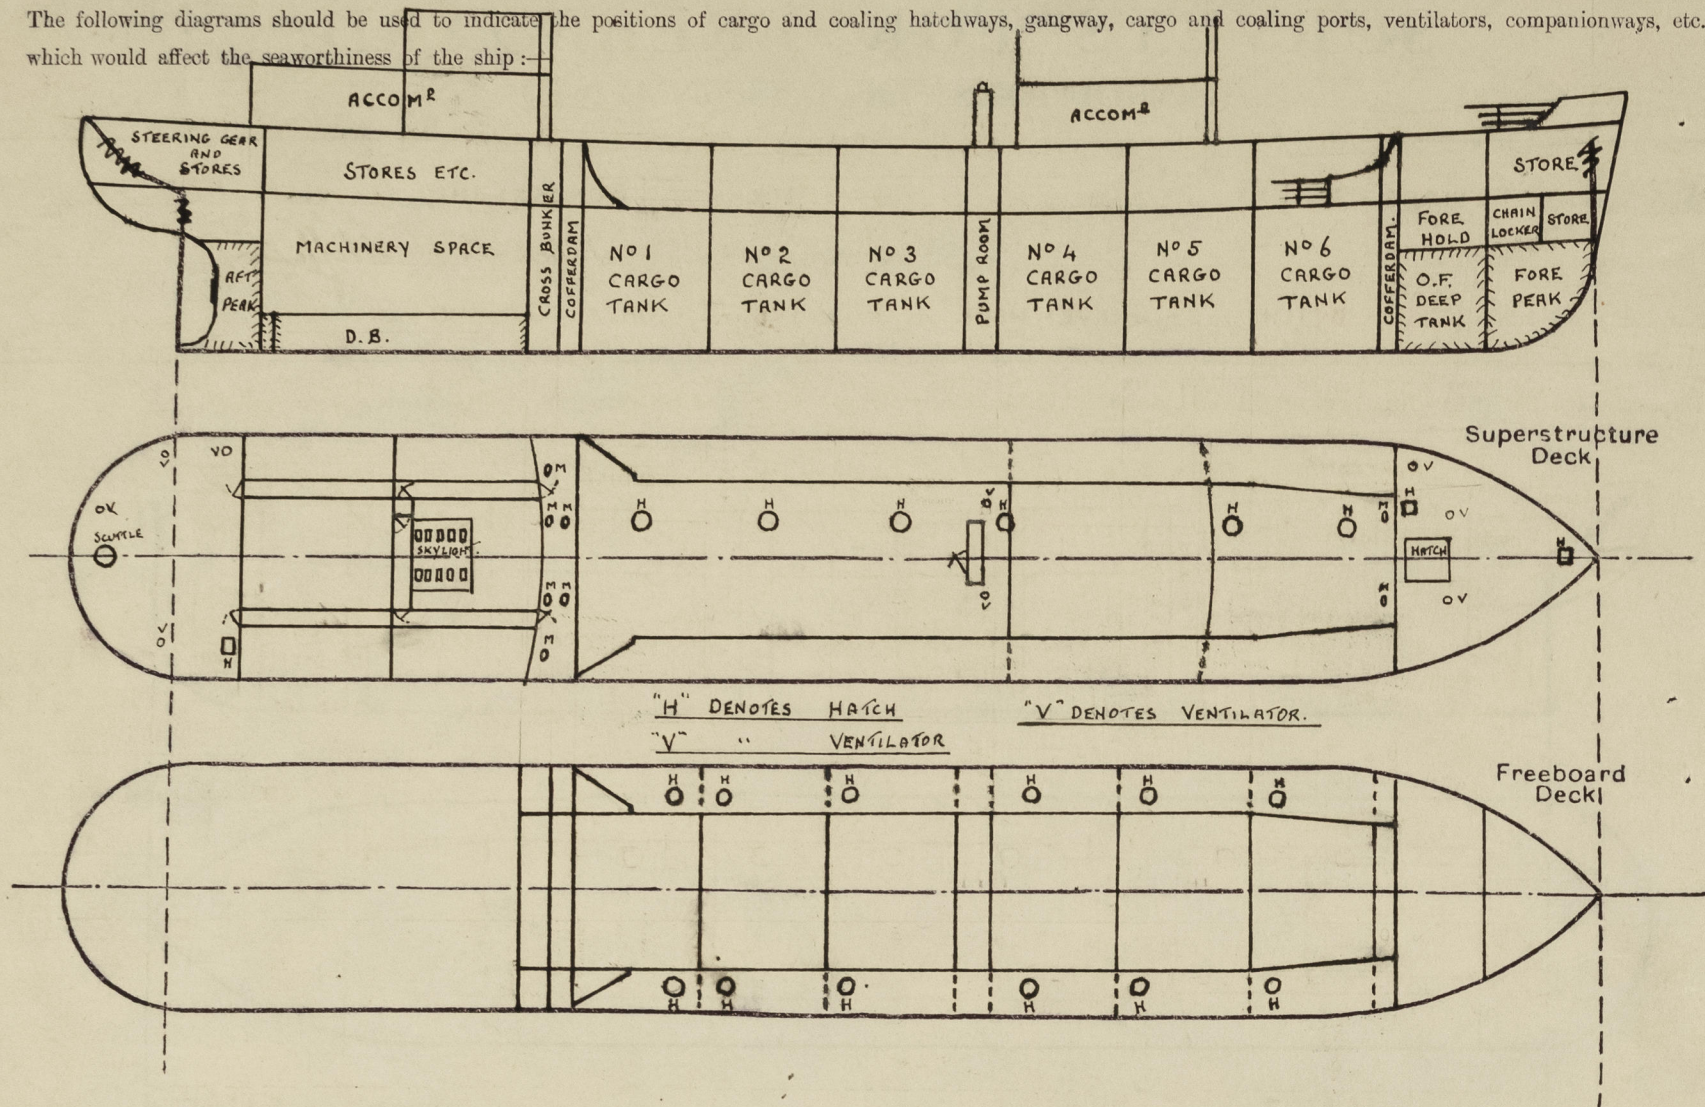

Particulars of fiddle, funnel and ventilator coamings, engine room skylight and other openings in machinery casing tops and their means of closing:-

FIDDLE OPENINGS CLOSED BY HINGED STEEL COVERS STRONGLY CONSTRUCTED.

FIDDLE, FUNNEL, AND VENTILATOR COAMINGS ARE STRONGLY CONSTRUCTED AND IN EFFICIENT CONDITION.

ENGINE ROOM SKYLIGHT OF STEEL STRONGLY CONSTRUCTED.

Particulars of Flush ~~Deck~~ Scuttles:-

SCUTTLE ON POOP DECK TO ROPE AND HAWSER STORE 305 mm DIAMETER WITH 152 x 11 mm COAMING. 10 mm STEEL WATERTIGHT COVER SECURED BY STRONGBACK AND TOGGLE.

*hinged?*

Particulars of Companionways:-

STEEL HOUSE ON TRUNK TOP AMIDSHIPS TO PUMPROOM 2,946 x 1,829 M. X 2,134 M. HIGH 8 mm PLATING, STIFFENERS 102 x 76 x 9 mm O.R. 1 OPENING 1,524 x 762 mm SILL 508 mm HIGH CLOSED BY HINGED STEEL WATERTIGHT DOOR CAPABLE OF BEING OPERATED FROM BOTH SIDES. STRONGLY CONSTRUCTED STEEL SKYLIGHT ON TOP.

Particulars of Ventilators in exposed positions on freeboard and superstructure decks:-

2	DERRICK POST VENTS	ON TRUNK TOP TO MIDSHIP PUMPROOM	610 mm DIA.	8,382 M HIGH.	EFFICIENTLY STRYED.
1	VENT	ON FORECASTLE DECK	254 mm DIA.	COAMING 914 x 8 mm	LED TO FORE PEAK STORE.
2	"	"	"	"	FORE HOLD.
1	"	"	"	"	FORE PUMP ROOM.
1	"	POOP	229 mm	"	FRIDGE SPACE
3	"	"	152	"	STEERING GEAR SPACE AND ROPE STORE.

ALL VENTILATOR COAMINGS ARE EFFICIENTLY CONSTRUCTED AND CLOSED BY GASTIGHT STEEL PLUGS OR WOOD PLUGS AND CANVAS COVERS.

Particulars of Air Pipes in exposed positions on freeboard, raised quarter, or superstructure decks:-

1	AIR PIPE	ON POOP DECK	762 mm HIGH x 63 mm DIAMETER	FROM RUDDER TRUNK.
2	"	"	" x 51 "	FW. TANK.
2	"	"	" x 76 "	DRY SPACE IN POOP.
2	"	"	1,829	O.F. CROSS BUNKER. (CLIPPED TO CASING)
2	"	"	"	O.F. SETTLING TANKS.
2	"	"	1,219	AFTER COFFERDAM.
2	"	TRUNK DECK	762	FOR <sup>2</sup> "
2	"	FOCSLE	"	" DEEP TANK.
1	"	"	"	FORE PEAK TANK.

ALL AIR PIPES FROM OIL SPACES CLOSED BY DOUBLE GAUZE AND CANVAS COVERS. ALL OTHERS CLOSED BY WOOD PLUGS AND CANVAS COVERS.



Particulars of Gangway Cargo and Coaling Ports :—

NIL.

Felipes.

Particulars of Scuppers and Sanitary Discharge Pipes :—

THERE ARE NO OVERBOARD DISCHARGES FROM ENCLOSED SUPERSTRUCTURES OR SPACES BELOW THE FREEBOARD DECK. ✓  
SCUPPERS AND SANITARY DISCHARGES FROM ACCOMMODATION ON POOP AND AMIDSHIPS FITTED WITH  
GUNMETAL STORM VALVES. ✓  
ON THE UPPER DECK IN THE WELLS THERE ARE 4 SCUPPERS PORT SIDE AND 4 STARBOARD SIDE THROUGH  
THE GUNWALE ANGLE. EACH 102 x 51 mm. ✓

Particulars of Side Scuttles :—

6 SIDE SCUTTLES PORT SIDE AND 6 STARBOARD SIDE, IN POOP SPACE. EACH 305 mm DIAMETER. ✓  
STRONGLY CONSTRUCTED IN ACCORDANCE WITH RULE REQUIREMENTS AND FITTED WITH CAST STEEL DEADLIGHTS. ✓

Vertical distance of Sill of lowest Side Scuttle above top of keel

7,163 m. ✓

Particulars of Guard Rails :—

Particulars of Gangways, Lifelines, etc. :—

GUARD RAILS ON FREEBOARD DECK 914 mm HIGH. 3 RODS WITH STANCHIONS SPACED 1,448 M. APART. ✓  
" " " TRUNK TOP " " " " " " " " " " ✓  
" " " FORECASTLE DECK " " " " " " " " " " ✓  
" " " POOP DECK " " " " " " " " " " ✓

Particulars of Freeing Arrangements.

	Length of Bulwark	Height of Bulwark	Size of Freeing Ports	Number each side	Area each side	Rule area each side
After Well ... ..	} OPEN RAILS. ✓					
Forward Well ... ..						

State position of each freeing port ... .. { After Well :—  
(F. and A. position and height above deck edge) { Forward Well :—

State whether the freeing ports are fitted with shutters, bars, or rails, and give particulars of such :—

Additional area where sheer is less than standard.



© 2021


Lloyd's Register  
Foundation



PARTICULARS OF PROTECTION TO OPENINGS, ETC.

HATCHWAYS ON FREEBOARD AND SUPERSTRUCTURE DECKS.									
Description of Hatchway	...	...	...	HATCH TO					
Dimensions of Hatchway	...	...	...	FORE HOLD					
COAMINGS	Height above Deck	...	...	2,438 M.					
	Thickness	{	Sides	762 mm					
	Stiffeners		Ends	11 mm					
	Brackets, Stays		...	9 mm FLANGED					
				BKT. ON ALL FOUR SIDES.					
HATCH BEAMS	Number	...	...						
	Spacing	...	...						
	Scantling and Sketch	...	...	✓					
FORE AND AFTERS	Bearing Surface	...	...						
	Number	...	...						
	Spacing	...	...	✓					
HATCH COVERS	Material	...	...	STEEL					
	Thickness	...	...	GASTIGHT 11 mm THICK					
	How fitted	...	...	WITH 2 BULB PLATE					
	Bearing Surface	...	...	STIFFENERS 178 x 9 mm					
Spacing of Cleats	...	...	...	HINGED AND SECURED					
Number of Tarpaulins	...	...	...	BY TOGGLES AS APPROVED.					
*Are wood fore and afters steel shod at all bearing surfaces? Are battens and wedges efficient and in good condition? Are tarpaulins in good condition and in accordance with rule requirements? Are lashings provided in accordance with rule requirements?									

Particulars of any special features:—

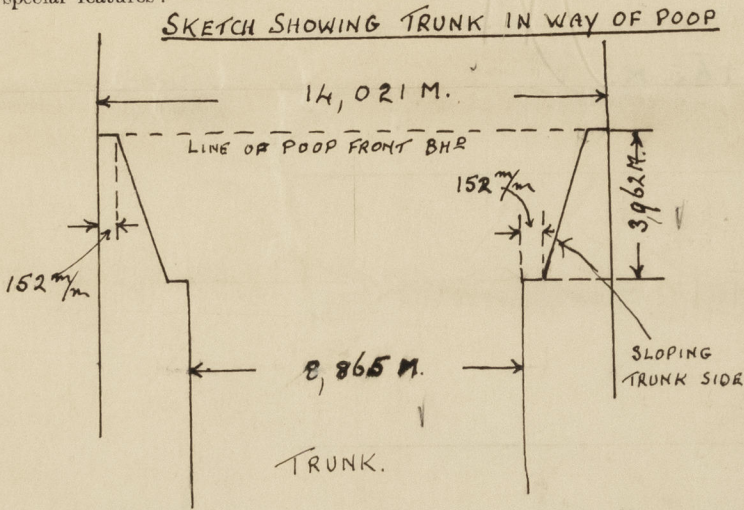

FOR PARTICULARS OF TONS PER INCH IMMERSION AND DISPLACEMENT ETC. SEE ATTACHED PLAN.

Endorsement at first survey and at surveys for renewal of Certificate:—

The fittings and appliances are in accordance with the particulars shown on this form (or as now modified) and are in good condition.