


Nº 697

DIMENSIONS - 630'-0" B.P. x 82'-0" x 47'-6" MLD. TO "E" DECK.

TO CLASS + 100 A.I. WITH FREEBOARD.

DECK PLANS - SHEET Nº 2.

SCALE :- 1/16 INCH = 1 FOOT.

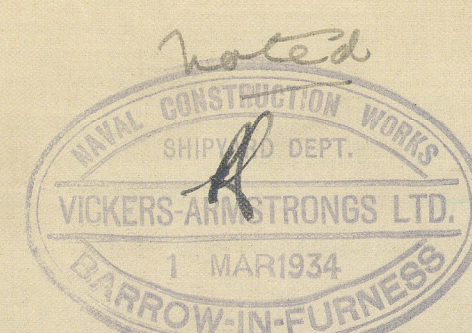

"F" DECK.

"F" DECK.

"G" DECK.

"G" DECK.

"H" DECK.

"H" DECK.

"J" DECK.

PLAN Nº 49

004285 - 004291 - 0054

27. 2. 34

VICKERS- ARMSTRONGS
No 697 & 712

DECK PLANS - SHEET 2


Lower Decks F.G.H.

T.S.S. Orion - Barrow I.E. Rpt 2576

T S S ORCADES
BARROW REPORT 2662

RETAIN

PLAN NO. 11

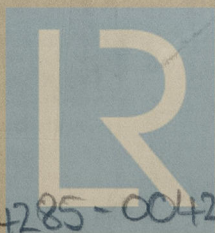

© 2020

Lloyd's Register
Foundation

004285-004291-0054