


S.S. "DALVANGEN"

REC'D NEW YORK JUL 11 1932

Provisions made for carrying and securing timber cargoes on deck.

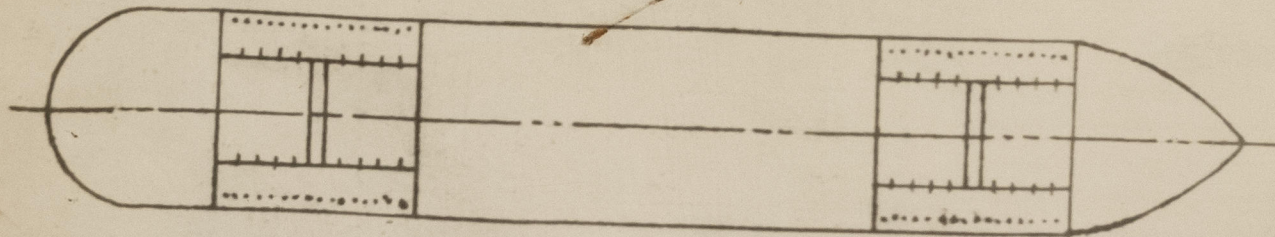

16 Sockets for uprights fitted.
 Bulwark rail drilled to take
 straps for uprights.
 4 Eyepads fitted to each hatch coaming.
 Bulwark stays drilled to take
 shackles for lashings.
 No eyeplates fitted to sheer strake.
 6 Eye pads fitted on stringer plate.

16 Sockets for uprights fitted.
 Bulwark rail drilled to take
 straps for uprights.
 4 Eyepads fitted to each hatch coaming.
 Bulwark stays drilled to take
 shackles for lashings.
 No eye plates fitted to sheer strake.
 6 Eye pads fitted on stringer plate.

© 2020

Lloyd's Register
Foundation

H. W. Wood,

004285-004291-0250

L from F.P. ...	2			2	
L " ...	4			4	

" " alt or " =