


N<sup>o</sup> 546.

PROFILE & DECK PLANS.

SCALE:  $\frac{1}{8} = 1$  FOOT.

DIMENSIONS 220'-0" x 35'-0" x 16'-6" [TO UPPER DECK]

ALEXANDER STEPHENSON & SONS LTD  
SHIPBUILDERS  
PLANS 2 ENGINEER  
DATE 15-10-34 GLASGOW

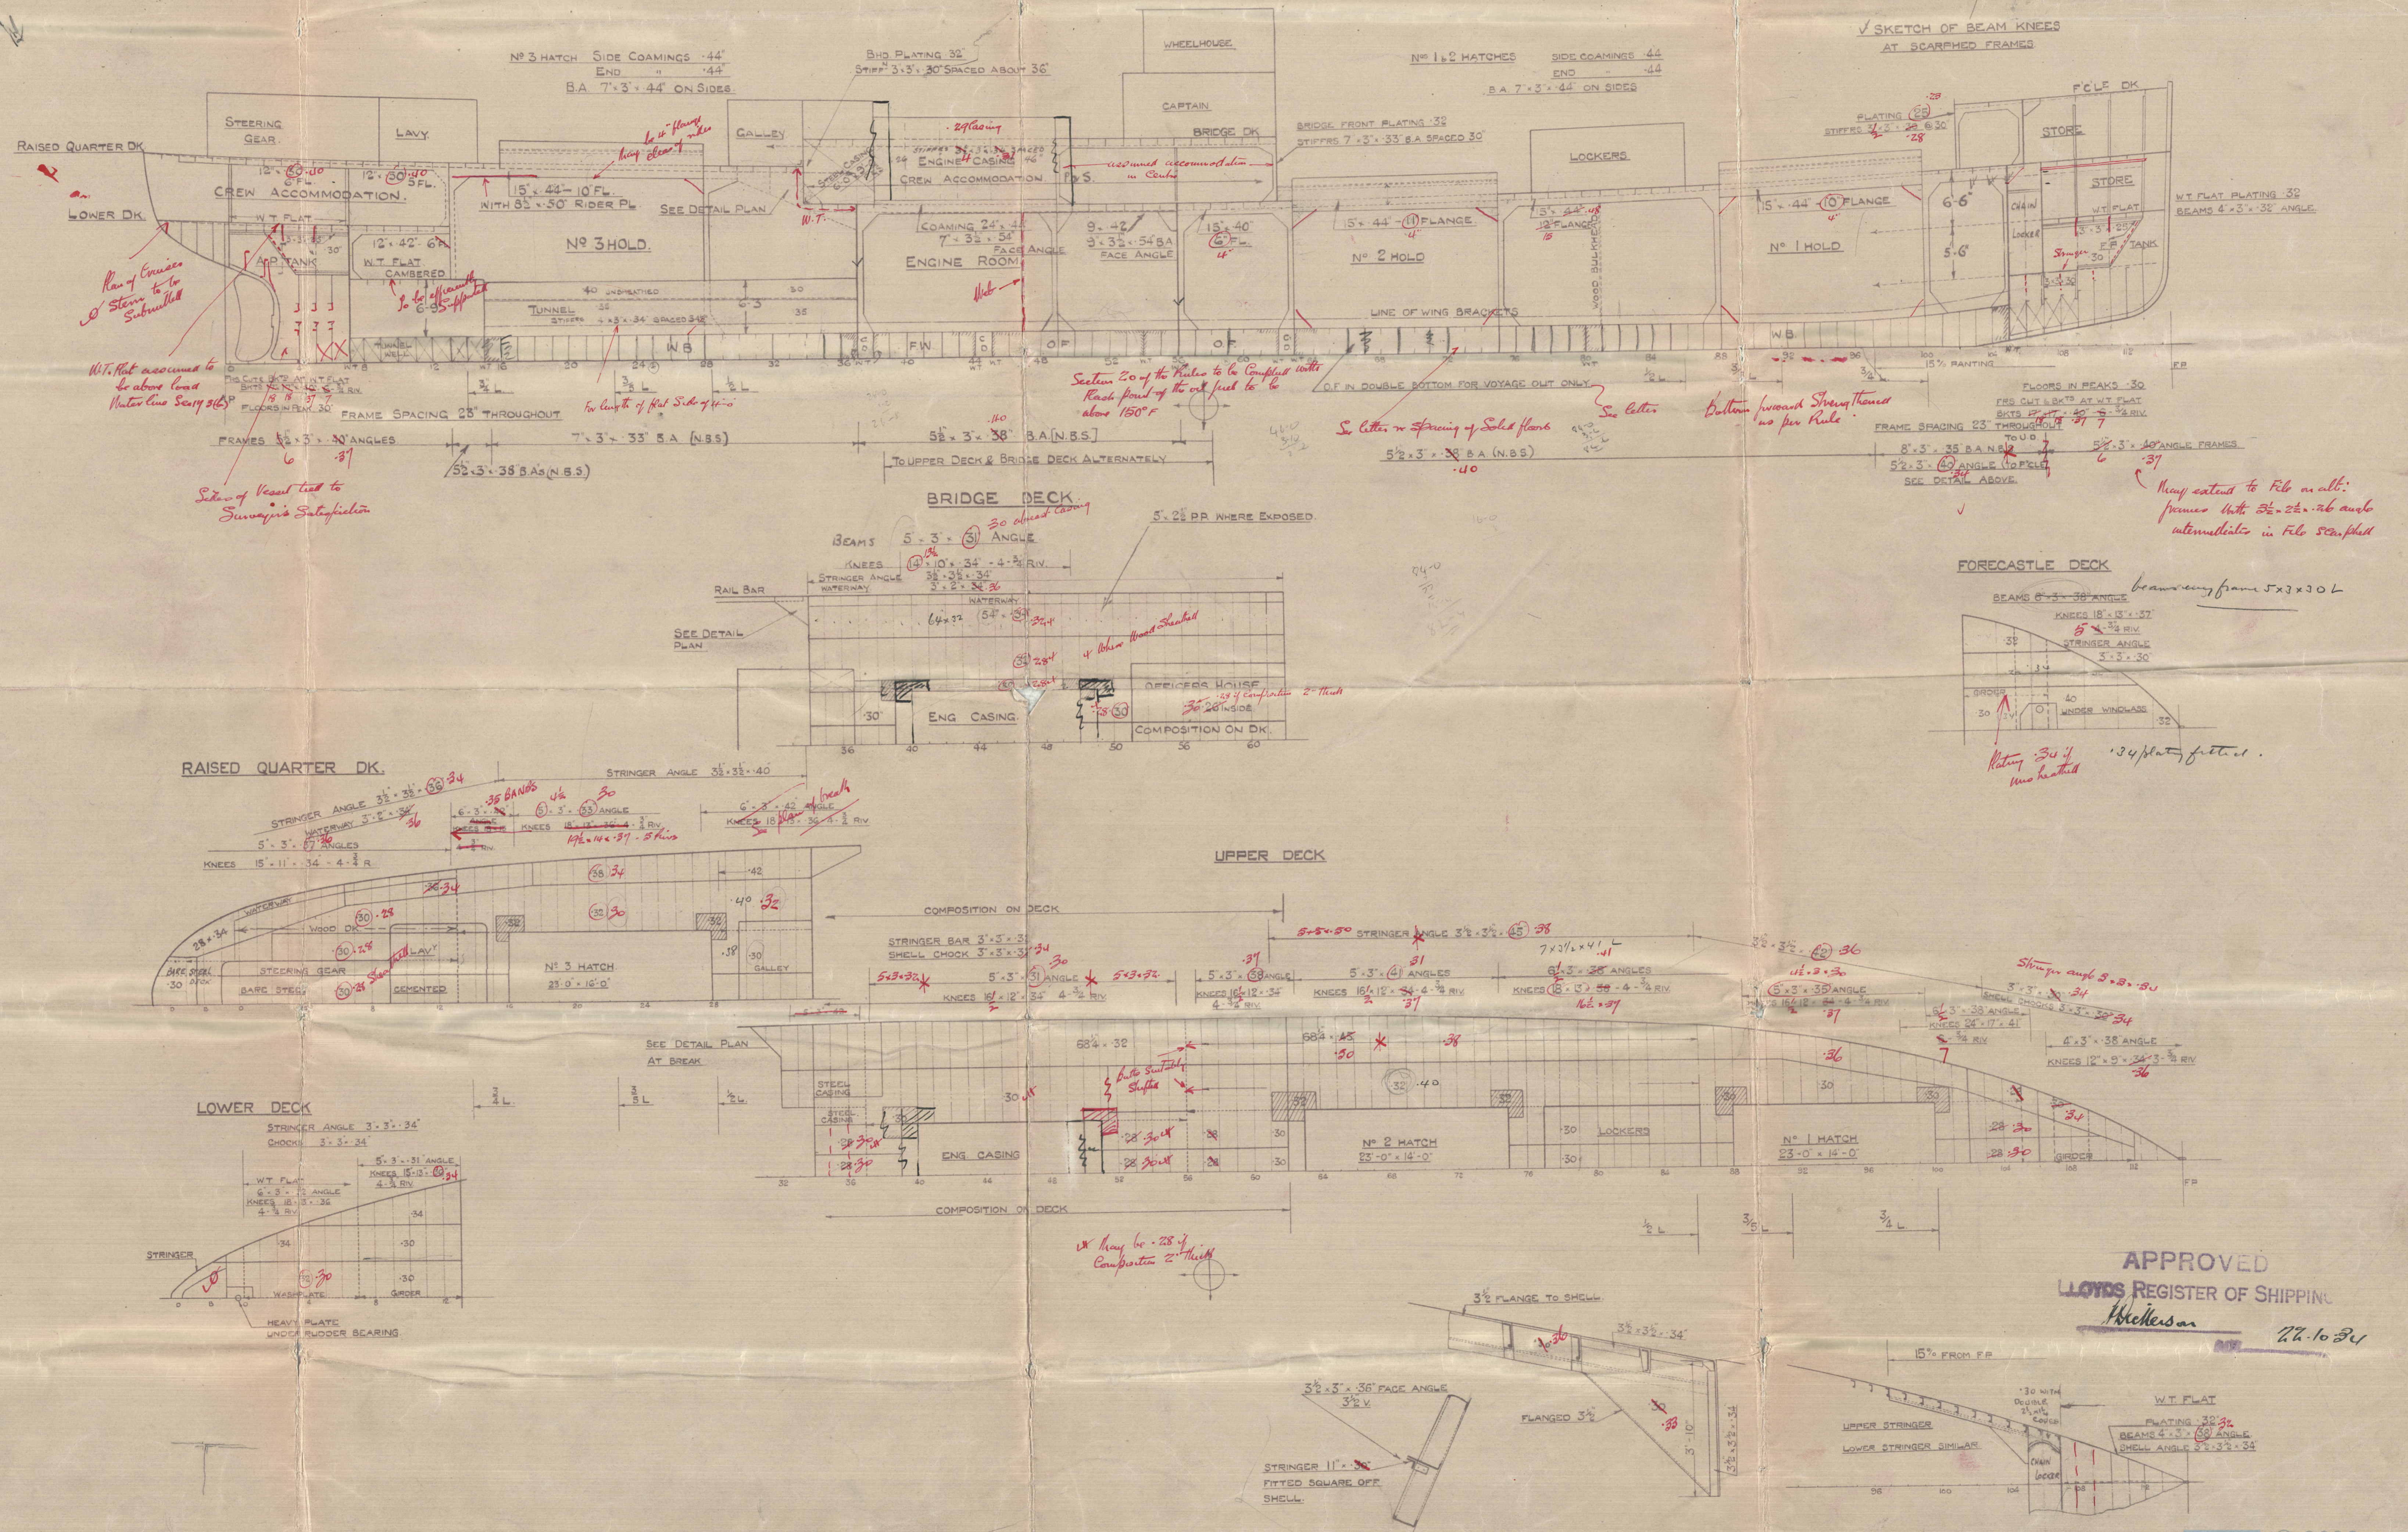

APPROVED  
LLOYD'S REGISTER OF SHIPPING  
Wickham  
27.10.34

Glasgow

Alex. Stephen & Sons Ltd.

No 546

PROFILE & DECKS.

EX KARU

N/N DOROTHIE

W/S 848

Prelim Gld


GLASGOW/<sub>h</sub>REPORT No. 55089

Gld

GLASGOW/<sub>h</sub>REPORT No. 55847

Karu

GLASGOW REPORT No. 55933

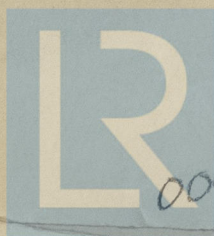

© 2020

Lloyd's Register  
004300-004307-0167  
Foundation