

1 - APR 1952

Rpt. C. 11 (Contd.)

Index No.

Lloyd's Register of Shipping.


NALANDA

Ship's Name *EX* "MAHADEVI"

Official No. 169579

Memorandum of alterations reported since ship was surveyed for assignment of Load Lines in


ALTERATIONS TO TWEEN DECK HATCH COAMINGS ETC ON CONVERSION TO OIL FUEL 1952

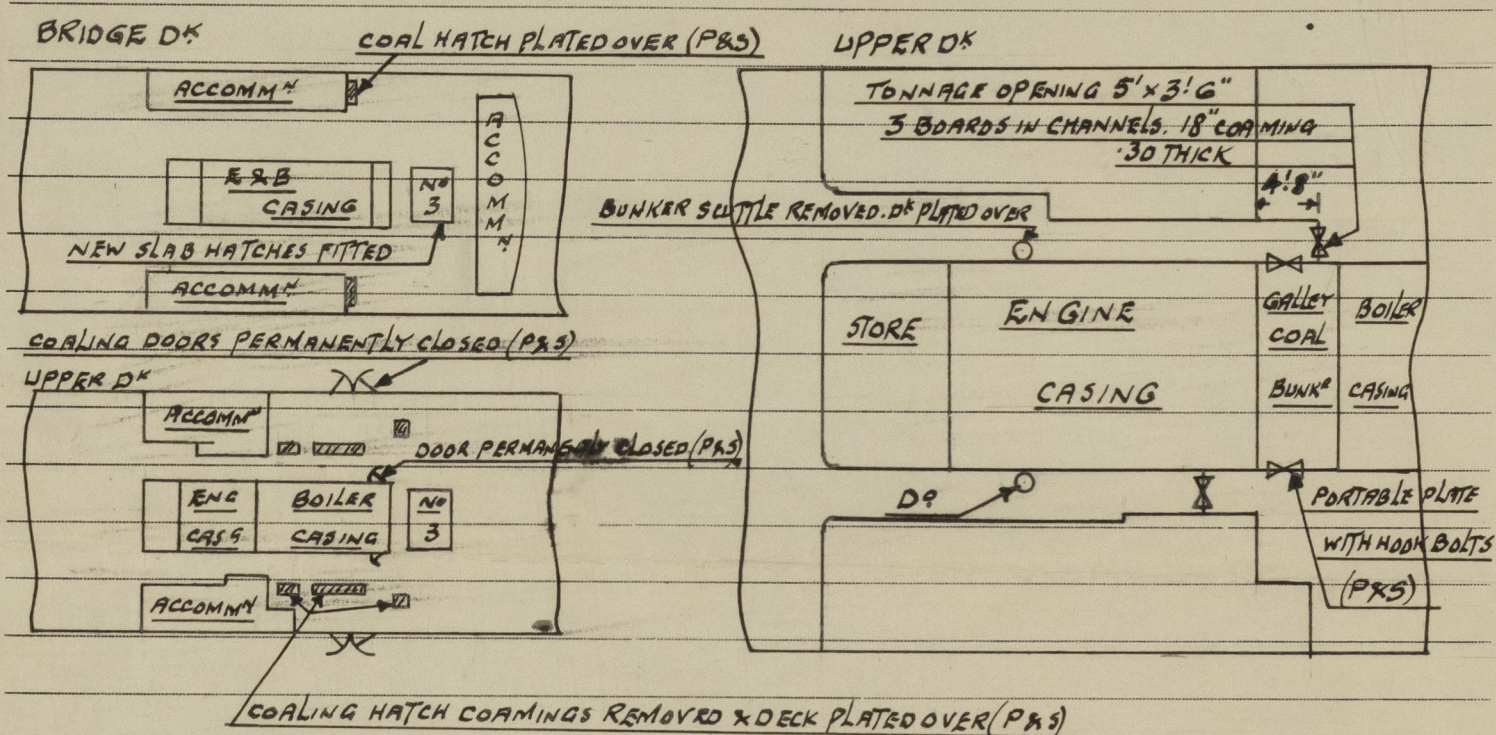

SEE GREENOCK REPORT NO 22392

Noted

APR 1952

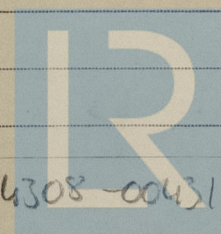

© 2020

Lloyd's Register Foundation