

TO CLASS BS * WITH FREEBOARD UNDER SPECIAL SURVEY
THE SCANTLINGS ARE SUITABLE FOR A DRAUGHT 18" IN EXCESS OF THAT CORRESPONDING
TO THE FREEBOARD WHICH COULD BE ASSIGNED TO THE VESSEL UNDER TONNAGE SURVEY

TANK MARGIN VERT. ANGLES REINFORCED IN WAY OF CANTILEVERS ALSO AT EVERY FRAME

RETAIN

24

Midship Section

Harland & Wolff Ltd


Skotia No 1168a

Reference $\frac{21}{12}$ 42

6x Argoe Still

EX EMPIRE TORRENT


Mr Lumbull
London

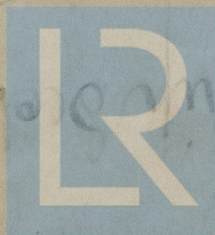

© 2021

Lloyd's Register
Foundation

004358-004363-0099

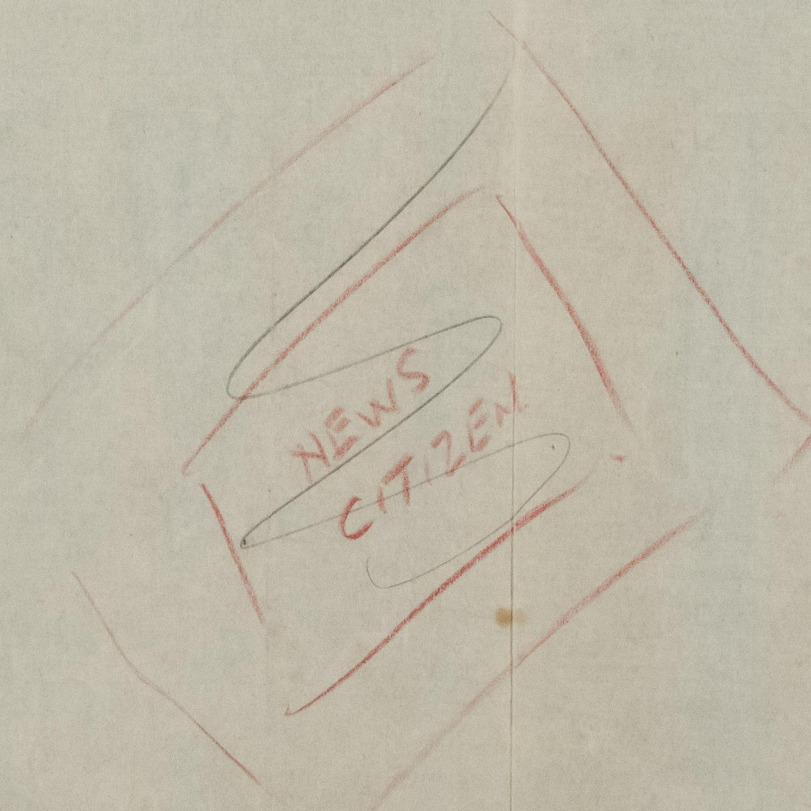

© 2021

Lloyd's Register
Foundation

004358-004363-0099