
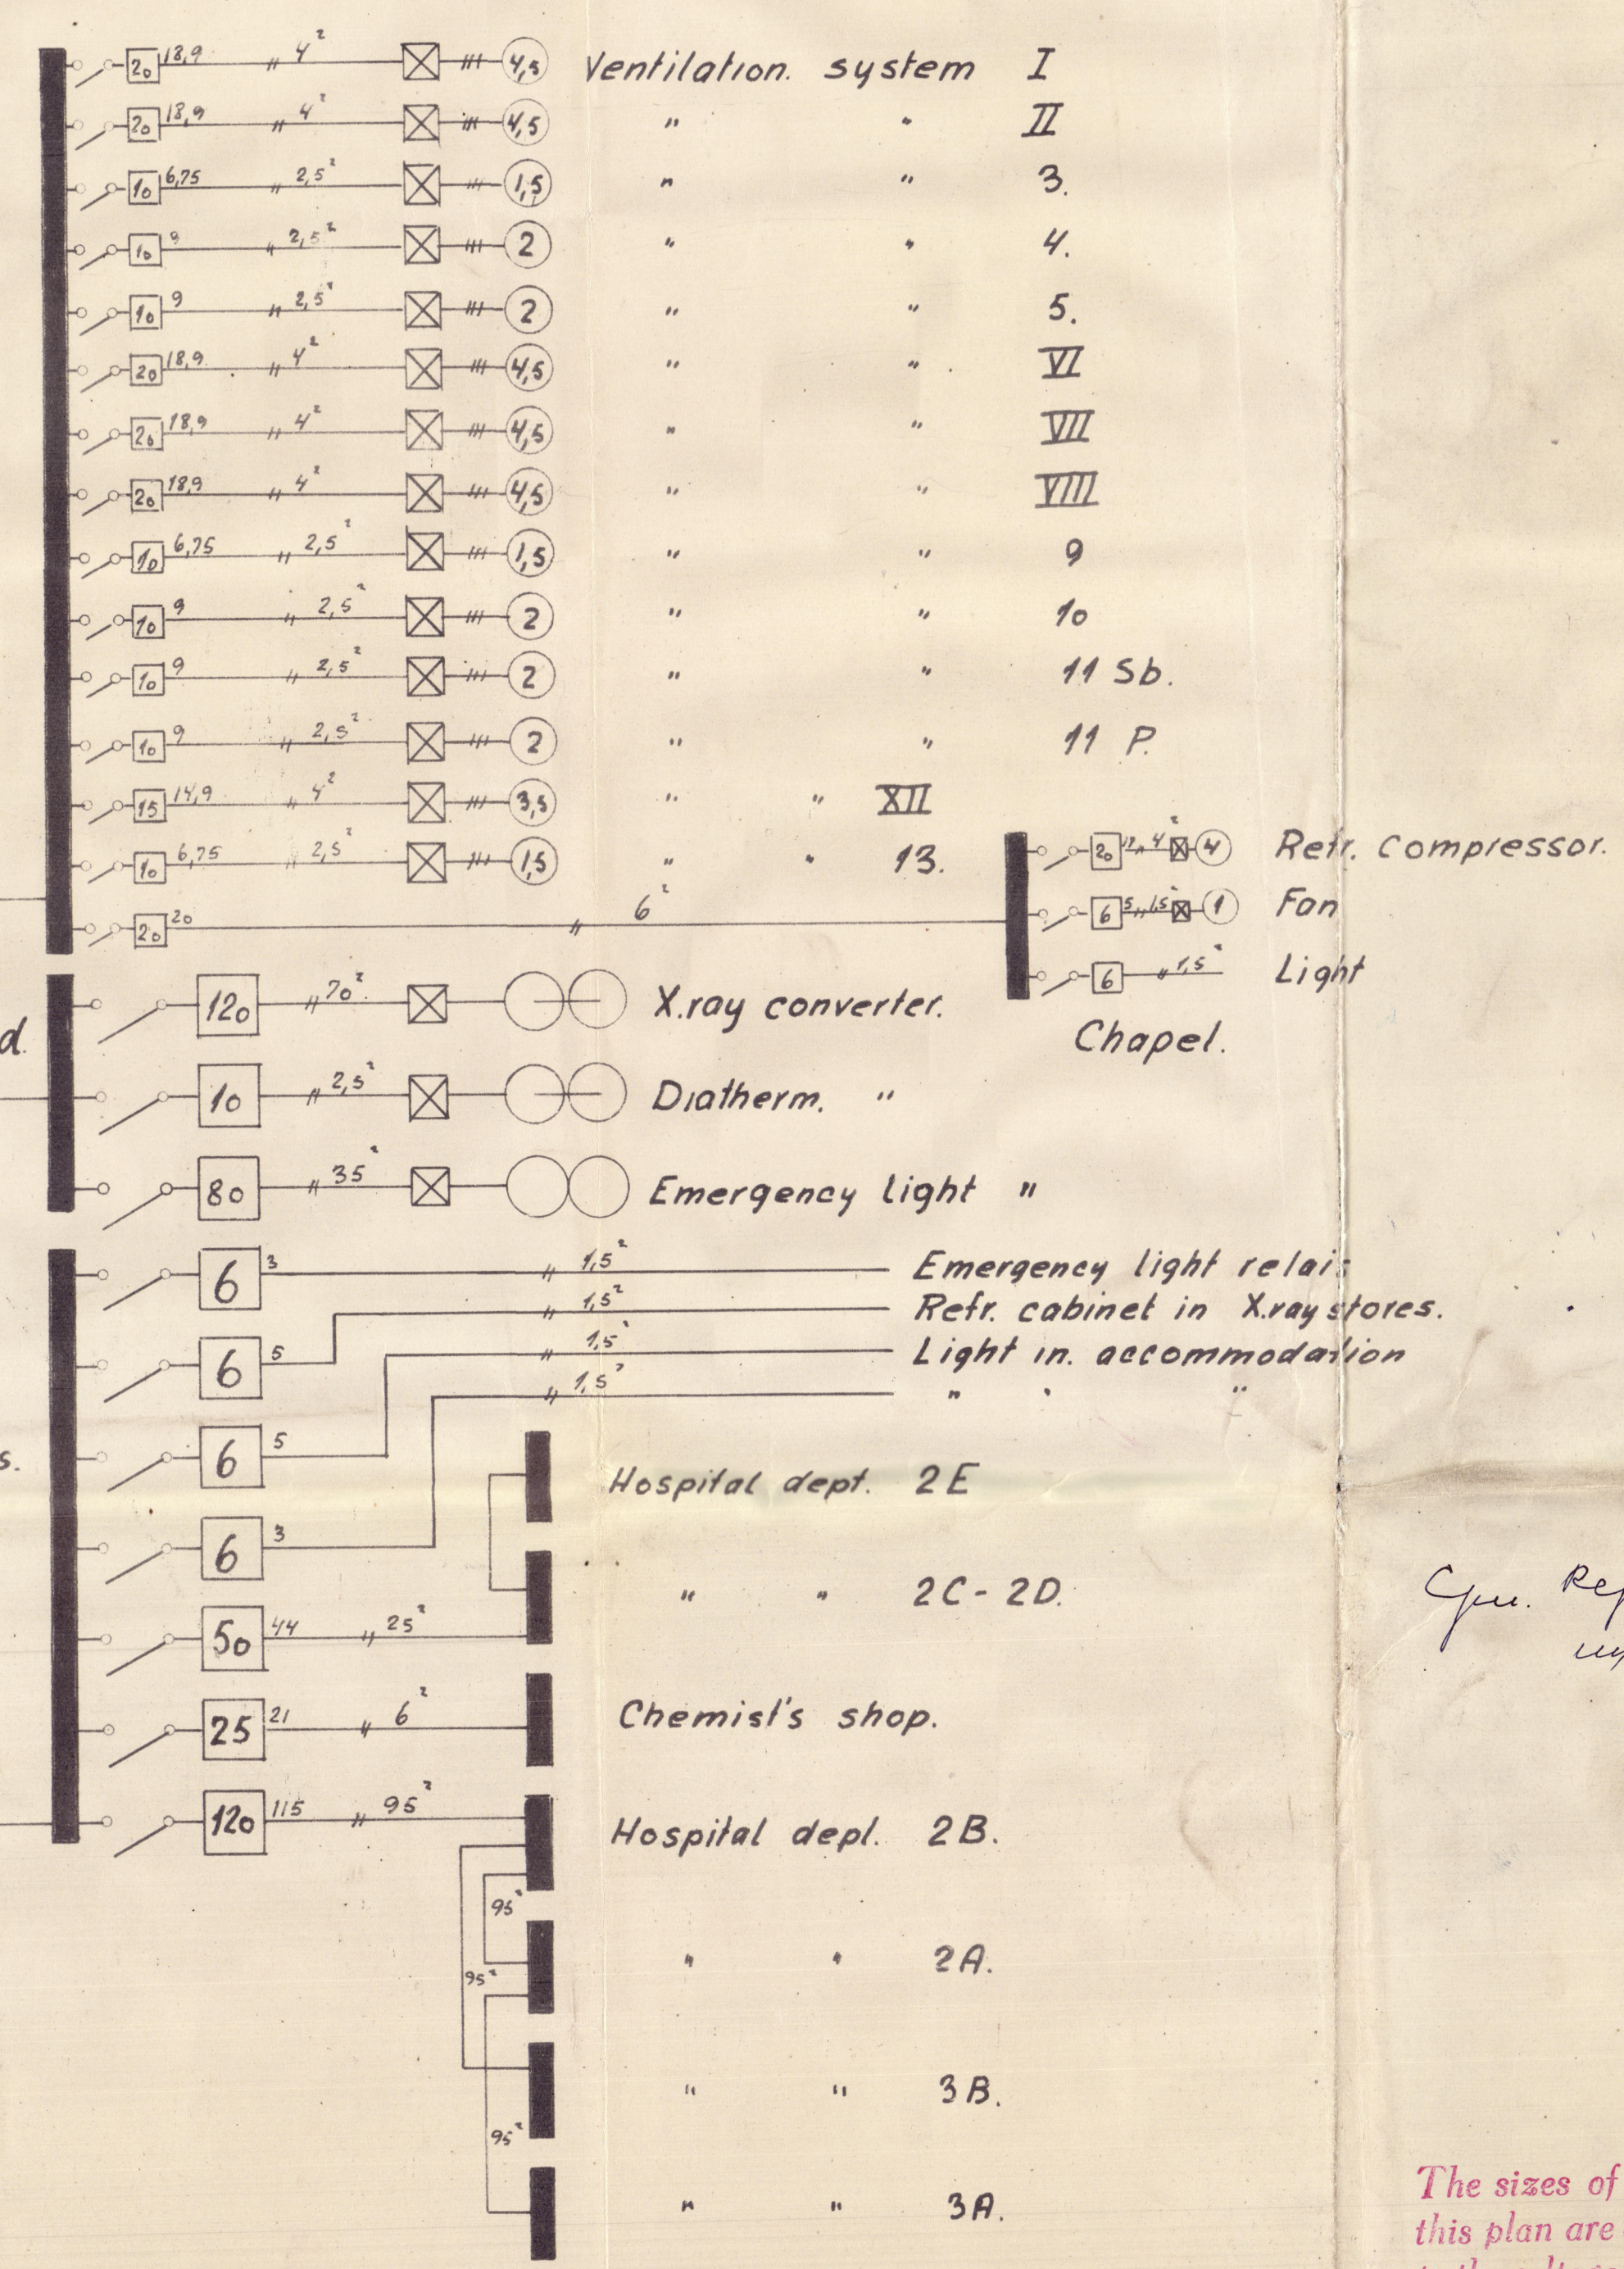


24 NOV 1950

N 4309
SF

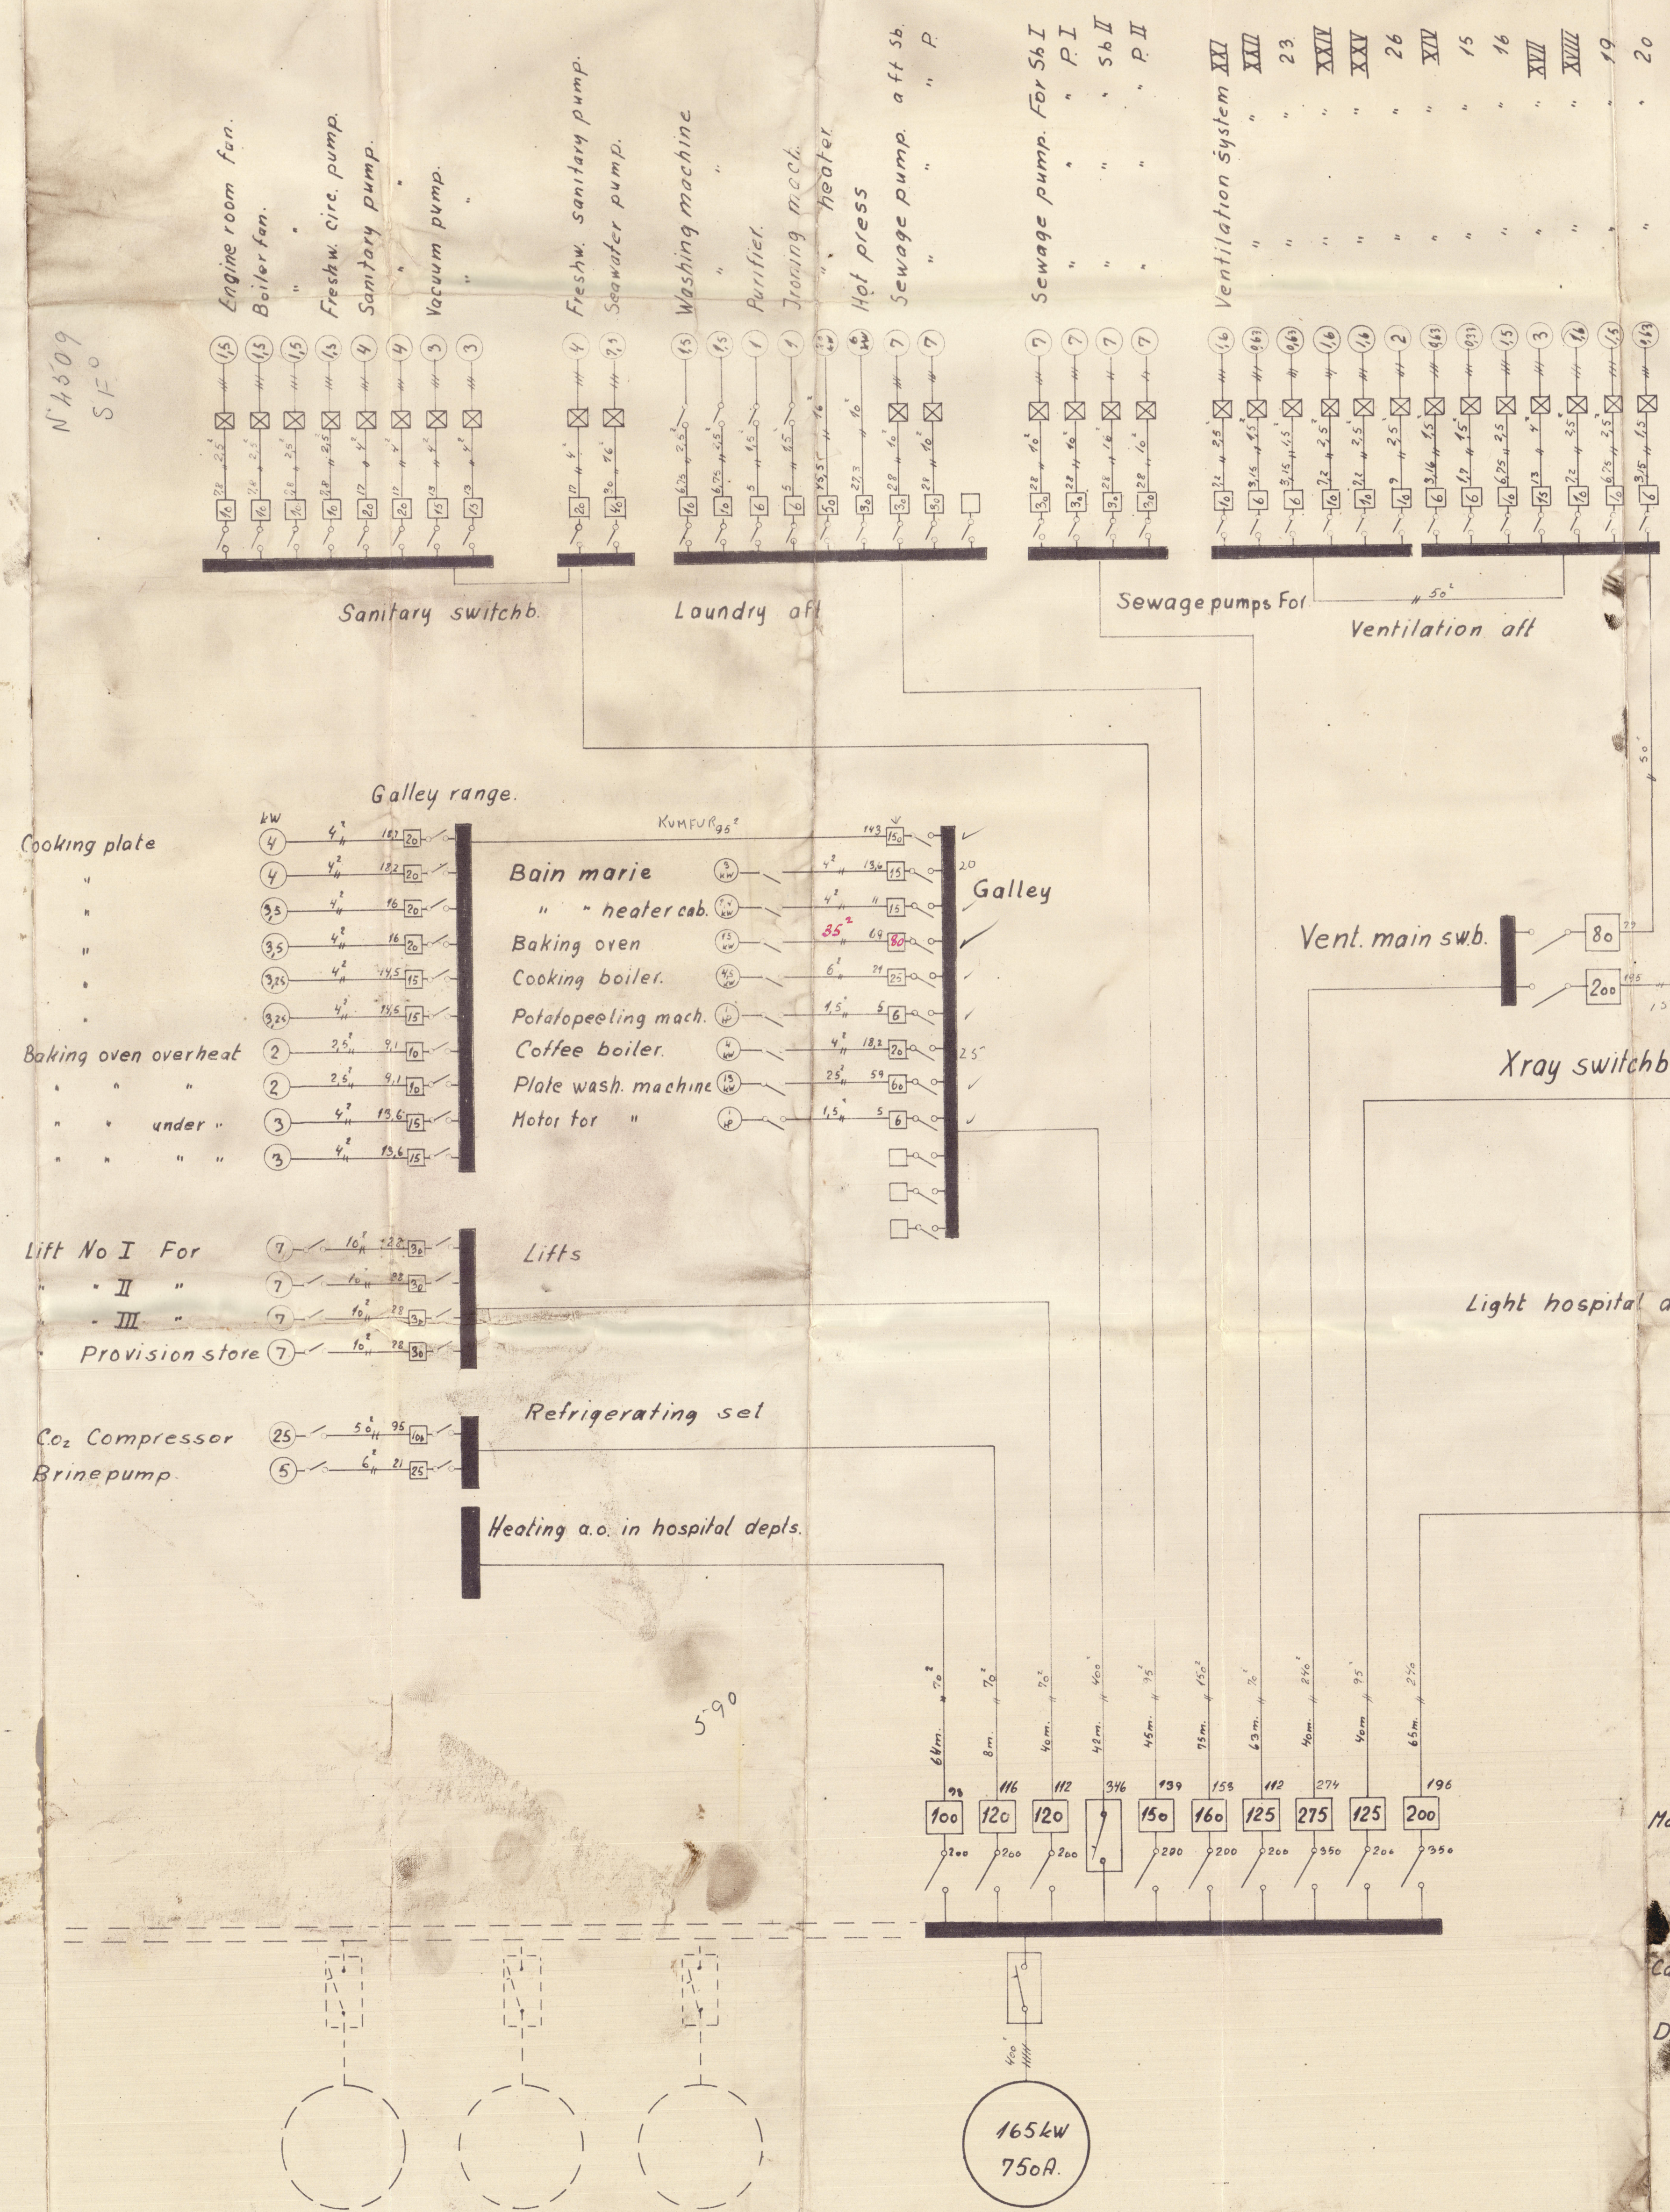

Main switchboard.
Front plate of steel. Back connections, fuses and switches are to be placed on 'Sindanyo' panels. All insulated material, section board panels of 'Sindanyo'. Fuses of danish 'LX' type. Insulating bushes of 'Etronax'. Above 300 A. circuit breakers are used.


Cables.
Cables used are lead covered vulcanized, armoured rubber insulated cables. Diagram of the old equipment, see approved drawing No 6557 dated 3-2-1934.

M/s "Jutlandia"
Rebuilding to hospitalship.
Diagrammatic plan of electr. equipment.

Gen. Report No. 13353
M/s Jutlandia

The sizes of cable shown on this plan are approved subject to the voltage drop being found on test not to exceed that permitted by the Rules for Electrical Equipment.

50
23/11/50

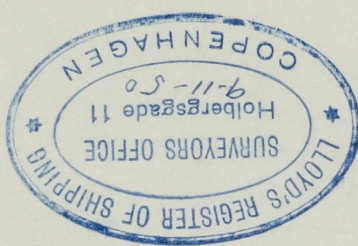

Please No. R. 901-7.H.
 Diagrammatic plan of
 electric equipment
 for
 "Tutlandia"

"Tutlandia"

Diagrammatic plan of
 electrical equipment

bpn. 13353.



© 2021

Lloyd's Register
 Foundation

004387-004393-0186