

M.V. "ATHELBEACH"

PROFILE & DECKS


SCALE: 1/8" = ONE FOOT



DIMENSIONS: 450'-0" L.B.P. x 61'-0" B.M.L.D. x 31'-0" D.M.L.D. TO UPPER DECK.

TO CLASS 100 A.I. AT LLOYDS FOR CARRYING MOLASSES
OR PETROLEUM IN BULK. "LONGITUDINAL FRAMING"

ALL BULB ANGLES AND CHANNELS ARE N.B.S.

 

Ship no 700

40

R. & W. HAWTHORN, LESLIE
& CO. LTD.

Profile & Decks (as fitted)

'ATHELBEACH' ★


SHIP NO. 700

NEWCASTLE - on - TYNE

No 107636.

RECORDS DEPT.
LONDON

4

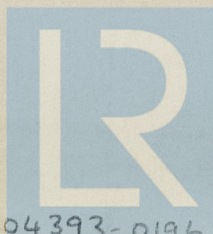

© 2021

Lloyd's Register
Foundation

004387-004393-0196