

10 SEP 1942

Index No. 36970
(For London Office only).

No. 18329


Lloyd's Register of Shipping.

SURVEYS FOR FREEBOARD.

(CONDITIONS OF ASSIGNMENT.)

Ship's Name **"EMPIRE CENTAUR"** Port of Survey **WEST HARTLEPOOL**
 Official Number **168946** Surveyor's Signature **E. Lee.**
 Nationality and Port of Registry **BRITISH. WEST HARTLEPOOL** Date of Survey **Aug. 1942**
HONG KONG

Disposition and dimensions of superstructures, trunks, deckhouses and machinery casings to be inserted in the diagrams and tabular statement:—

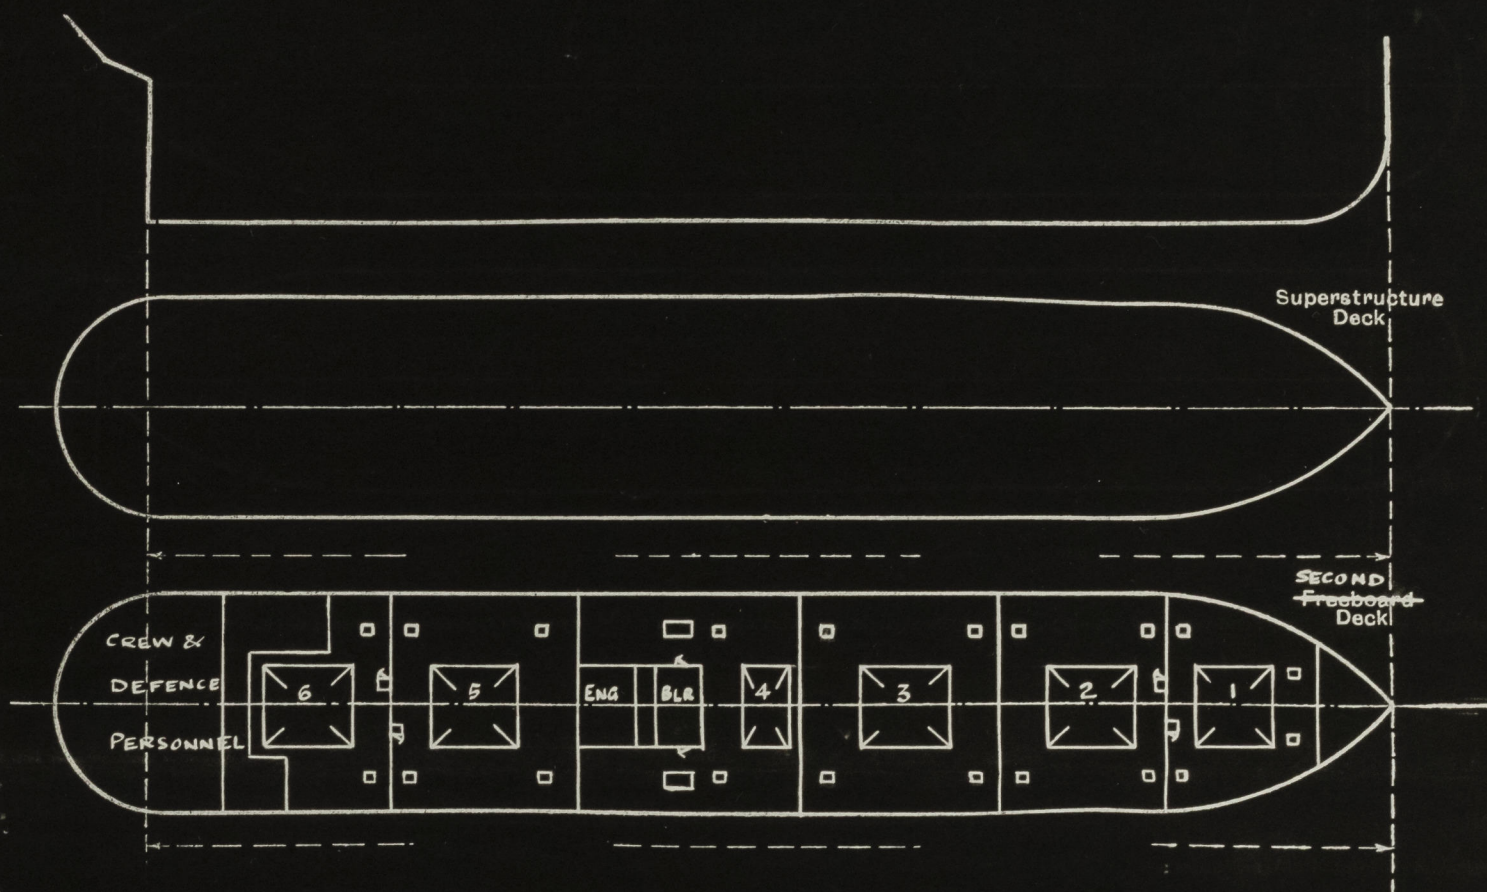

Particulars of Superstructures, Trunks, Casings, Deckhouses.

	Coaming	Plating	Stiffeners	Spacing	End Attachments of Stiffeners	Size of Openings	Height of Sills	Height of Casings
Poop Bulkhead								
Raised Quarter Deck Bulkhead ...								
Bridge, After Bulkhead								
Bridge, Forward Bulkhead								
Forecastle Bulkhead								
Trunk, Aft								
Trunk, Forward								
Exposed Machinery Casings on Freeboard or Raised Quarter Decks ...								
Exposed Machinery Casings on Superstructure Decks								
Machinery Casings within Superstructures not fitted with Class I Closing Appliances SECOND DECK ...	30"	26"	3" x 3" x .30" 3 1/2 x 3 x .40	31"	continuous	4'0" x 2'1"	24"	9'0"
Deckhouses on Flush Deck Ships ...								

Particulars of Closing Appliances (state if capable of being manipulated from both sides).

Poop Bulkhead	
Raised Quarter Deck Bulkhead ...	
Bridge, After Bulkhead	
Bridge, Forward Bulkhead	
Forecastle Bulkhead	
Exposed Machinery Casings on Freeboard or Raised Quarter Decks ...	
Exposed Machinery Casings on Superstructure Decks	
Machinery Casings within Superstructures not fitted with Class I Closing Appliances SECOND DECK ...	Hinged steel doors operated from both sides.
Deckhouses on Flush Deck Ships ...	




© 2020

Lloyd's Register
Foundation

PARTICULARS OF PROTECTION TO OPENINGS, ETC.

The following diagrams should be used to indicate the positions of cargo and coaling hatchways, gangway, cargo and coaling ports, ventilators, companionways, etc., which would affect the seaworthiness of the ship:—

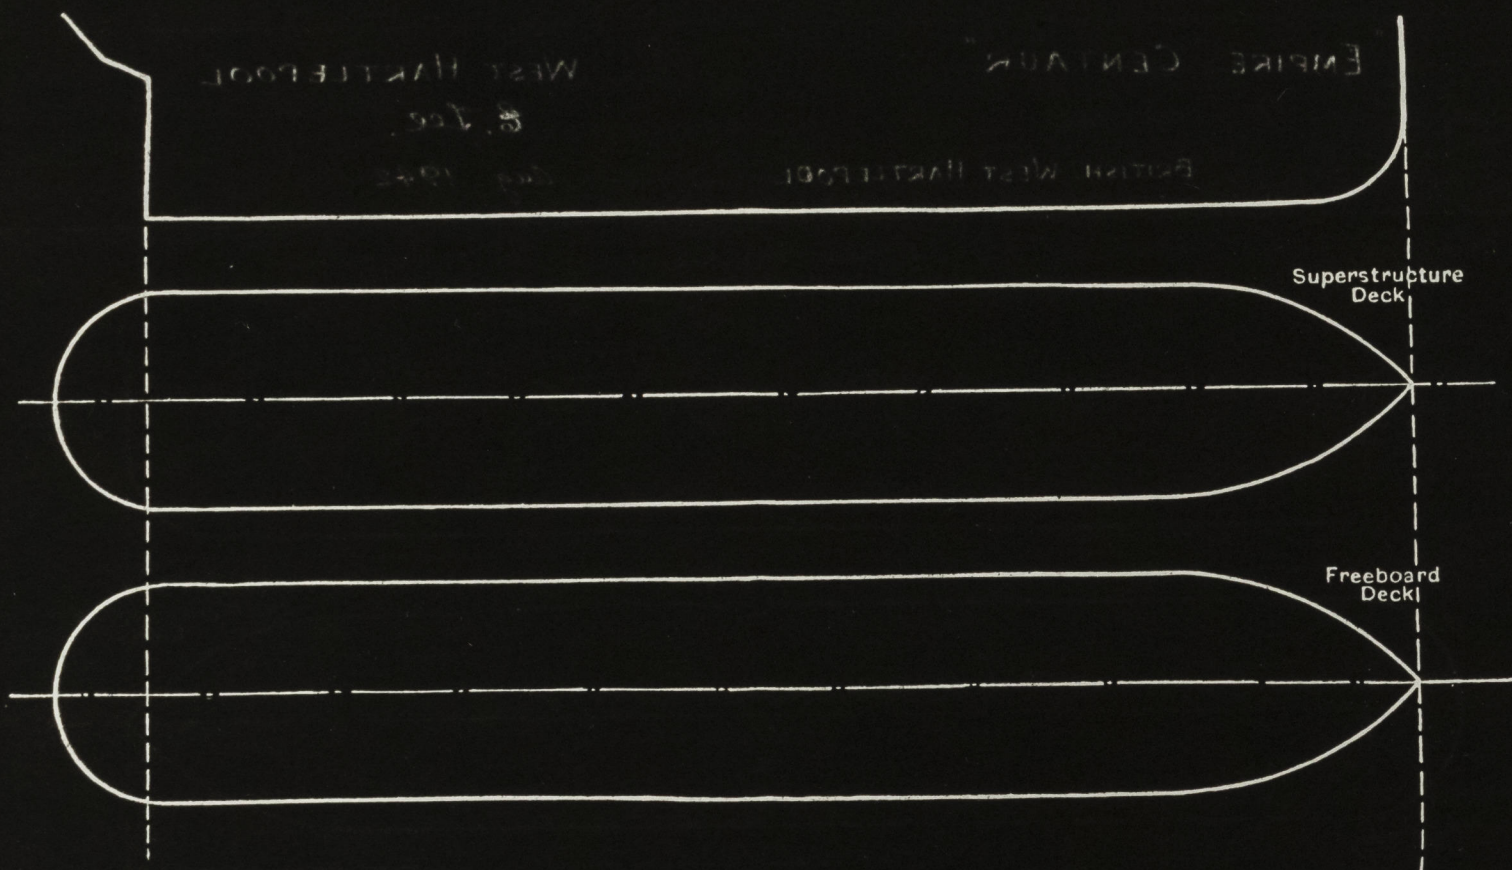

Particulars of fiddle, funnel and ventilator coamings, engine room skylight and other openings in machinery casing tops and their means of closing:—



Particulars of Flush Bunker Scuttles:—



Particulars of Companionways:—

Entrance on 2nd deck to holds
and up to mast houses on upper
deck. Hinged steel doors operated
from both sides 4'-0" x 1'-9"
sills 24"

Particulars of Ventilators in exposed positions on freeboard and superstructure decks:—



Particulars of Air Pipes in exposed positions on freeboard, raised quarter, or superstructure decks:—



© 2020

Lloyd's Register
Foundation