





S.S. "TEMPLE ARCH"

PUMPING PLAN

SCALE - $\frac{1}{8}" = 1 \text{ FT}$

HIGH & LOW SUCTIONS TO BE FITTED TO ALL THREE
O.F. SETTLING TANKS & ALSO WITH SELF CLOSING DRAIN COCKS
POSITIONS OF BULKHEAD PIECES TO BE LINED OFF
BY ENGINEERS.

AIR PIPES TO BE 18" ABOVE OR TO UNDER SIDE OF OPENING
AIR PIPES TO O.F. TANKS TO HAVE WIRE GAUZE
FITTED OVER OPENINGS

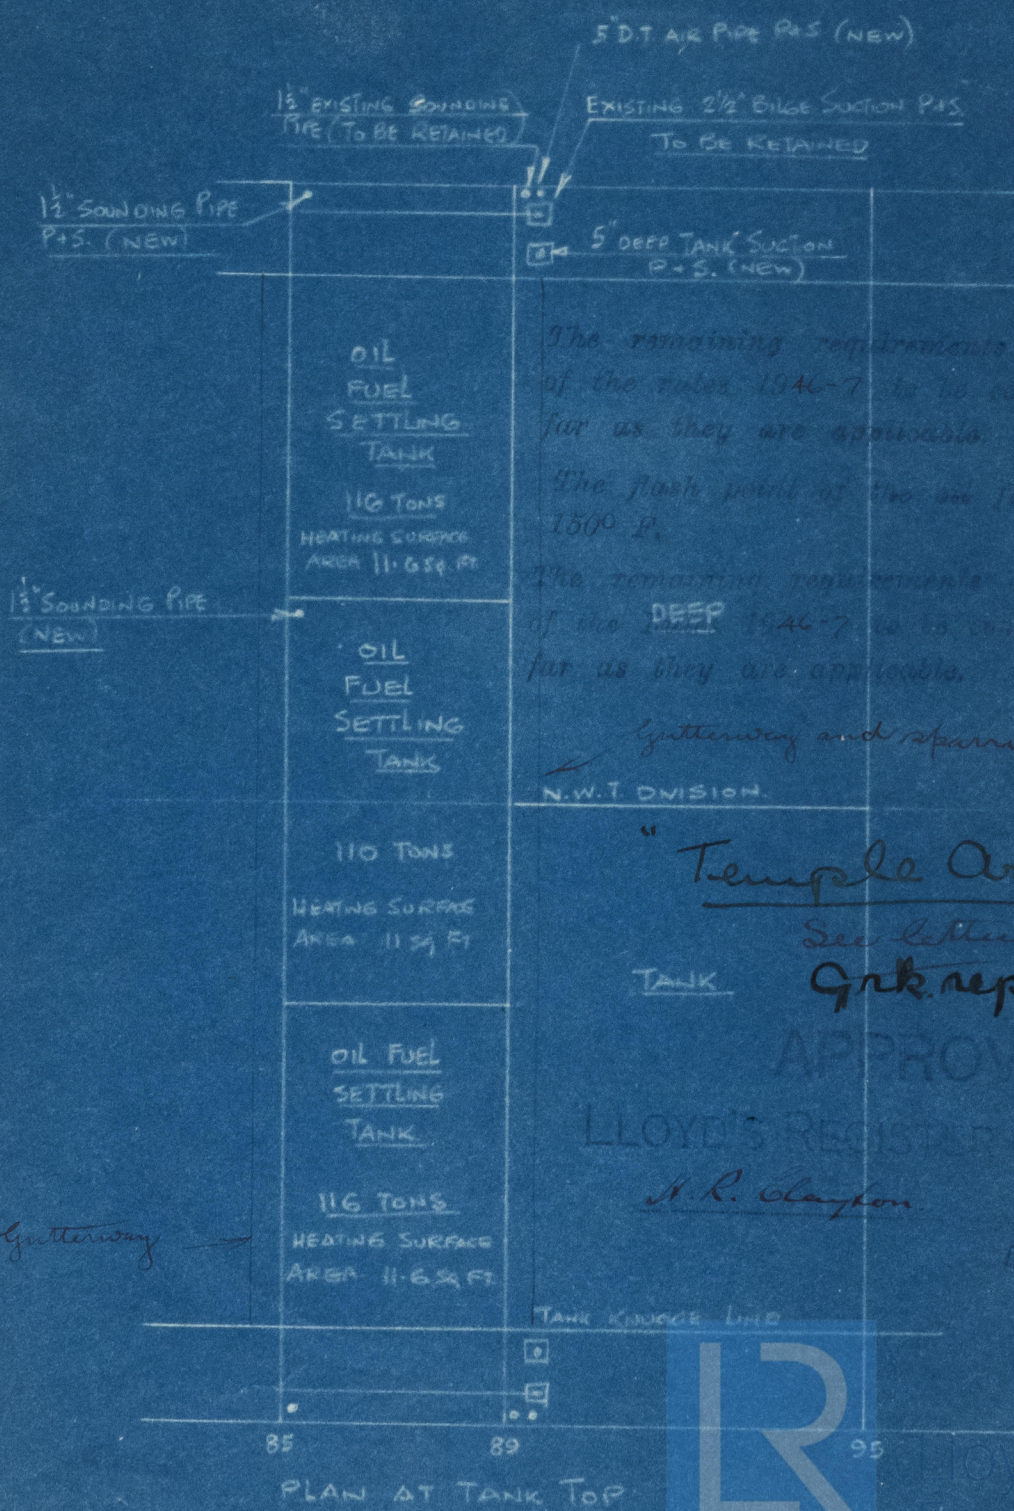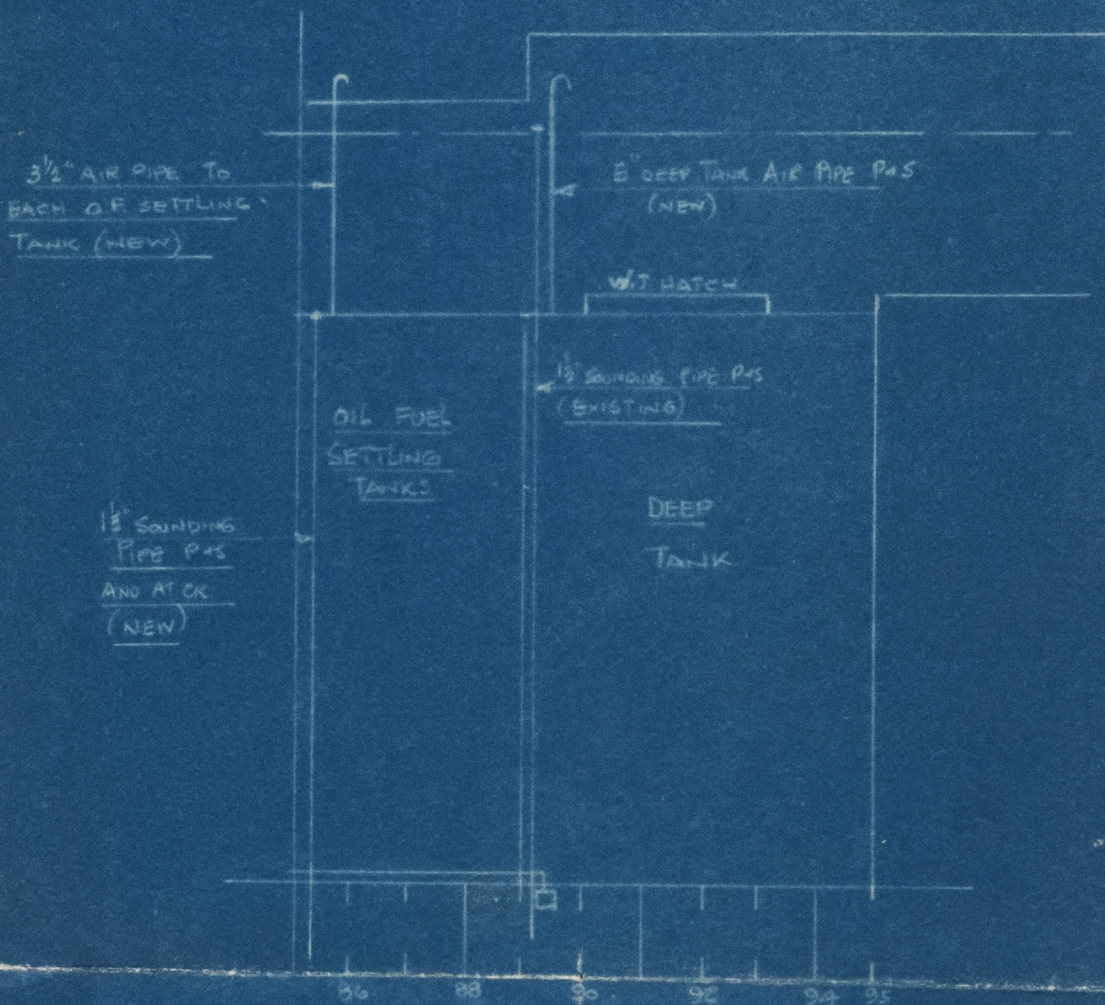

The remaining requirements of section 24
of the rules 1946-7 to be complied with so
far as they are applicable.

The flash point of the oil tank to be above
1500 F.

The remaining requirements of Section 20
of the rules 1946-7 to be complied with so
far as they are applicable.

Gutterway and sparring or lining
N.W.T. DIVISION.

"Temple Arch"

See letter
Tank Grk. rept No. 23619

APPROVED
LLOYD'S REGISTER OF SHIPPING
H. R. Clayton

DATE 23/3/47

Noted
J.R.B.



Lloyd's Register
LONDON