

32976

15 JAN 1955

Index No.

Rpt. C. 11 (Contd.)

## LLOYD'S REGISTER OF SHIPPING

UNITED WITH THE BRITISH CORPORATION REGISTER


F.378

Ship's Name Indian Endeavour.

Official No. 180162

Memorandum of alterations reported since ship was surveyed for assignment of Load Lines  
and new certificate issued in January 1950

Alterations to the Midships space two-deck. (p.s sketch).

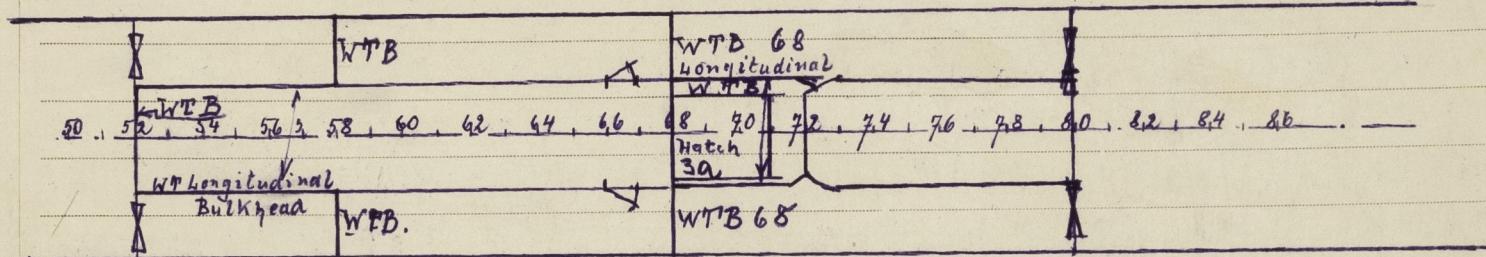


Watertight door removed from bulkhead No 80

New watertight bulkhead at frame 68 and partially frame 58 and 52.

Watertight doors in the boiler casing/frames 66/67,

A new cargo hatch fitted on the casing top instead of bunker hatch between frames 68 and 71. (p.s sketch,) plates: 10 mm

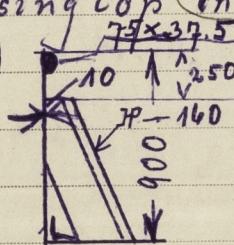

was utilized for  
cargo & coaling  
increased in height  
as per sketch.

Günther Schweitzer.

Battening angles as before.

Noted

*J.S.H.*

= 5 FEB 1955