


<u>LENGTH B.P.</u>	<u>476'-4 1/2"</u>
<u>BREADTH</u>	<u>68'-0"</u>
<u>DEPTH</u>	<u>36'-0"</u>
<u>DRAFT</u>	<u>28'-3"</u>
<u>TOTAL ORE CAPACITY</u>	<u>283,400 cub. ft.</u>
<u>(TO UNDERSIDE OF DECK</u>	
<u>AND HATCH COVERS)</u>	

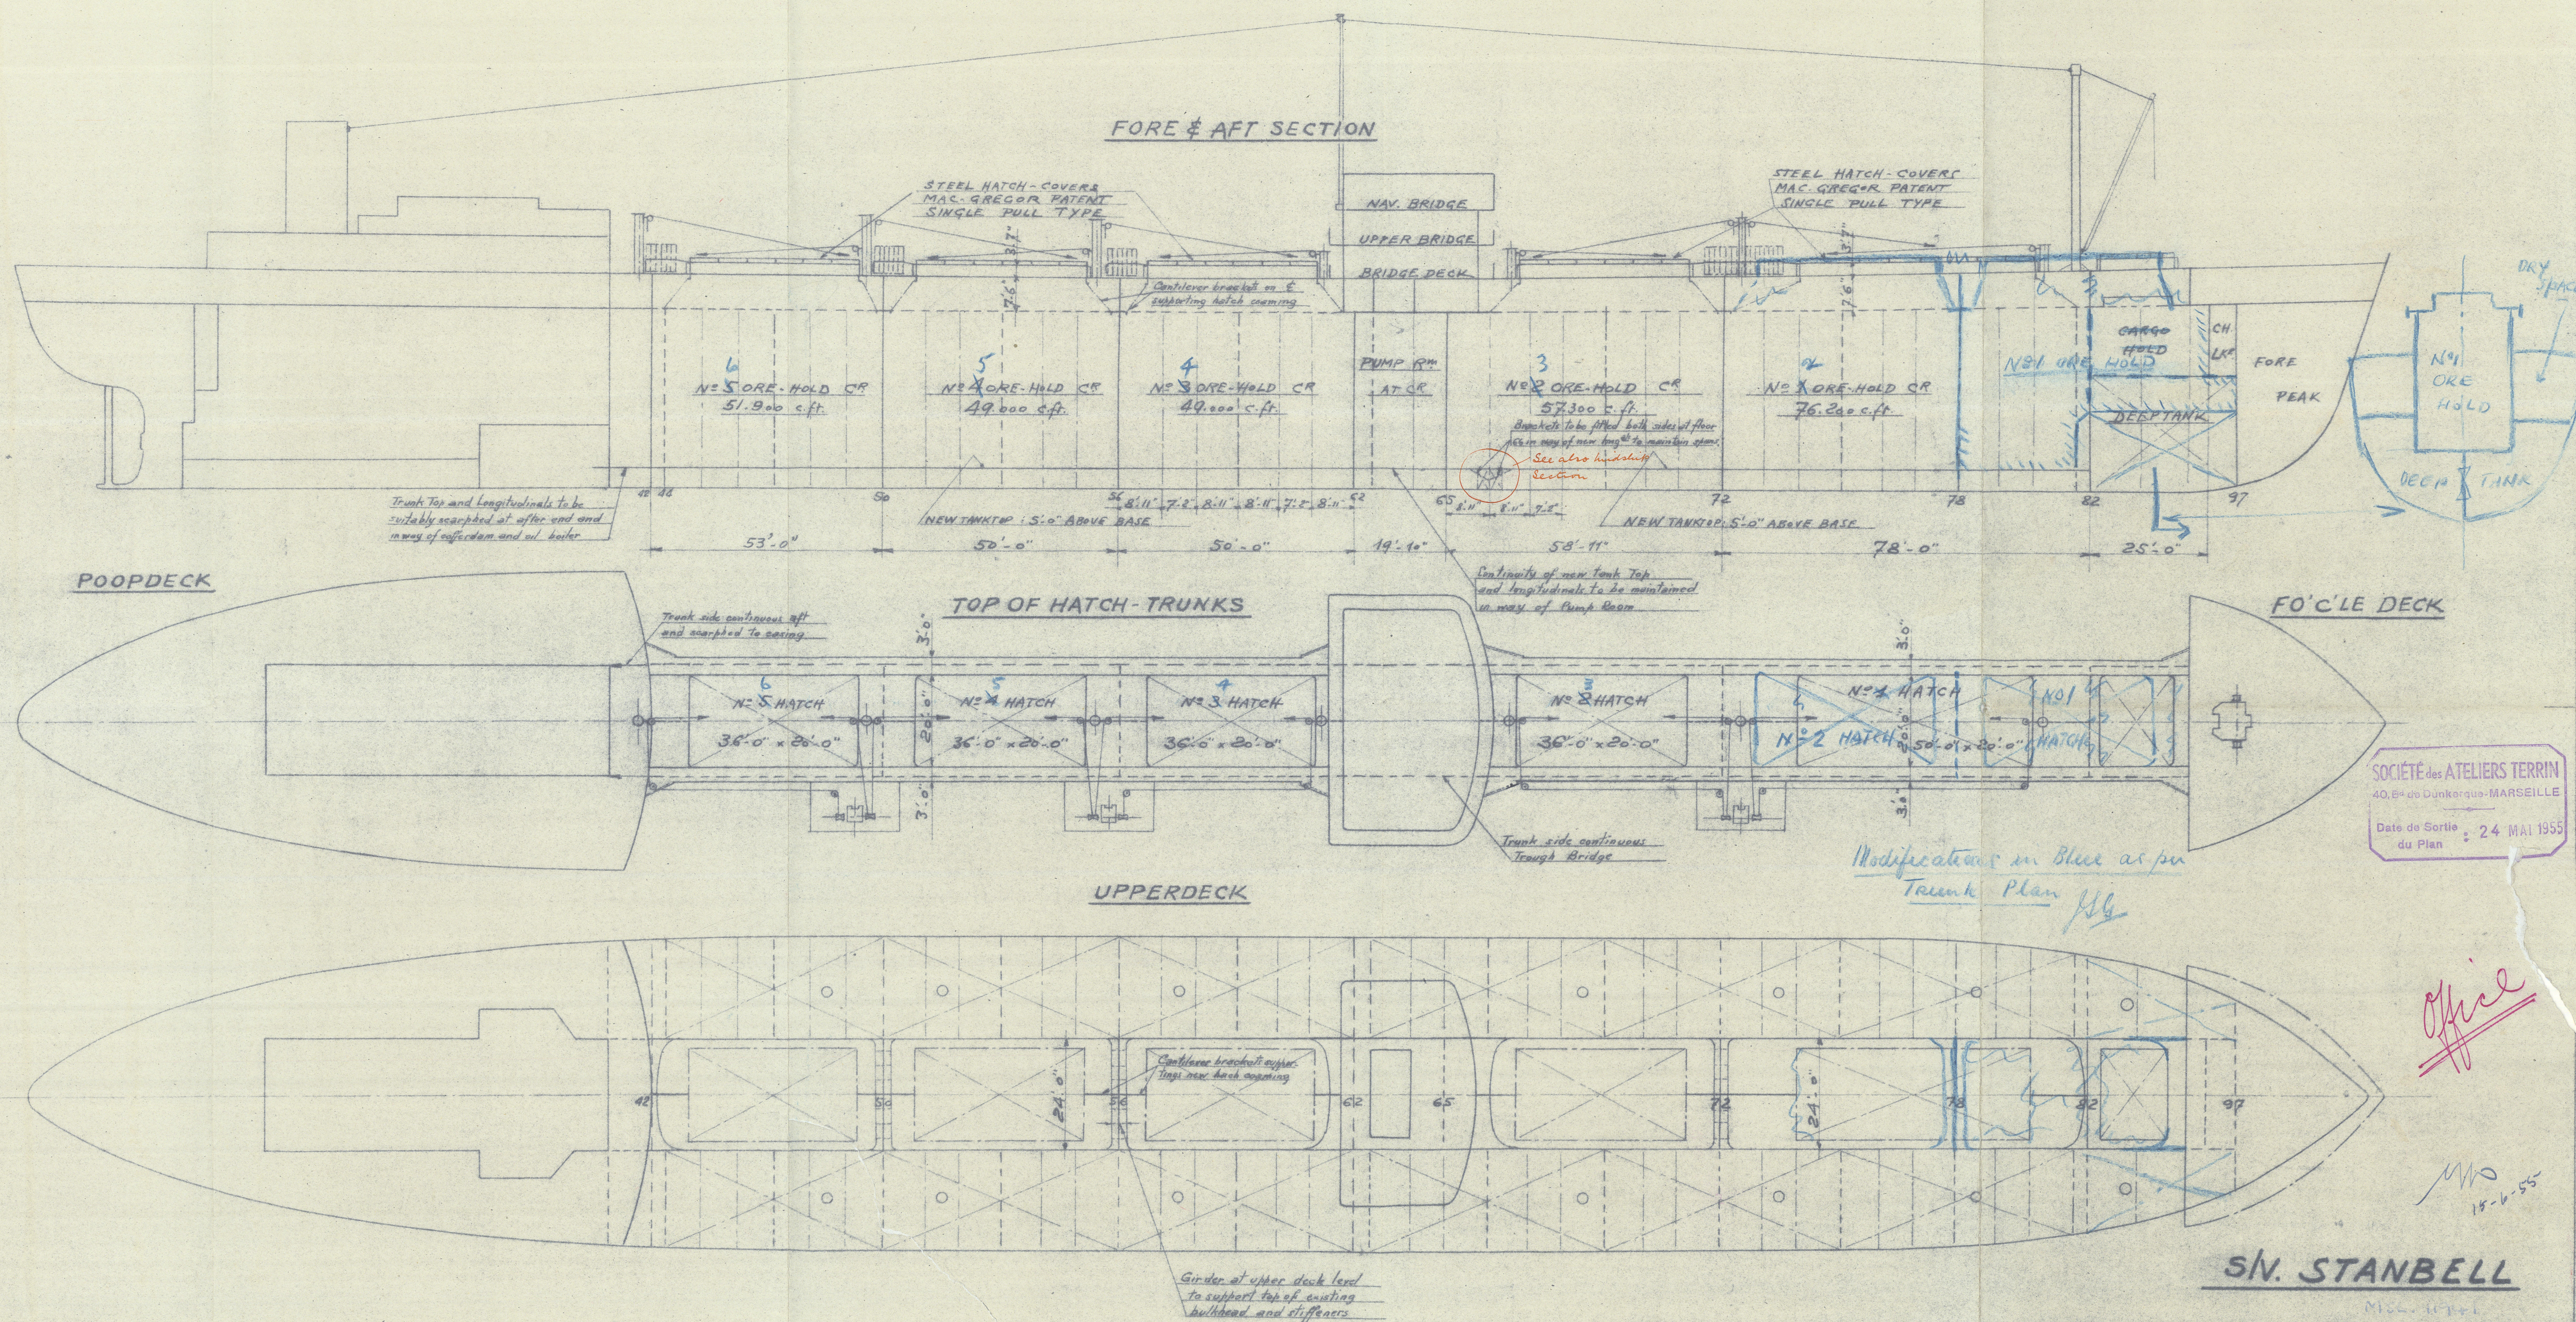

SOCIÉTÉ des ATELIERS TERRIN  
40, Bd de Dunkerque-MARSEILLE  
Date de Sortie : 24 MAI 1955  
du Plan

~~Office~~

15-6-55

S/V. STANBELL

PROPOSED ARGENTAS ORE-CARRIER

SCALE  $\frac{1}{16}" = 1'-0"$

$$Vu =$$

© 2020  
MARSEILLE LE 9 MAI 1955  
Lloyd's Register  
S. 5913  
Foundation

004512-004519-000