

Lloyd's Register of Shipping.


KELANTAN

Ship's Name *ex* S.S. "STANBELL"

Official No. 180052.

Memorandum of alterations reported since ship was surveyed for assignment of Load Lines in NOVEMBER 1943.

CONVERSION TO ORE-CARRIER.

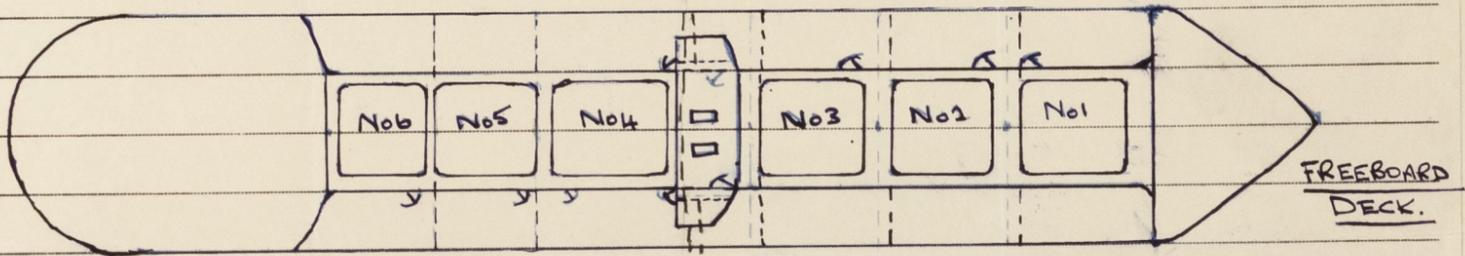

Darboley



© 2020

Lloyd's Register Foundation

004512-004519-0109