

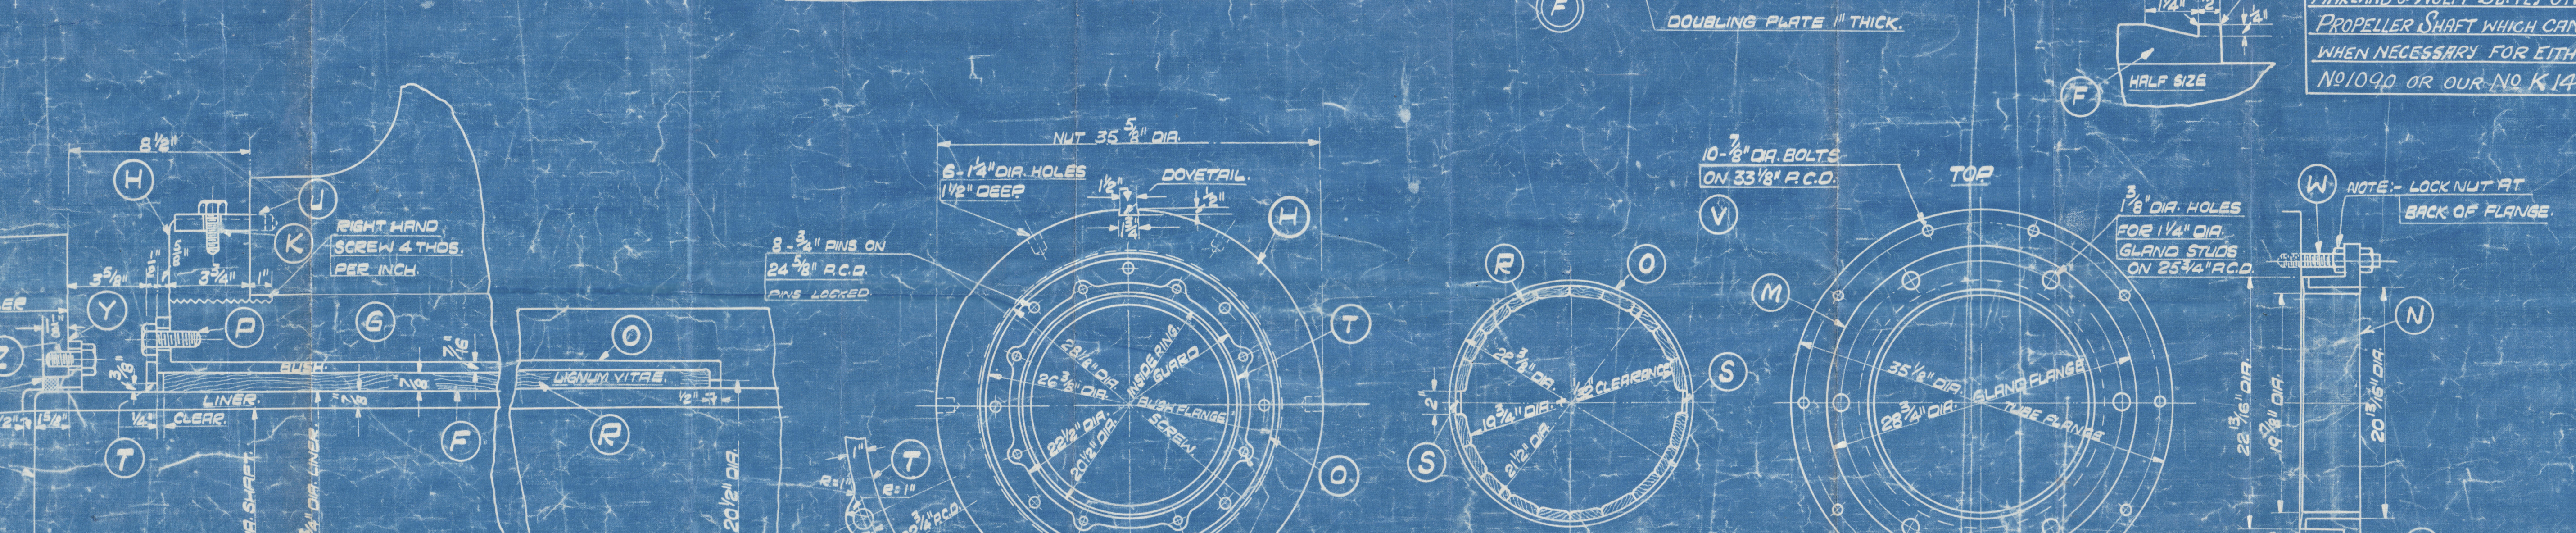
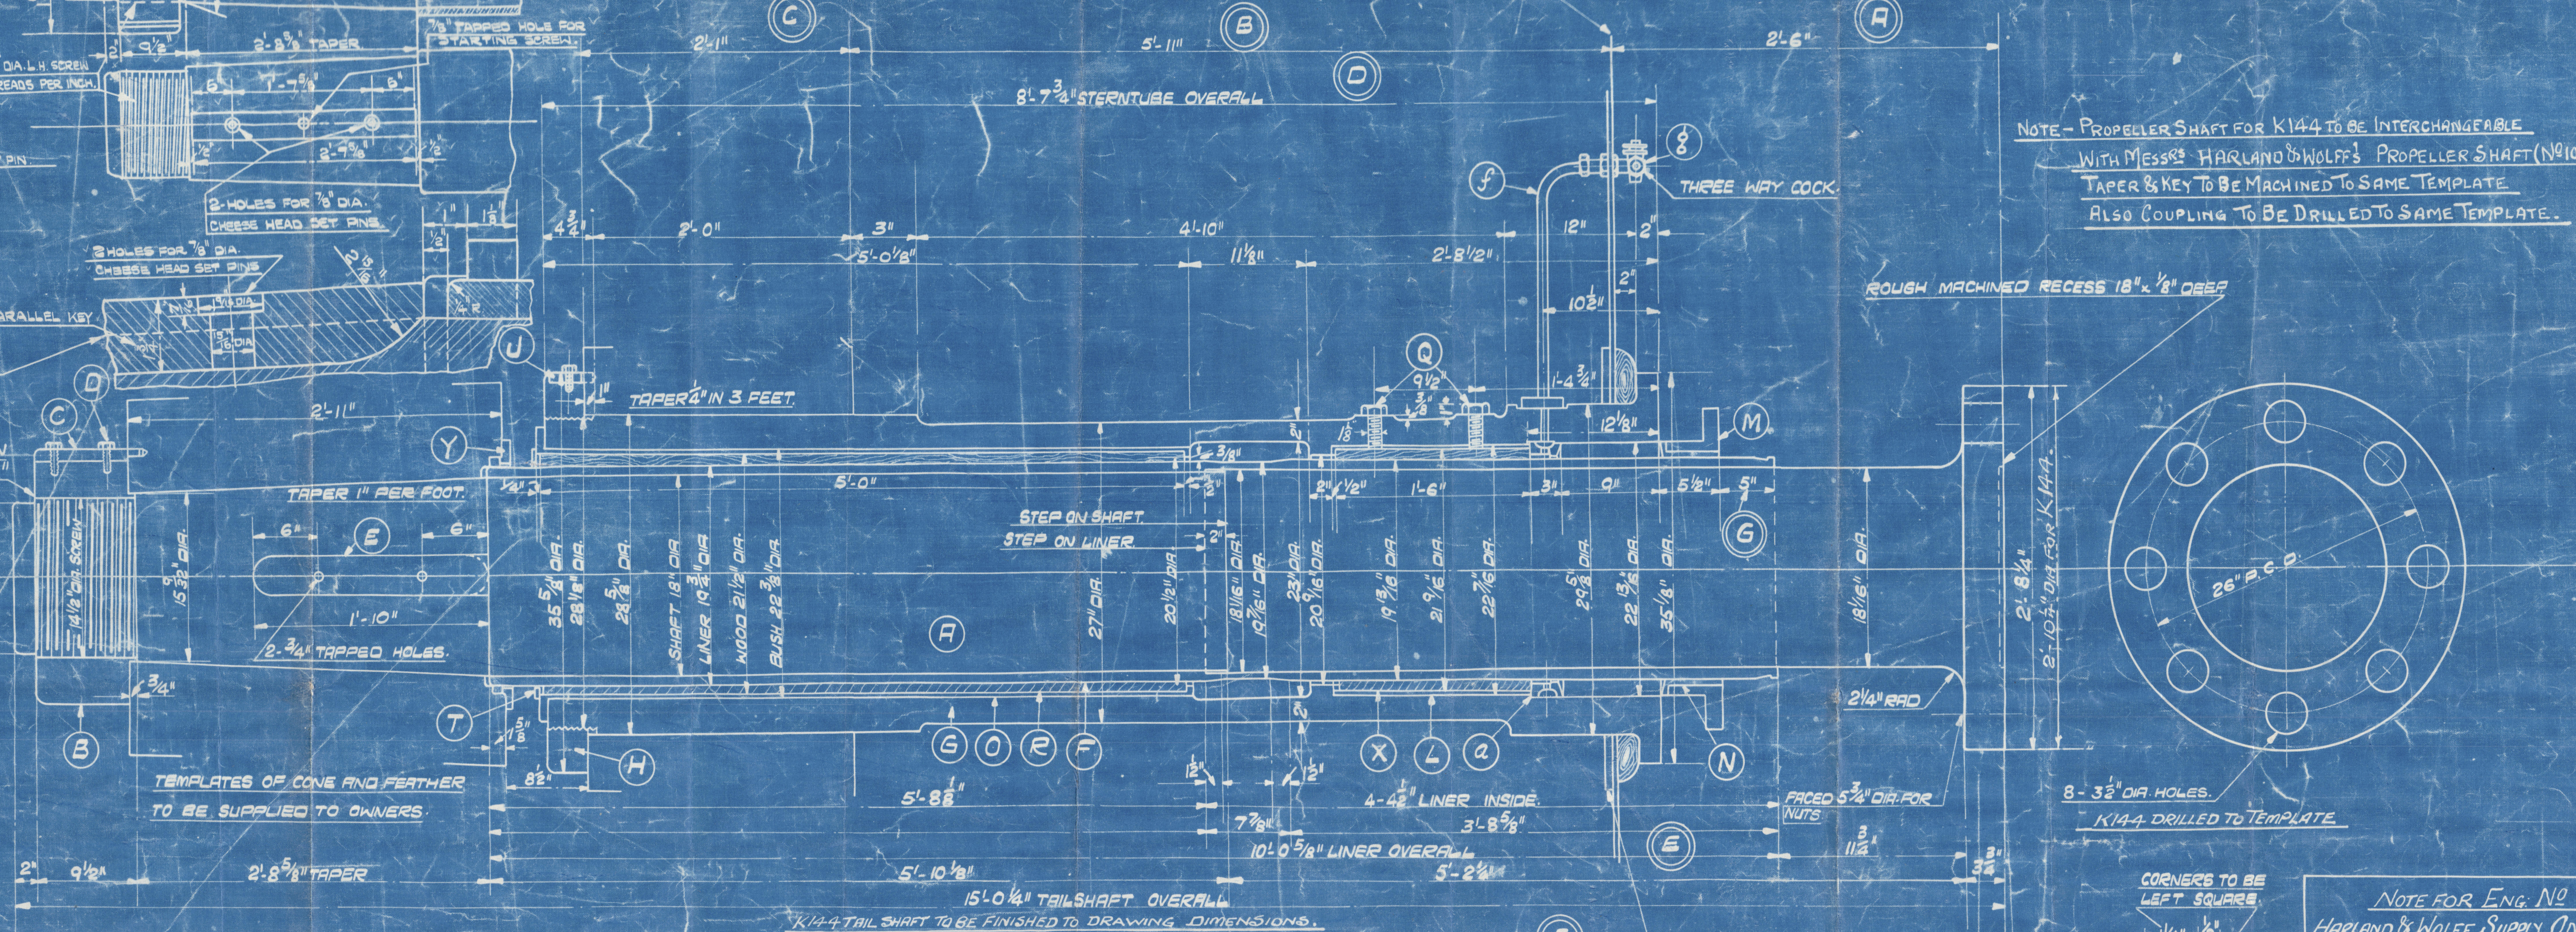
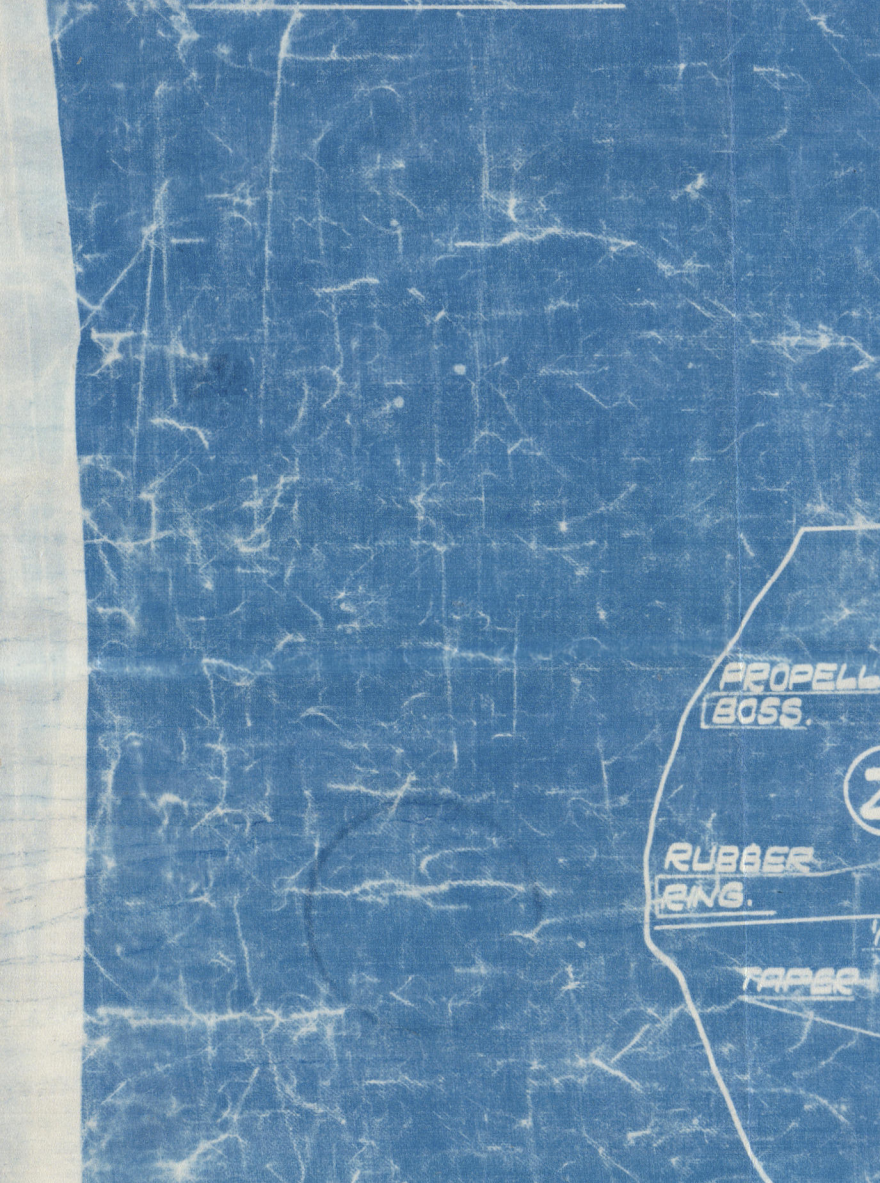
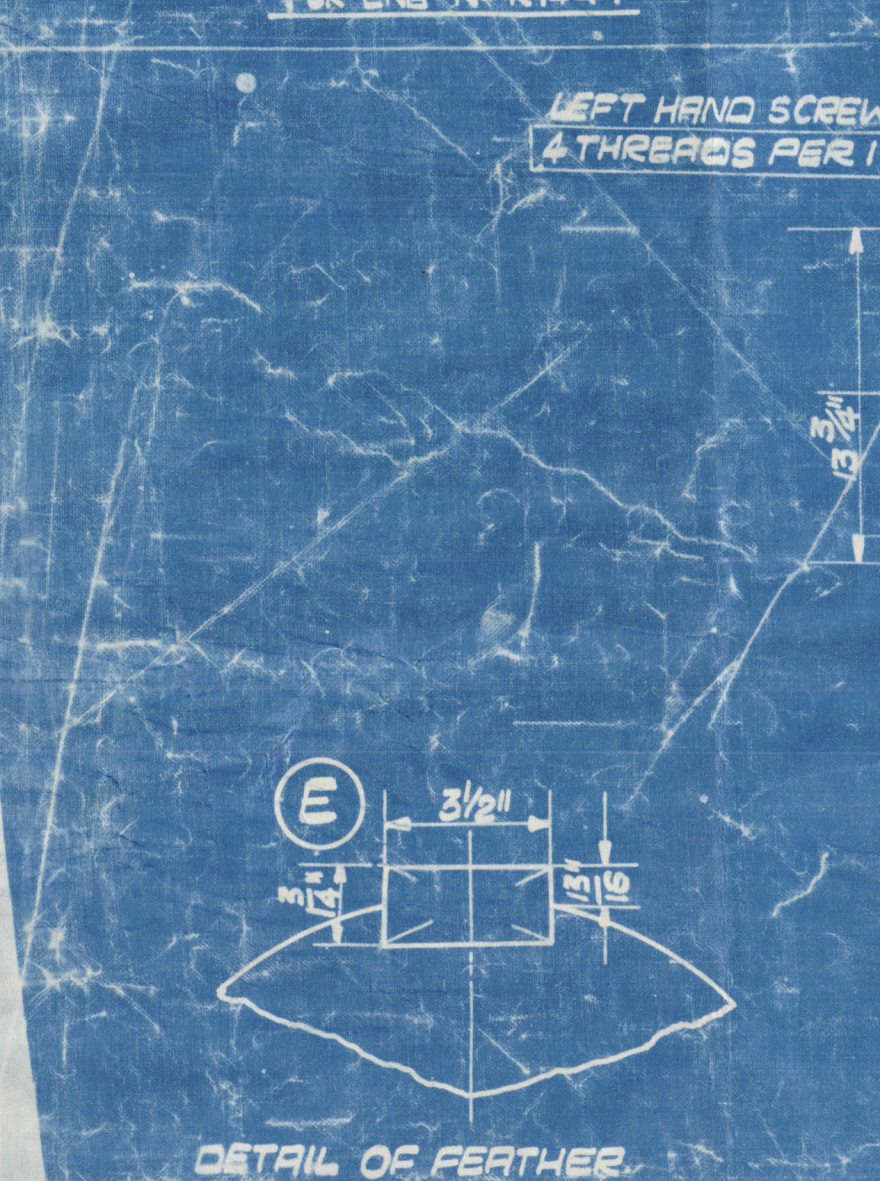


JOHN KINCAID & CO
LIMITED
ENGINEERS
GREENOCK

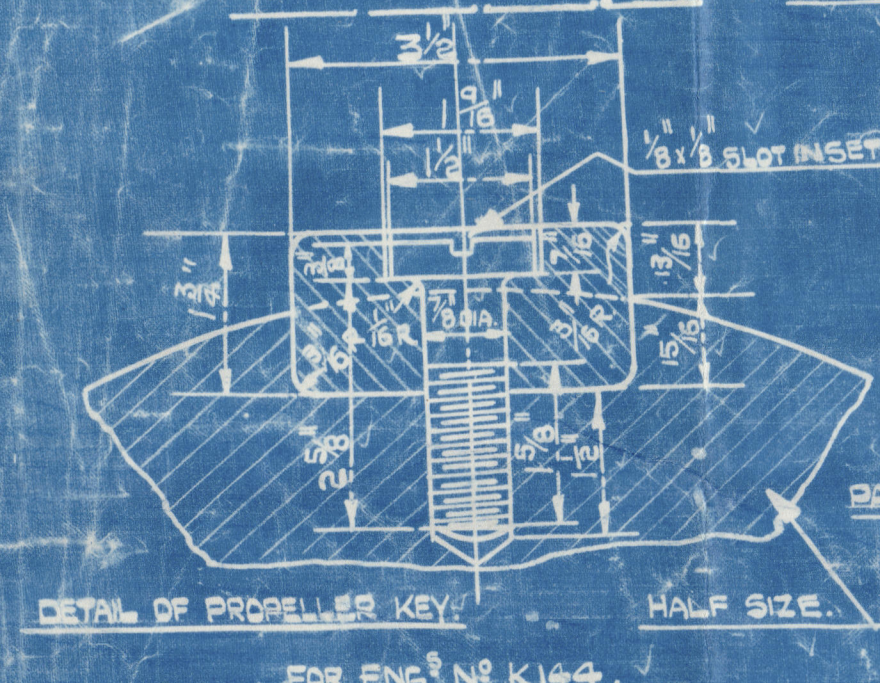

LENGTHS MEASURED FROM SHIP

ENG. NO.	A	B	C	D	E	F	G	DATE
K114	2'-7 1/8"	5'-10 3/8"	2'-0 3/8"	8'-6 3/8"	10'-0 3/8"	15'-0 3/8"	6 3/8"	1-3-38
K115	2'-5 3/8"	5'-10 3/8"	2'-0 3/8"	8'-7 3/8"	9'-11 1/8"	14'-11 1/8"	4 1/8"	11-4-38
K117	2'-6 1/4"	5'-11 1/8"	2'-0 3/8"	8'-7 3/8"	10'-0 3/8"	15'-0 3/8"	5 1/4"	17-6-38
K121	2'-4 3/8"	5'-11 1/8"	2'-1"	8'-8"	9'-11 1/8"	14'-11 1/8"	3 5/8"	23-2-39
K122	2'-5 1/2"	5'-11"	2'-0 3/8"	8'-7 3/8"	10'-0"	14'-11 3/8"	4 3/4"	10-5-39
K126	2'-5 3/8"	5'-10 3/8"	2'-0 3/8"	8'-7 3/8"	10'-0 3/8"	14'-11 1/8"	4 5/8"	18-7-39
K127	2'-6 1/4"	5'-11"	2'-0 3/8"	8'-7 3/8"	10'-1"	15'-0 3/8"	5 1/2"	20-5-39
K128	2'-7 1/8"	5'-10 3/8"	2'-0 3/8"	8'-6 3/8"	10'-1"	15'-0 3/8"	6 3/8"	18-8-39
K144						15'-0 3/8"		

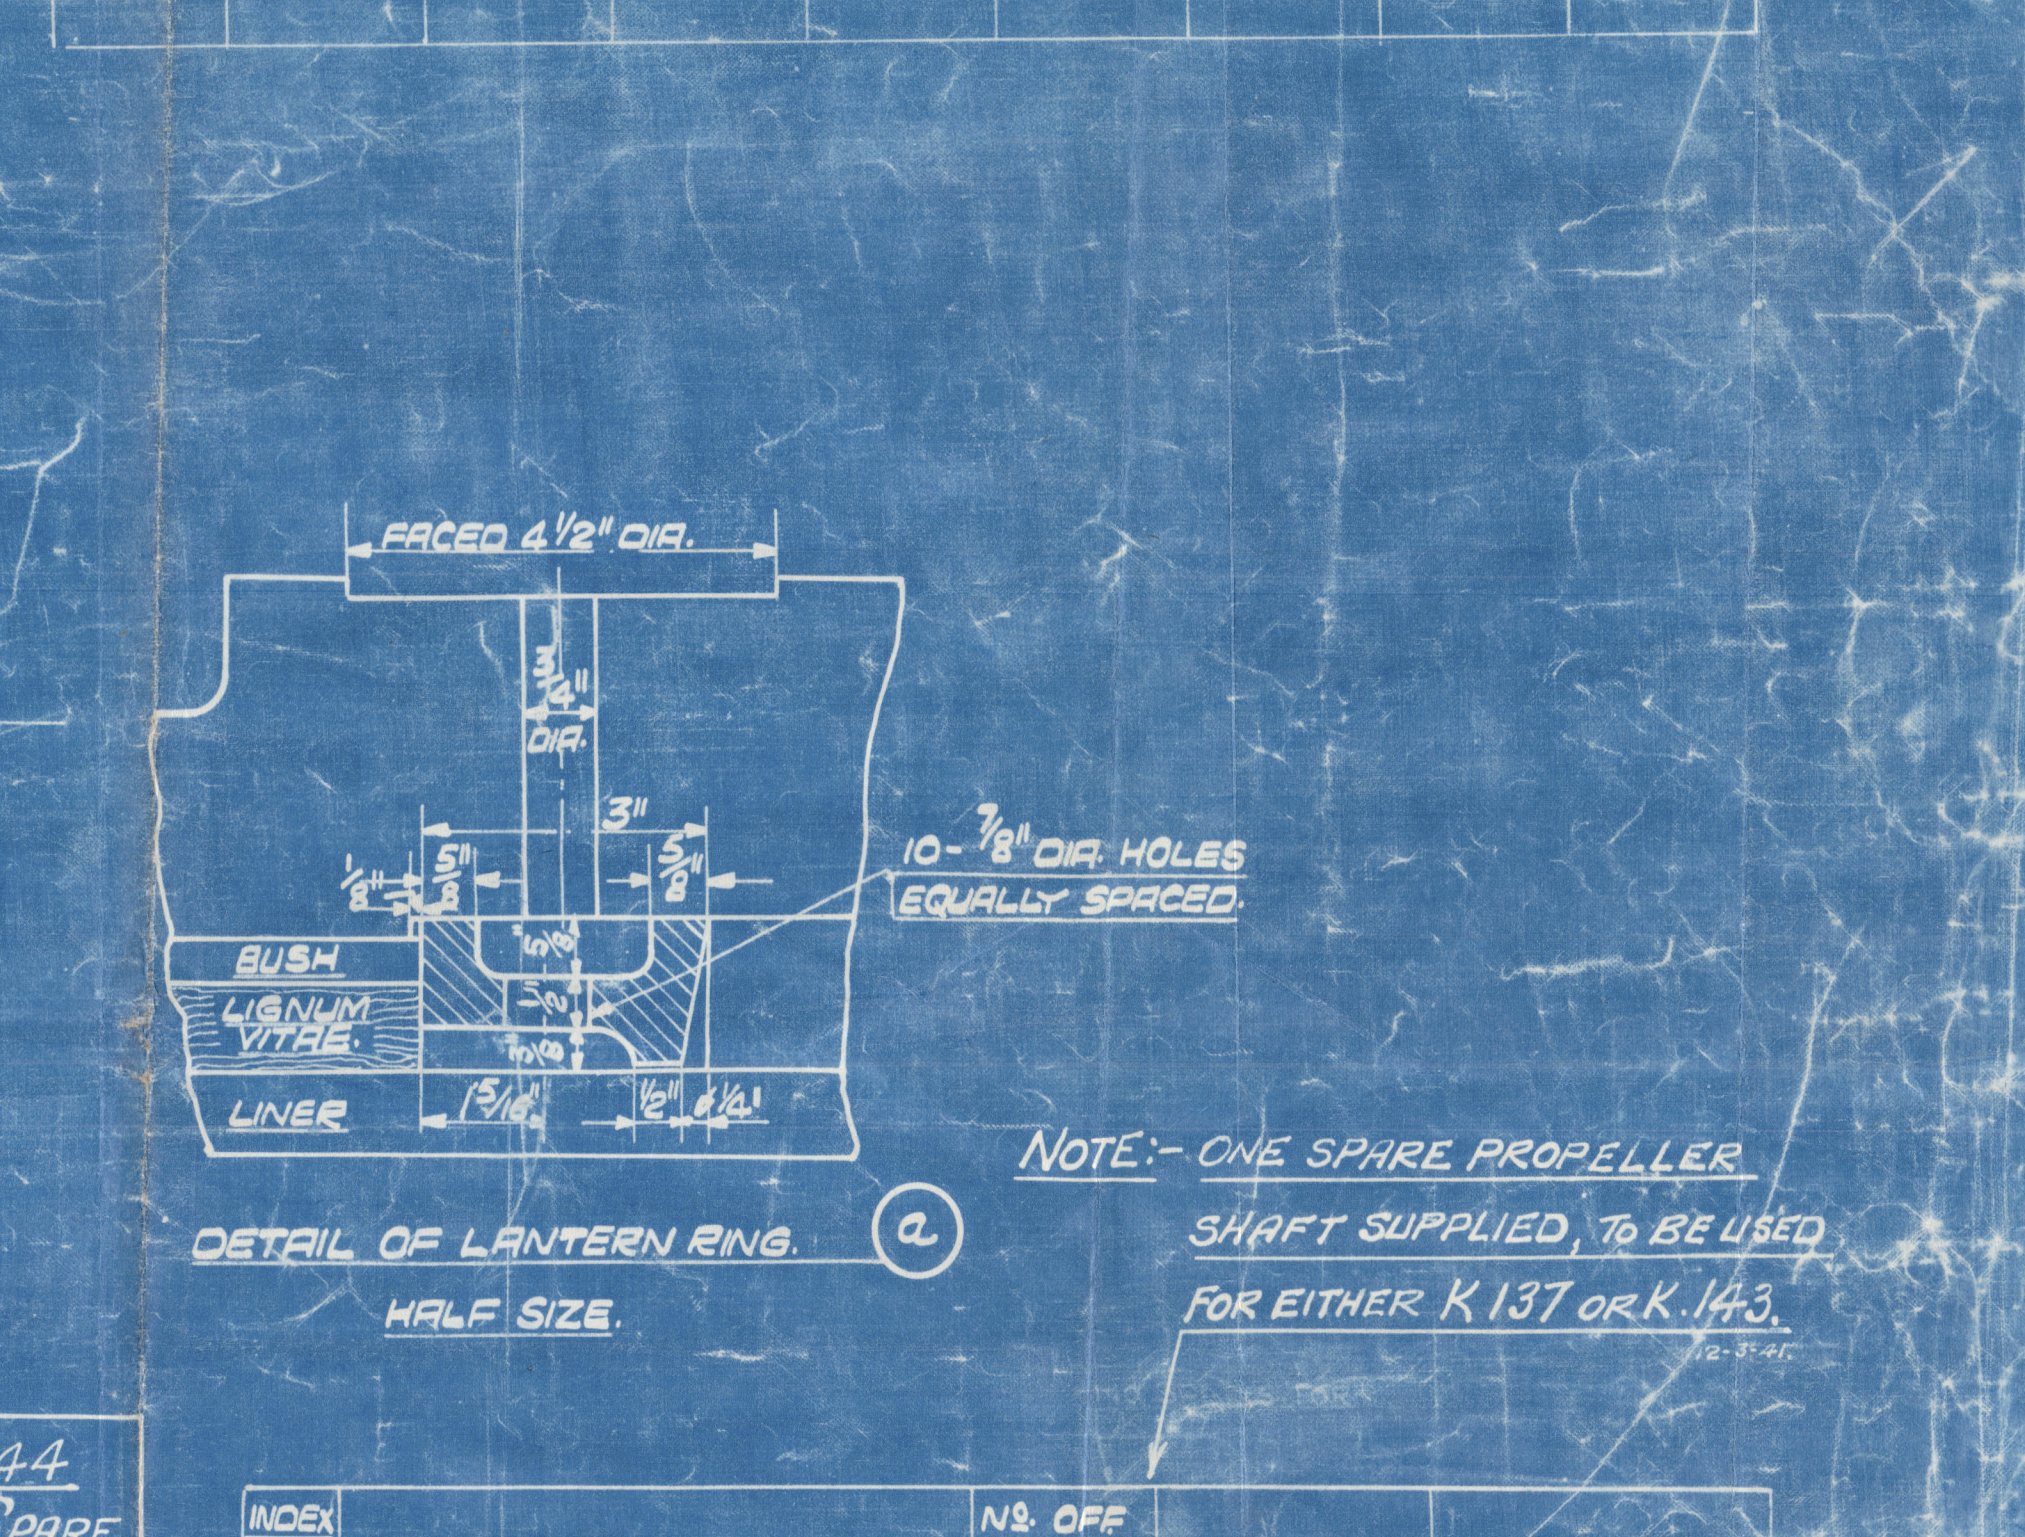

NOTE: - ONE SPARE PROPELLER SHAFT SUPPLIED, TO BE USED FOR EITHER K137 OR K143.

INDEX	DESCRIPTION	Nº OFF	WORKSPACE	MATERIAL	REMARKS
A	PROPELLER SHAFT	1	1	SIEMENS MARIN WROT STEEL	
B	" " " " " "	1	1	WROT IRON	
C	" " " " " "	1	1	MILD STEEL	
D	" " " " " "	2	2	WROT IRON	
E	" " " " " "	1	1	MILD STEEL	88% COPPER
F	" " " " " "	1	1	BRASS	10% TIN 2% ZINC
G	STERN TUBE	1	1	CAST IRON	
H	" " " " " "	1	1	MILD STEEL	
I	" " " " " "	1	1	" " " "	
J	" " " " " "	1	1	" " " "	
K	" " " " " "	1	1	WROT IRON	
L	" " " " " "	1	1	BRASS	
M	" " " " " "	1	1	CAST IRON	
N	" " " " " "	1	1	BRASS	
O	" " " " " "	1	1	" " " "	
P	" " " " " "	8	8	" " " "	
R	" " " " " "	1	1	WOOD LINING	LIGNUM-VITAE
S	" " " " " "	2	2	BRASS	
T	" " " " " "	1	1	" " " "	
U	" " " " " "	8	8	" " " "	
V	" " " " " "	1	1	WROT IRON	
W	" " " " " "	10	10	WROT IRON	
X	" " " " " "	7	7	WROT IRON	
Y	PROPELLER BOSS GLAND	1	1	BRASS	IN HALVES
Z	" " " " " "	8	8	" " " "	
Q	STERN TUBE INNER BUSH SET PINS	2	2	STEEL	
Q	" " " " " "	1	1	BRASS	
Q	OUTER BUSH STRIP PINS	10	10	COILED BRASS	
Q	STERN TUBE INNER BUSH STRIPS	2	2	" " " "	
Q	INNER BUSH STRIP PINS	6	6	" " " "	
Q	WATER SERVICE PIPE	1	1	COPPER	
Q	" " " " " "	1	1	BRASS	TO SKETCH SHIP
Q	WASHERS FOR BUSH PINS	8	8	COPPER	
Q	" " " " " "	8	8	" " " "	

APPROVED
LLOYD'S REGISTER OF SHIPPING
DATE 22/5/41

STERNTUBE & PROPELLER SHAFT.
ENC. NOS. K. 14 - 15 - 16 -

RETAIN

004520-004526-0118

J G KINCAIDS

K 146


BLYTHSWOODS

70

STERN TURK & SERRIN SHAN


apt 22-5-41

"NINE LLA" © 2020

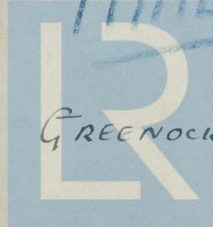


First Entry Report No.
223281
Foundation

24

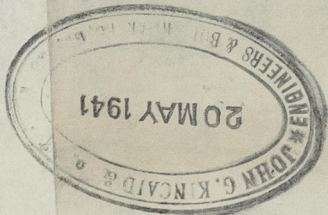

004520-004526-0118

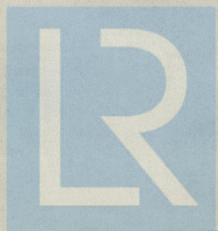

© 2020
Lloyd's Register
Foundation