





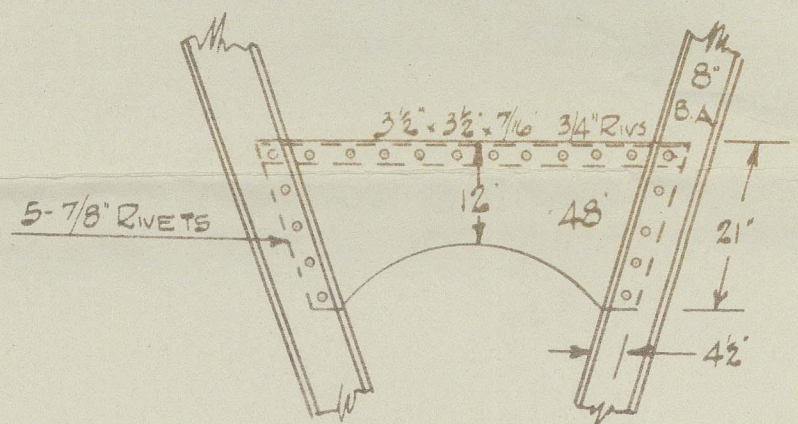





PLATE BEAM FR. 90 FOR<sup>D</sup>

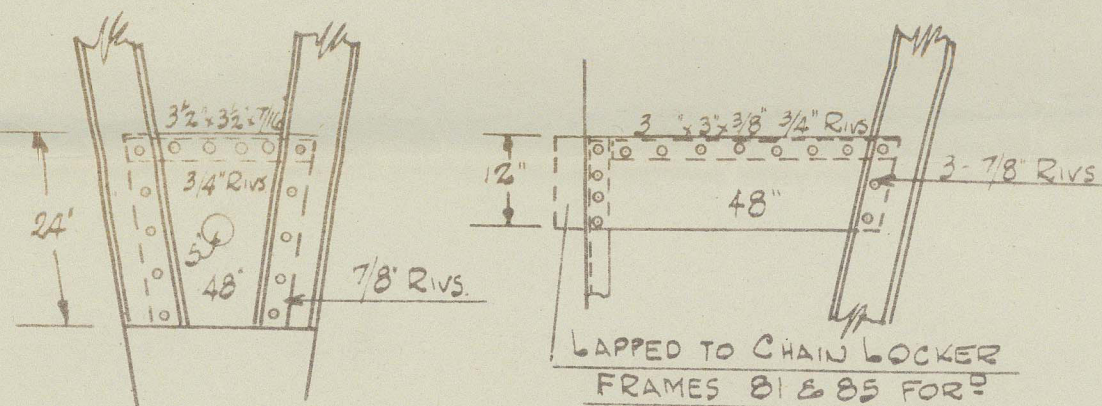


FRAME 91 FOR?

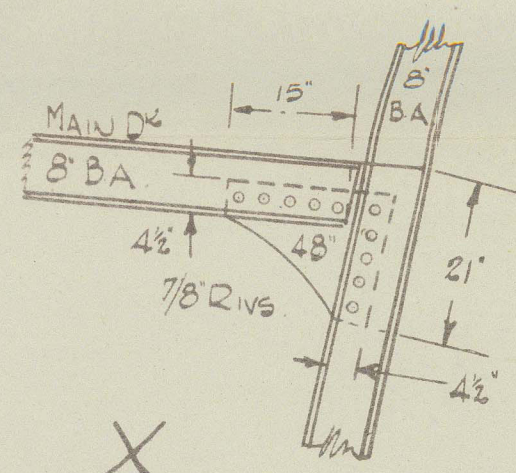


X<sub>2</sub>  
SEE "FORE END FRAMING"

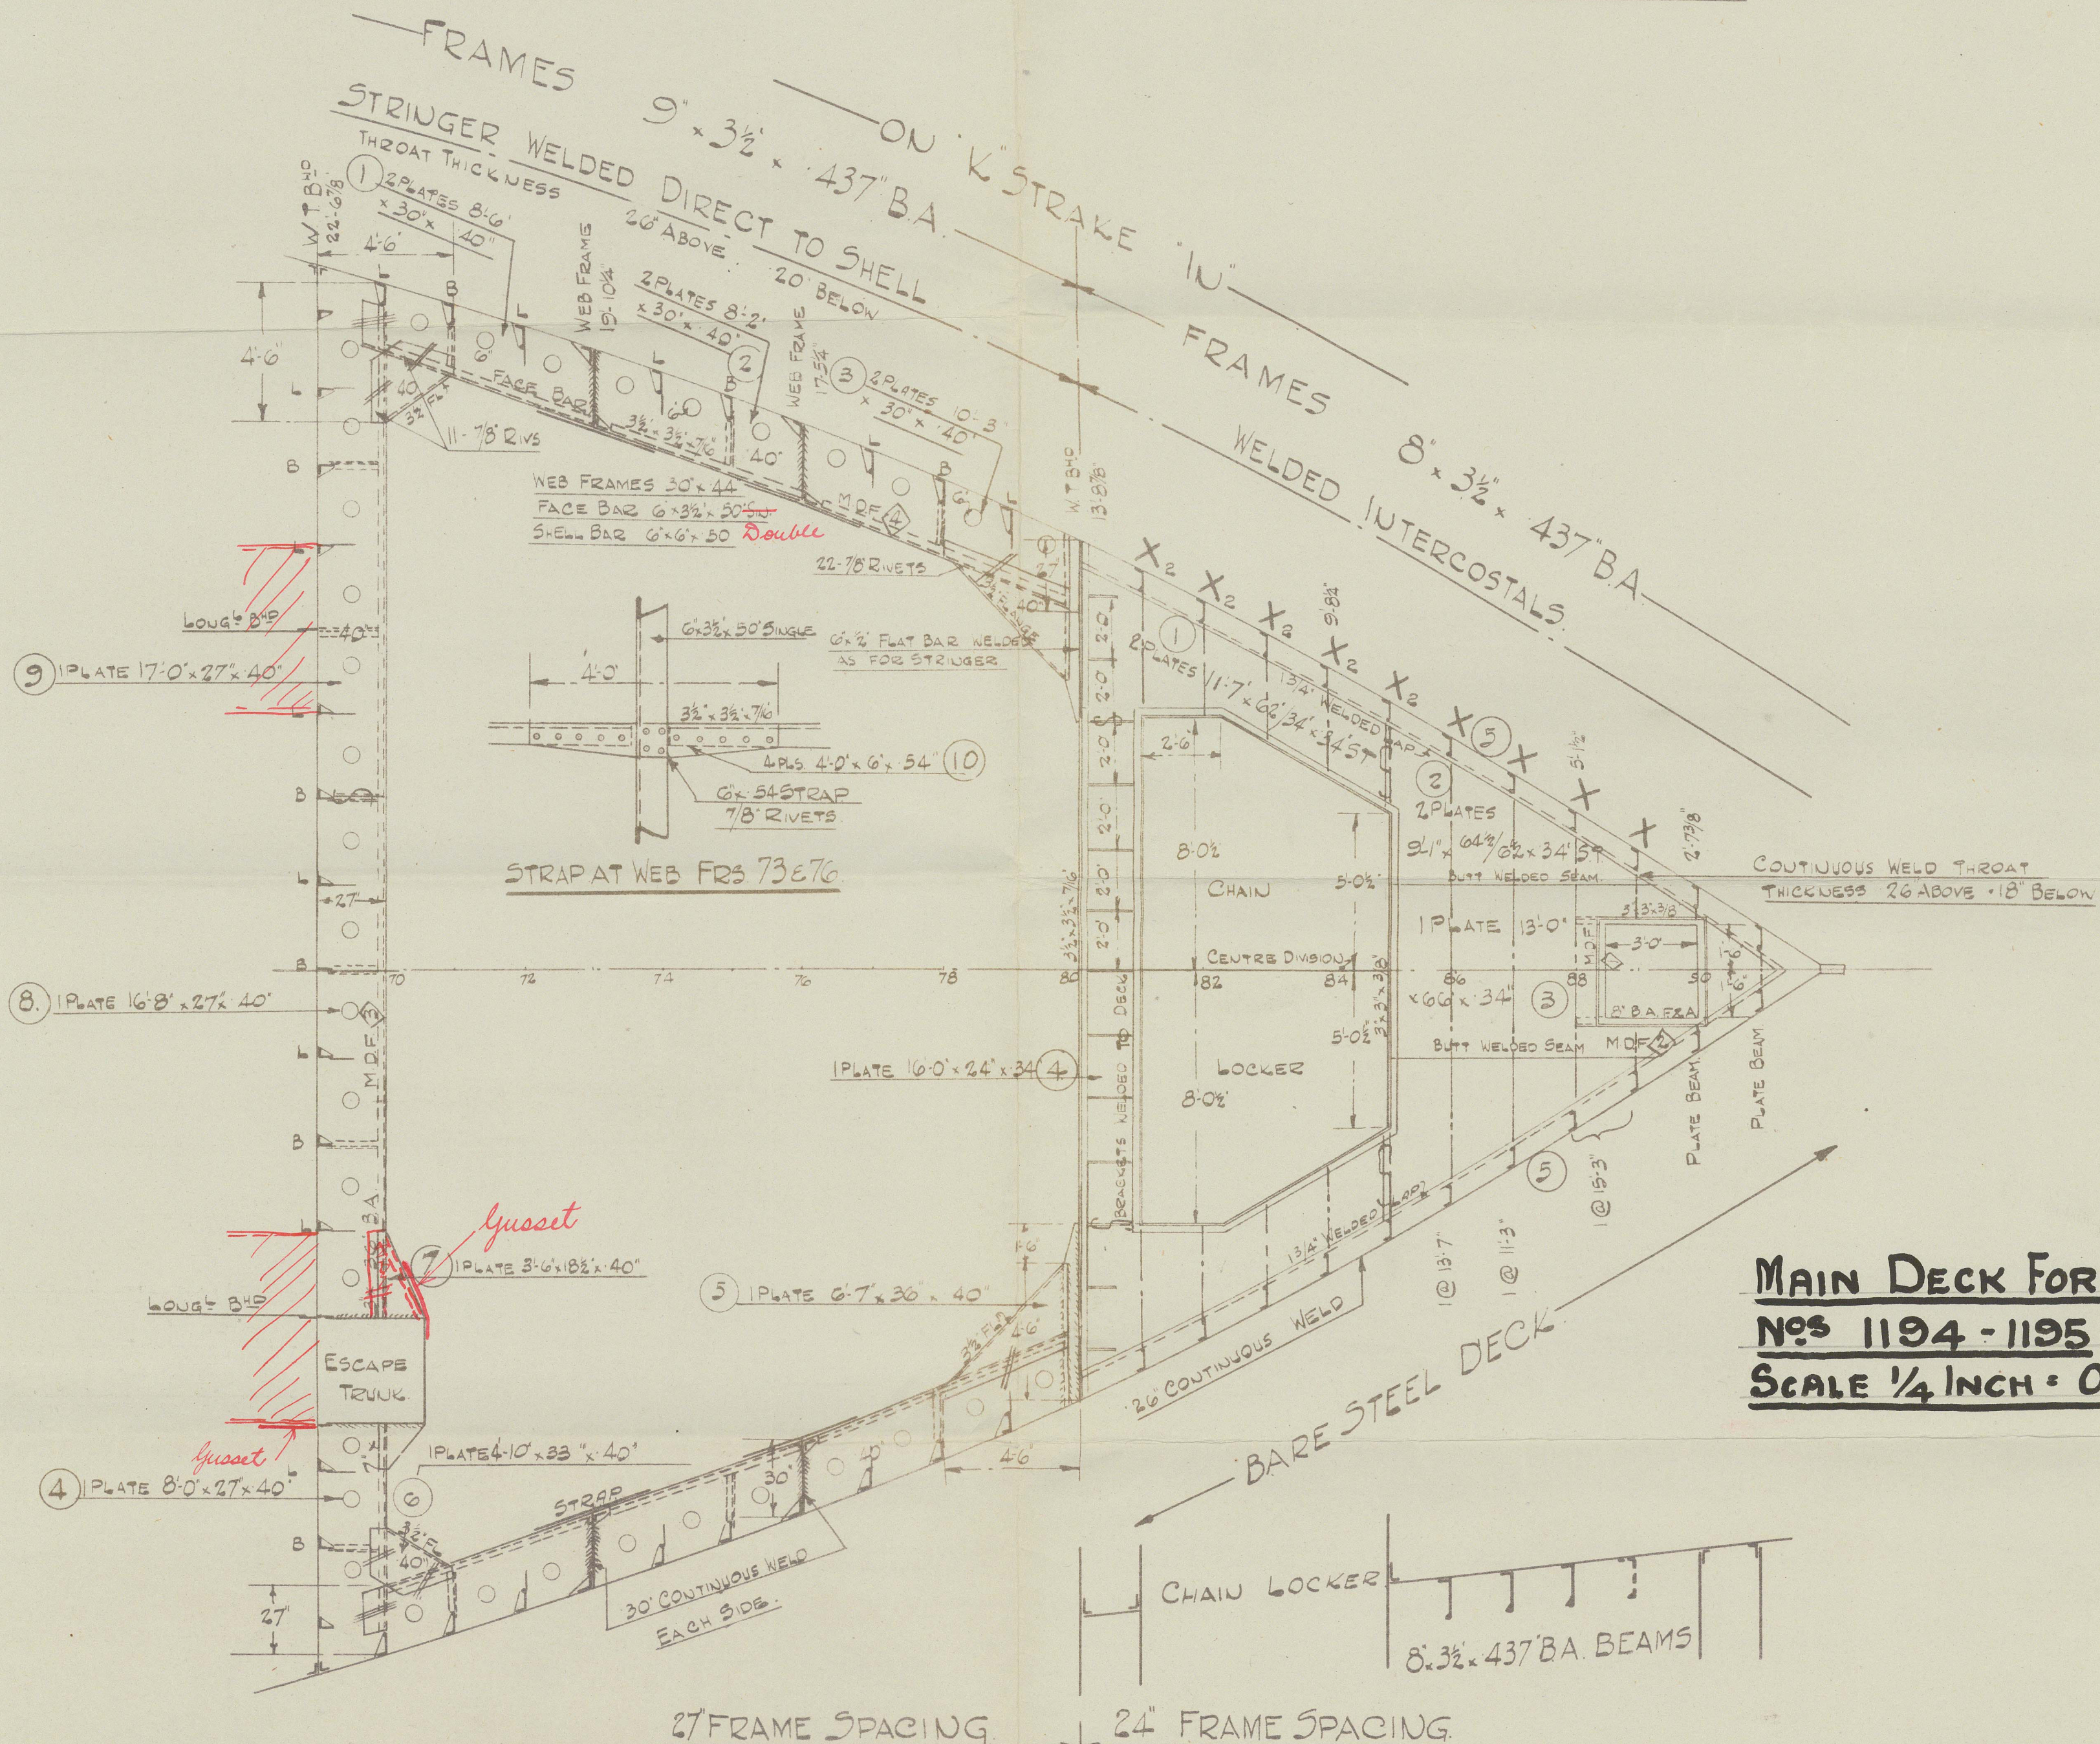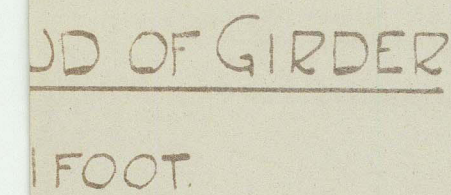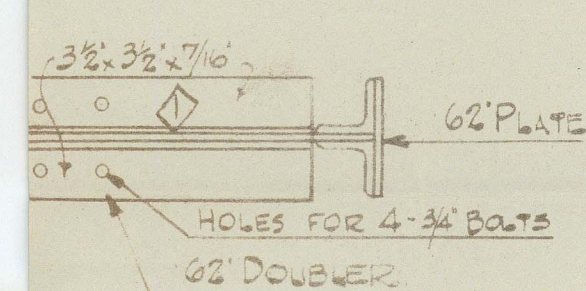


MAIN DECK FORWARD  
NOS 1194 - 1195  
SCALE  $\frac{1}{4}$  INCH = ONE FOOT.

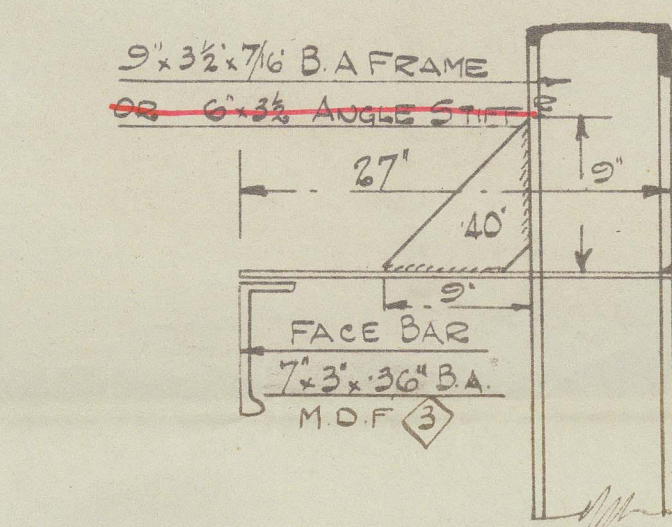

STRINGER BRACKETS MARKED "L"

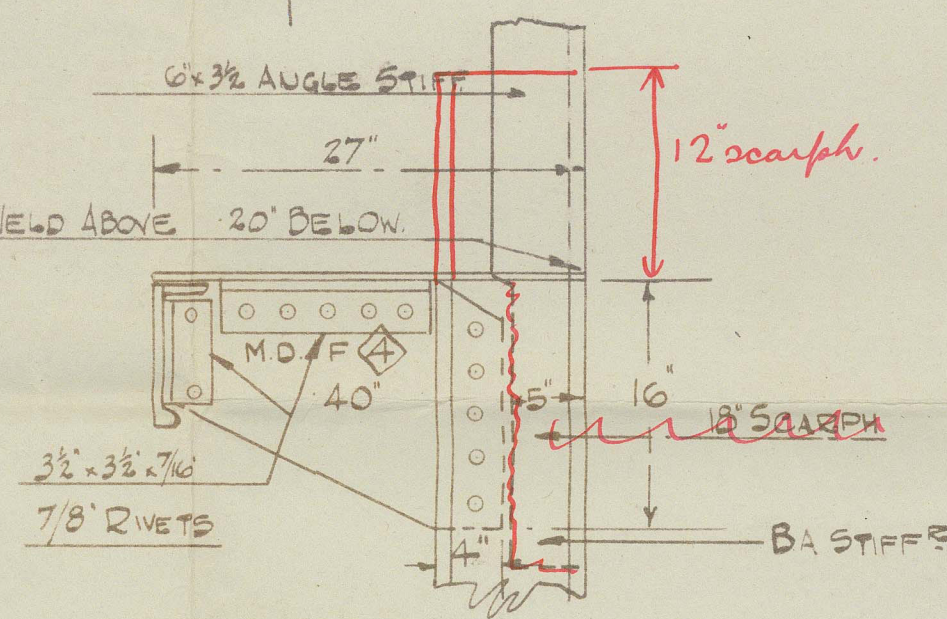

STRINGER BRACKET MARKED 'B'

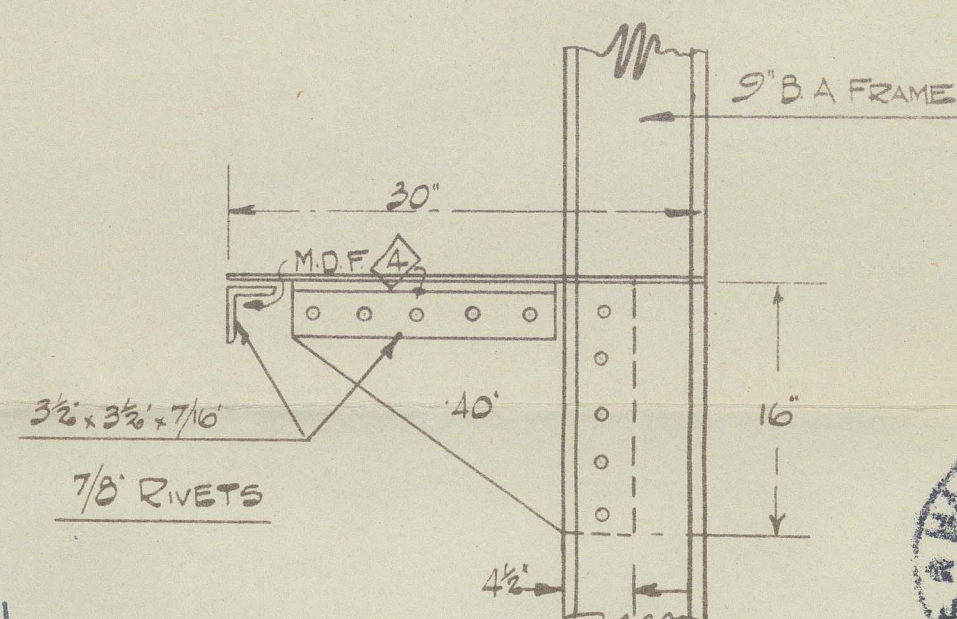

BRACKETS AT SHELL MARKED B

Lloyds  
S. 130



© 2021

Lloyd's Register  
Foundation

004573-004578-0177



~~27~~

13

HARLAND & WOLFF LTD  
BELFAST

No. S. 1194 5

TITLE Main Deck

Forward

DATE APPROVED 12.12.44


*S.P.*



1194 Beefast Report No 13626 - Norway

1195

13662 - Norway

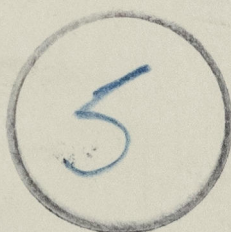

© 2021

Lloyd's Register  
Foundation

004573-004578-0117



004573-004578-0177

HW 11/94 5-  
man deck forward

004573-004578-0177



© 2021

Lloyd's Register  
Foundation