


© 2020
Lloyd's Register Foundation

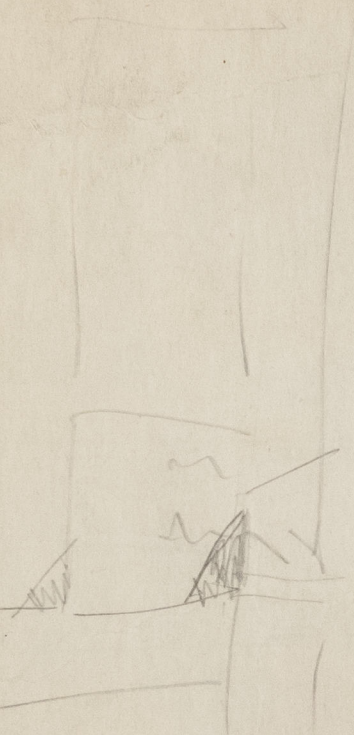

part plate found



© 2020

Lloyd's Register
Foundation

HARLAND & WOLFF LTD.
BELFAST

No. 1161
TITLE Rudder

DATE APPROVED 16.5.42

'JULIA' M/M.4656

6

'Waiwera' Belfast Rpt. No 13856

004653-004661-0045



© 2020

Lloyd's Register
Foundation