



## MIDSHIP SECTION



SCALE 1/2" = ONE FOOT		
DIMENSIONS AS PER RULE		
LENGTH BETWEEN PERPENDICULARS		450.00
BREADTH MOULDED		58.29
DEPTH MOULDED TO UPPER DECK (ABOVE TOP OF KEEL)	D <sub>1</sub>	32.23
" " " BRIDGE	( " " " ) D <sub>2</sub>	41.23
" " " UPPER	(ABOVE BASE LINE)	32.13
" " " BRIDGE	( " " " )	41.16
CLASS + DOL + WITH SCANTLING SUITABLE FOR A SUMMER		
DRAFT OF 25.53" (ABOVE TOP OF KEEL)		

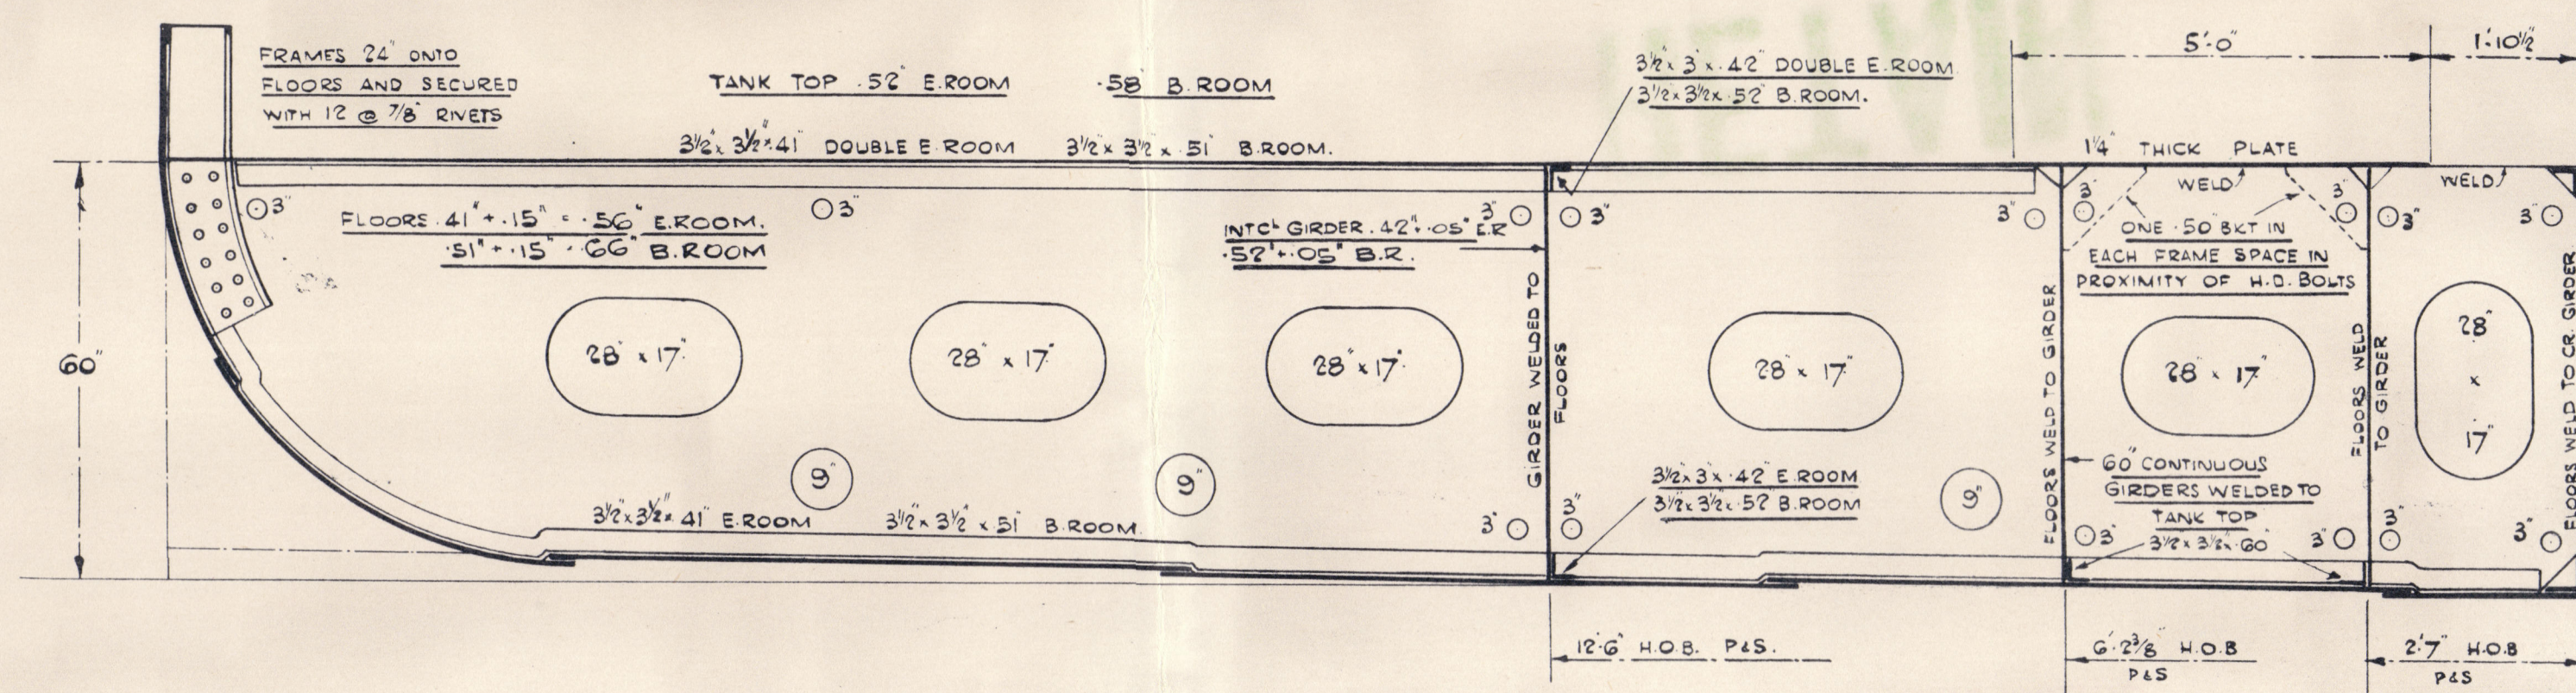

SECTION THROUGH MACHINERY SPACE DOUBLE BOTTOM

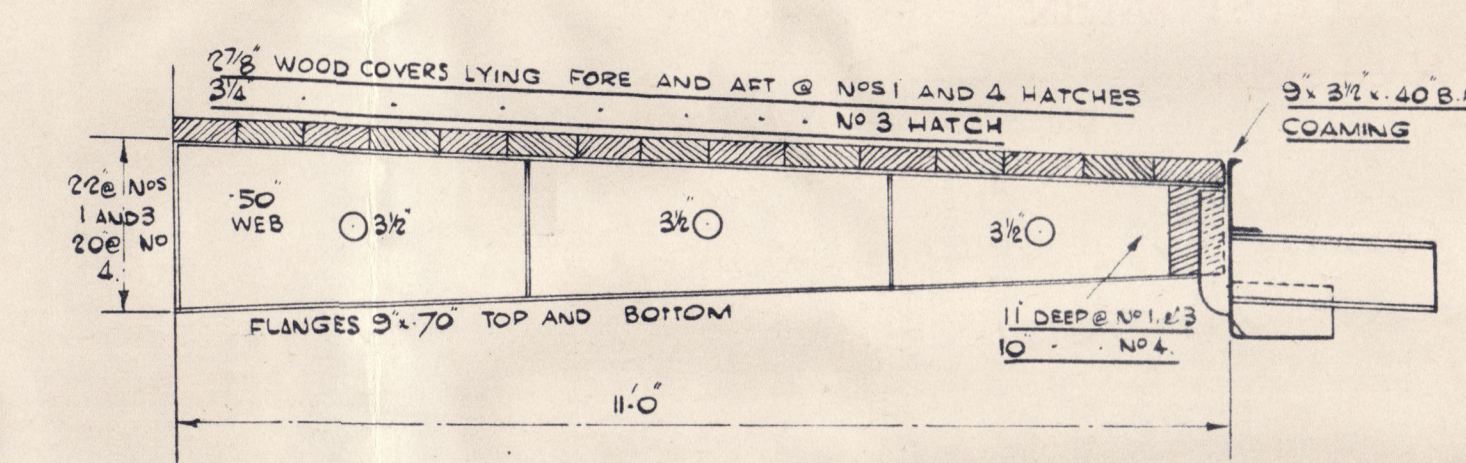

SECTION THROUGH UPPER DECK  
HATCHES NOS 1, 3 AND 4.

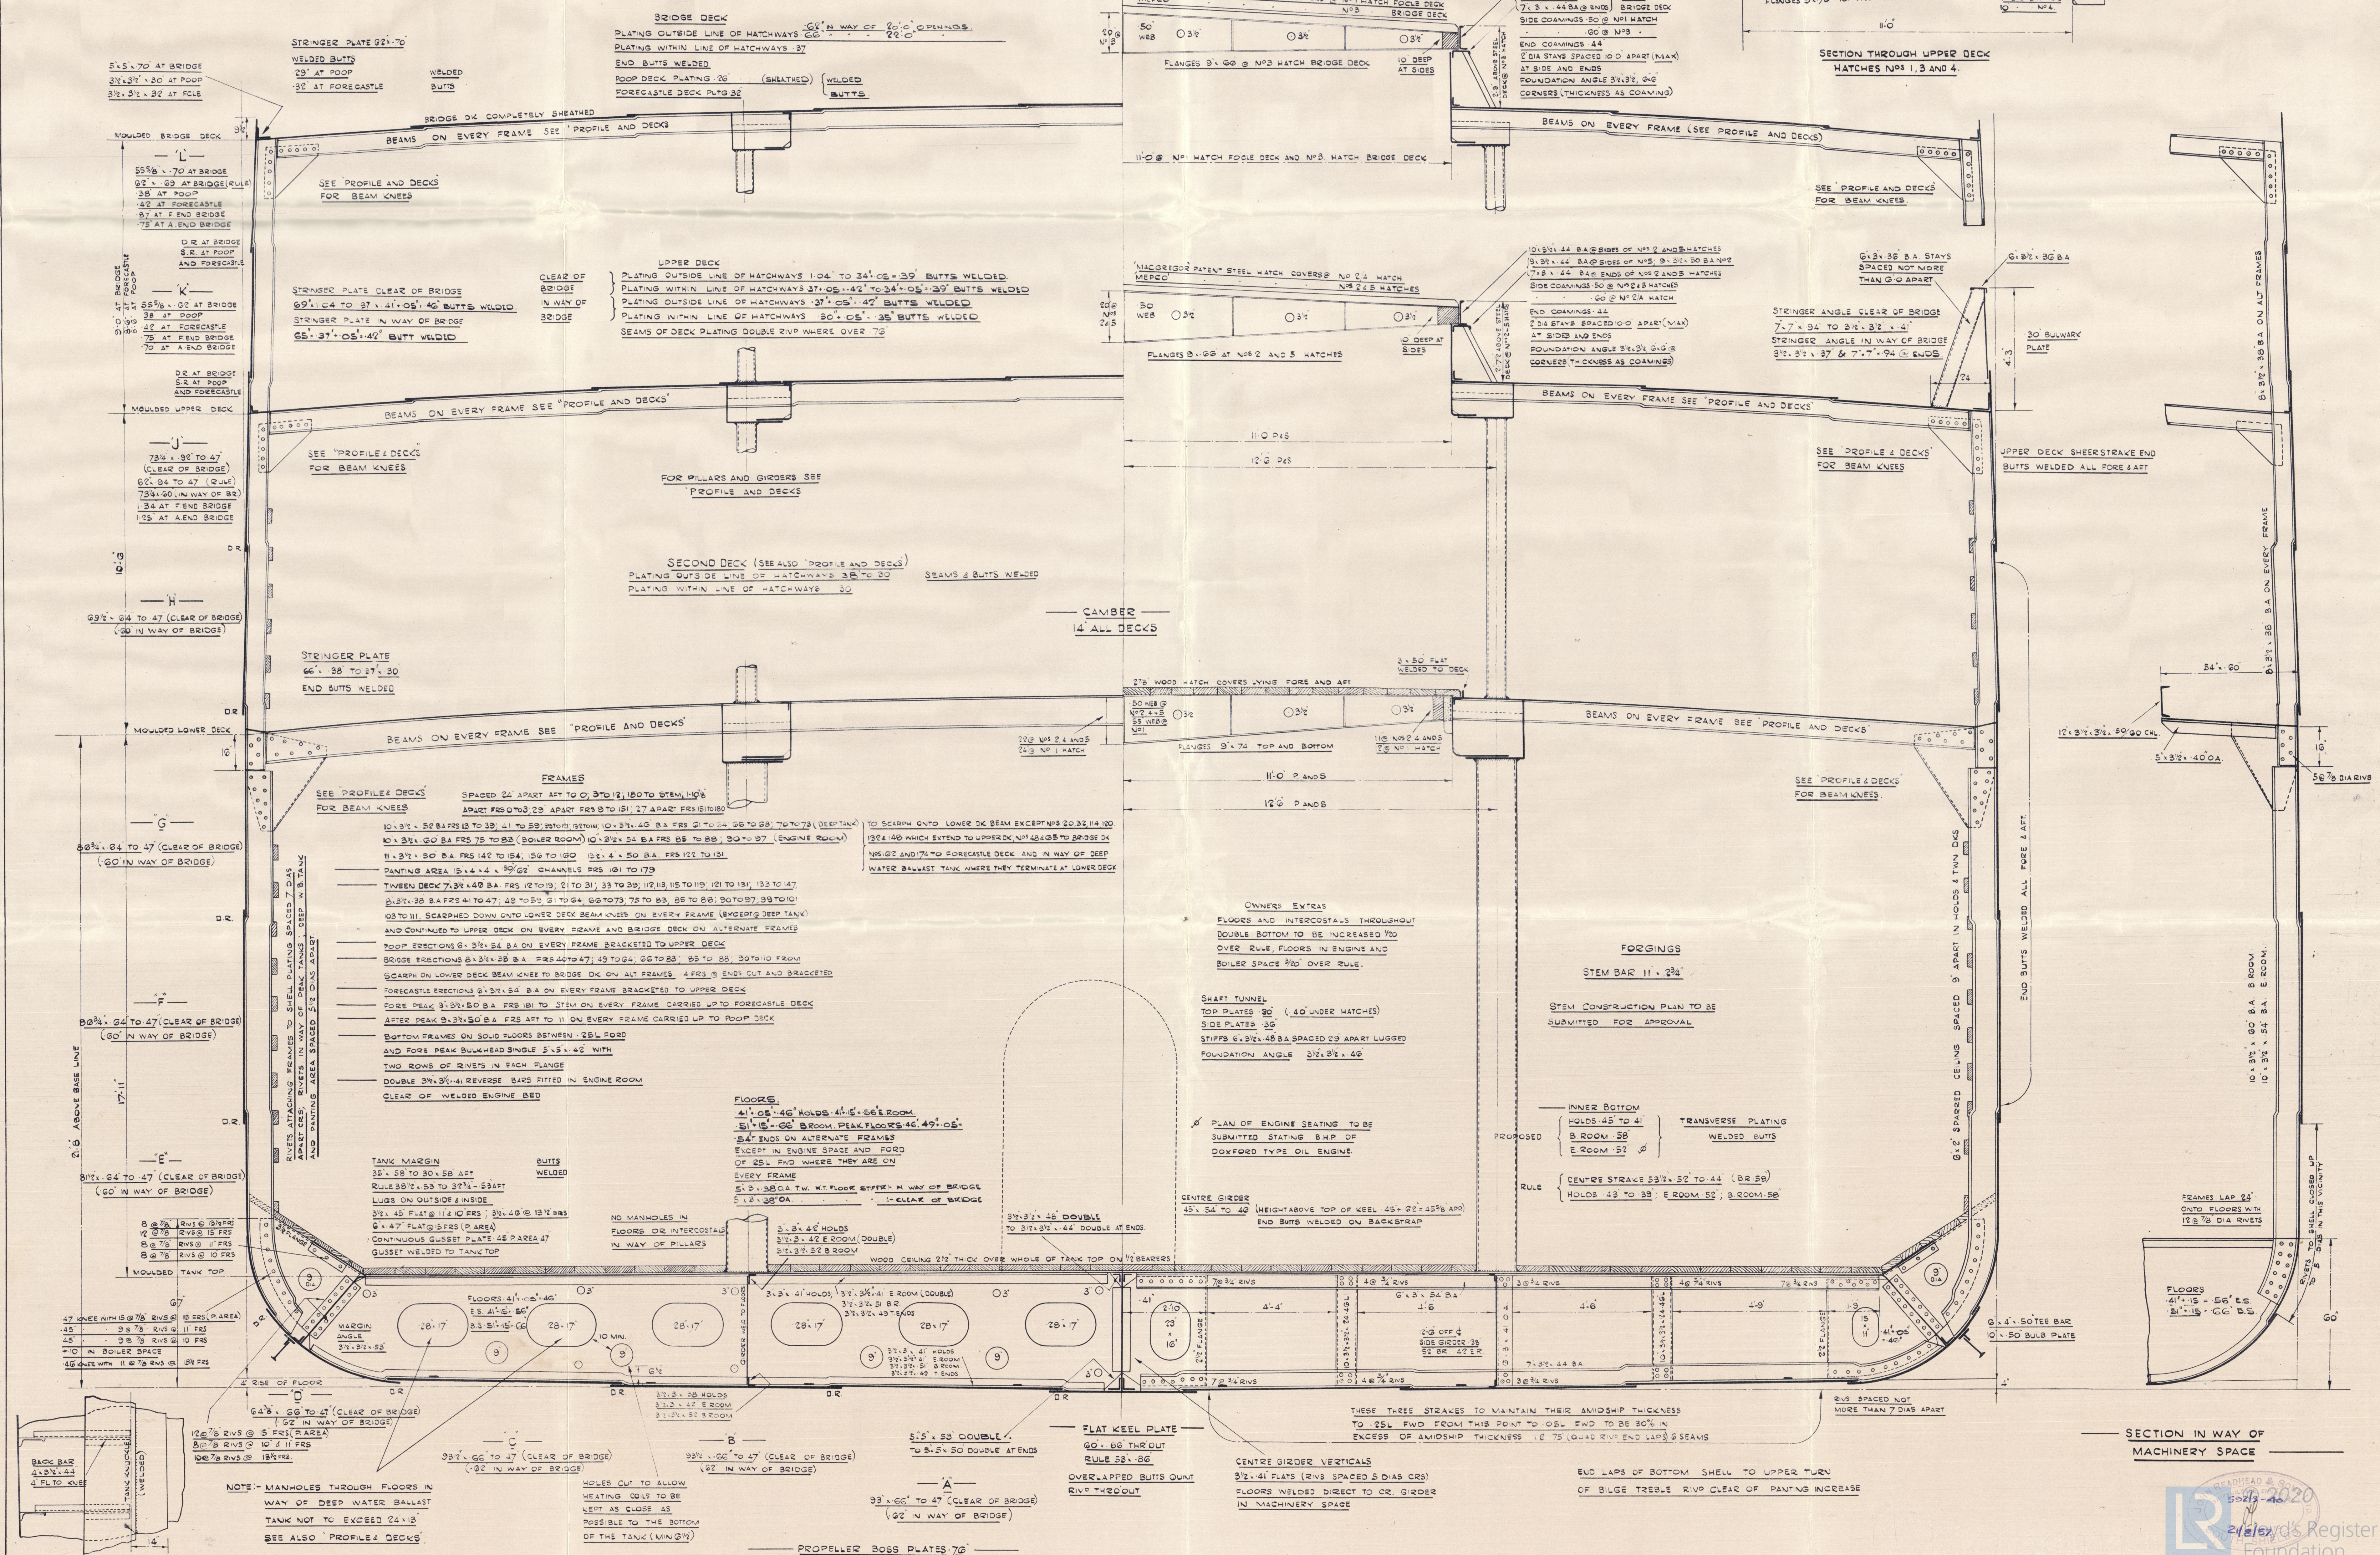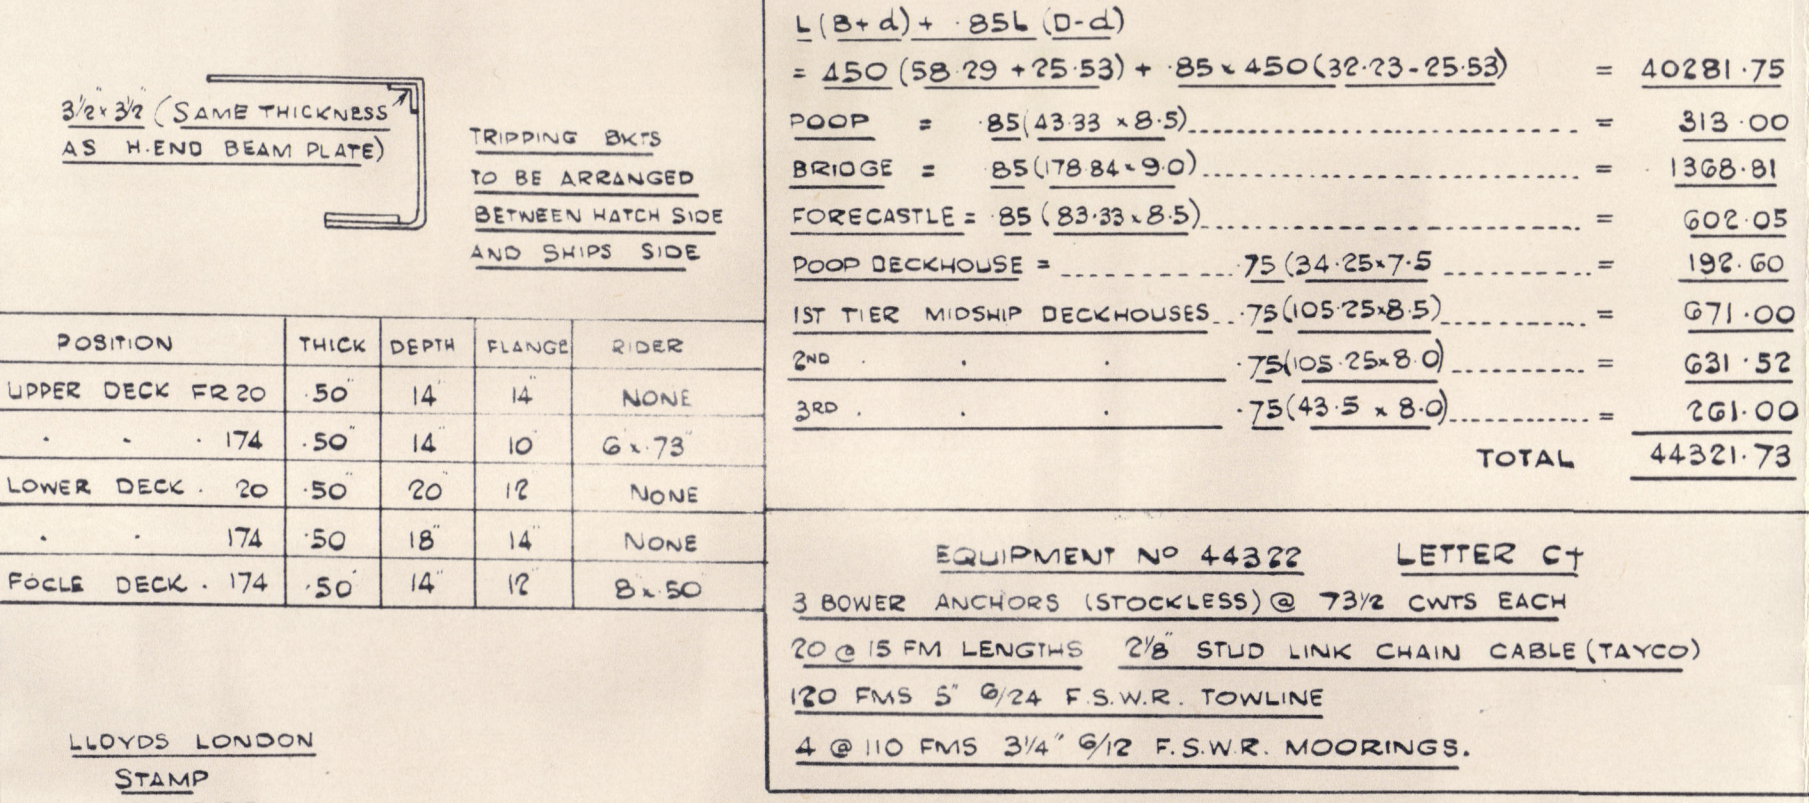

SECTION IN WAY OF  
MACHINERY SPACE



JOHN READHEAD &  
SONS LTD.


YARD No. 592

MIDSHIP SECTION  
(AS FITTED)

SEISTAN  
NEWCASTLE on Tyne  
Report No. 114638  
YARD No 592

RETAIN

004833-004841-0026

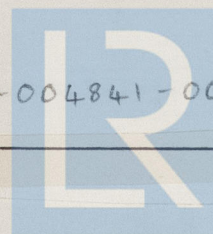

© 2020

Lloyd's Register  
Foundation