


SCALE $\frac{1}{8}" = 1 \text{ FOOT.}$

LENGTH B.P. $264 \cdot 0" \times 38 \cdot 10" \cdot 19 \cdot 5\frac{1}{2}"$ DEPTH MOULDED TO UPPER DS

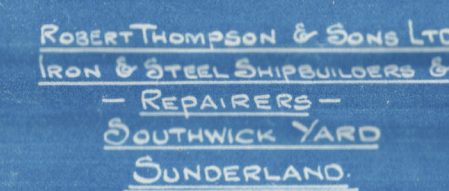

9-7-23

SUNDERLAND

ROBT. THOMPSON + SONS LTD

S. S. No 319

Bramhill

EX
PROFILE


+
DECK.

(AS BUILT)

S S "GWENTLAND"

SUNDERLAND RPT. No. 28617.

RETAIN

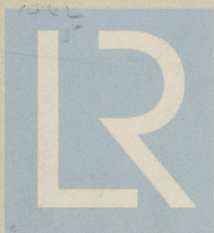

© 2020

Lloyd's Register
Foundation

004852-004860-0123