


LLOYD'S REGISTER OF SHIPPING

UNITED WITH THE BRITISH CORPORATION REGISTER

Ship's Name SS. 'SLEMISH'Official No. 145645

Memorandum of alterations reported since ship was surveyed for assignment of Load Lines in

The following arrangement of hatchways on the Upper Deck in the bunker tweendeck space has been approved at this time:—

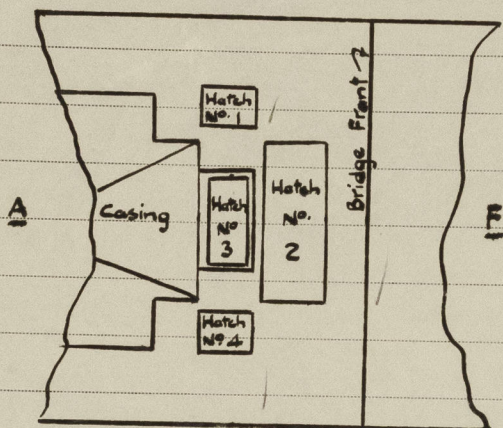

Hatches Nos 1 & 4, 5'-5" x 3'-9", 9" x .44 B.A. coamings.

Hatch No 2, 15'-0" x 6'-0", 9" x .44 B.A. coaming.

Hatch No 3, 8'-6" x 4'-0", 9" x .44 B.A. coaming on 8 1/2" raised platform.

3" W.P. covers fitted to all hatches, with 3" bearing surfaces.

Bleats, battens, wedges and tarpaulins to all hatches in accordance with Rule requirements.

Hatch on Forecastle Deck

A 22" x 18" hatchway with 12" steel coaming, steel hinged W.T. cover secured by toggles, now fitted on Forecastle Deck. This hatchway not to be open at sea.

S.W. Gresham.

Newcastle upon Tyne.

31st July, 1952.

A copy of the above has been placed on board the vessel.

[Signature]

173 AUG 1952



© 2020

Lloyd's Register
Foundation