


## Lloyd's Register of Shipping. SWS. 22819 34 991

Ship's Name CITY OF CAPE TOWN

Official No. 164340

Memorandum of alterations reported since ship was surveyed for assignment of Load Lines  
in Swansen.

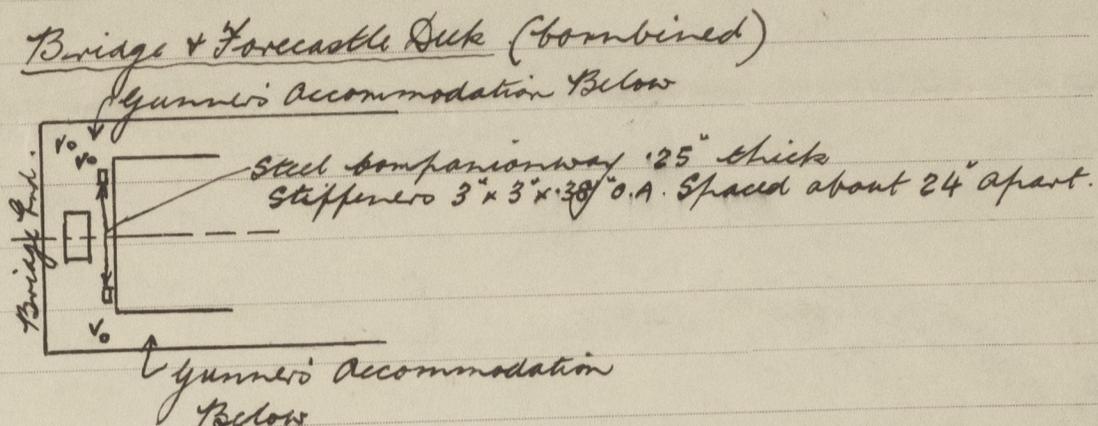

Entrance to gunner's accommodation port & starboard. Solid wood door with 18" coaming above bridge decks. (Fitted in Steel Companionway)


2- 8" dia. ventilators on bridge decks port side to gunner's accommodation below. boamings 36" above bridge decks. 5/16" thick, welded to decks.  
1- 6" dia. ventilator on bridge decks starboard side to gunner's accommodation below. boaming 30" above bridge decks. 5/16" thick, welded to decks.  
Ventilators fitted with wood plugs and canvas covers.

Side scuttles to gunner's accommodation in combined bridge & forecastle 3- 9" dia on port side, 2- 9" dia on starboard side of substantial construction and fitted with hinged deadlights.

1- Sanitary discharge from gunner's accommodation port & starboard about 18" above upper decks fitted with bronze storm valves.

Fee £5-5-0.

Noted  
8/10/41

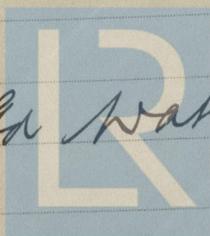

© 2020

Ed Wake

Lloyd's Register  
Foundation

004866-004872-0088