


SCALE: $\frac{1}{2}'' = 1 \text{ FOOT}$

TO BE CLASSED ✕ 100 AILLOYDS REGISTER

2 BOWER ANCHORS, STOCKLESS, EACH 45 CWTs
1 BOWER ANCHOR, STOCKLESS 38 3/4 CWTs ✓
1 STREAM ANCHOR, STOCKLESS 17 1/2 CWTs ✓
270 FMS. 1" 1/16" STUD LINK CABLE (EMERGENCY REQUIREMENTS - 225 FMS)
90 FMS. 4" CIRC. STEEL WIRE ROPE (6" x 12") STREAM WIRE ✓
120 FMS. 4" CIRC. STEEL WIRE ROPE (6" x 12") TOWLINE ✓
2 @ 90 FMS 7" CIRC MANILA HAWSEYS ✓
2 @ 90 FMS 6" CIRC MANILA WARPS ✓

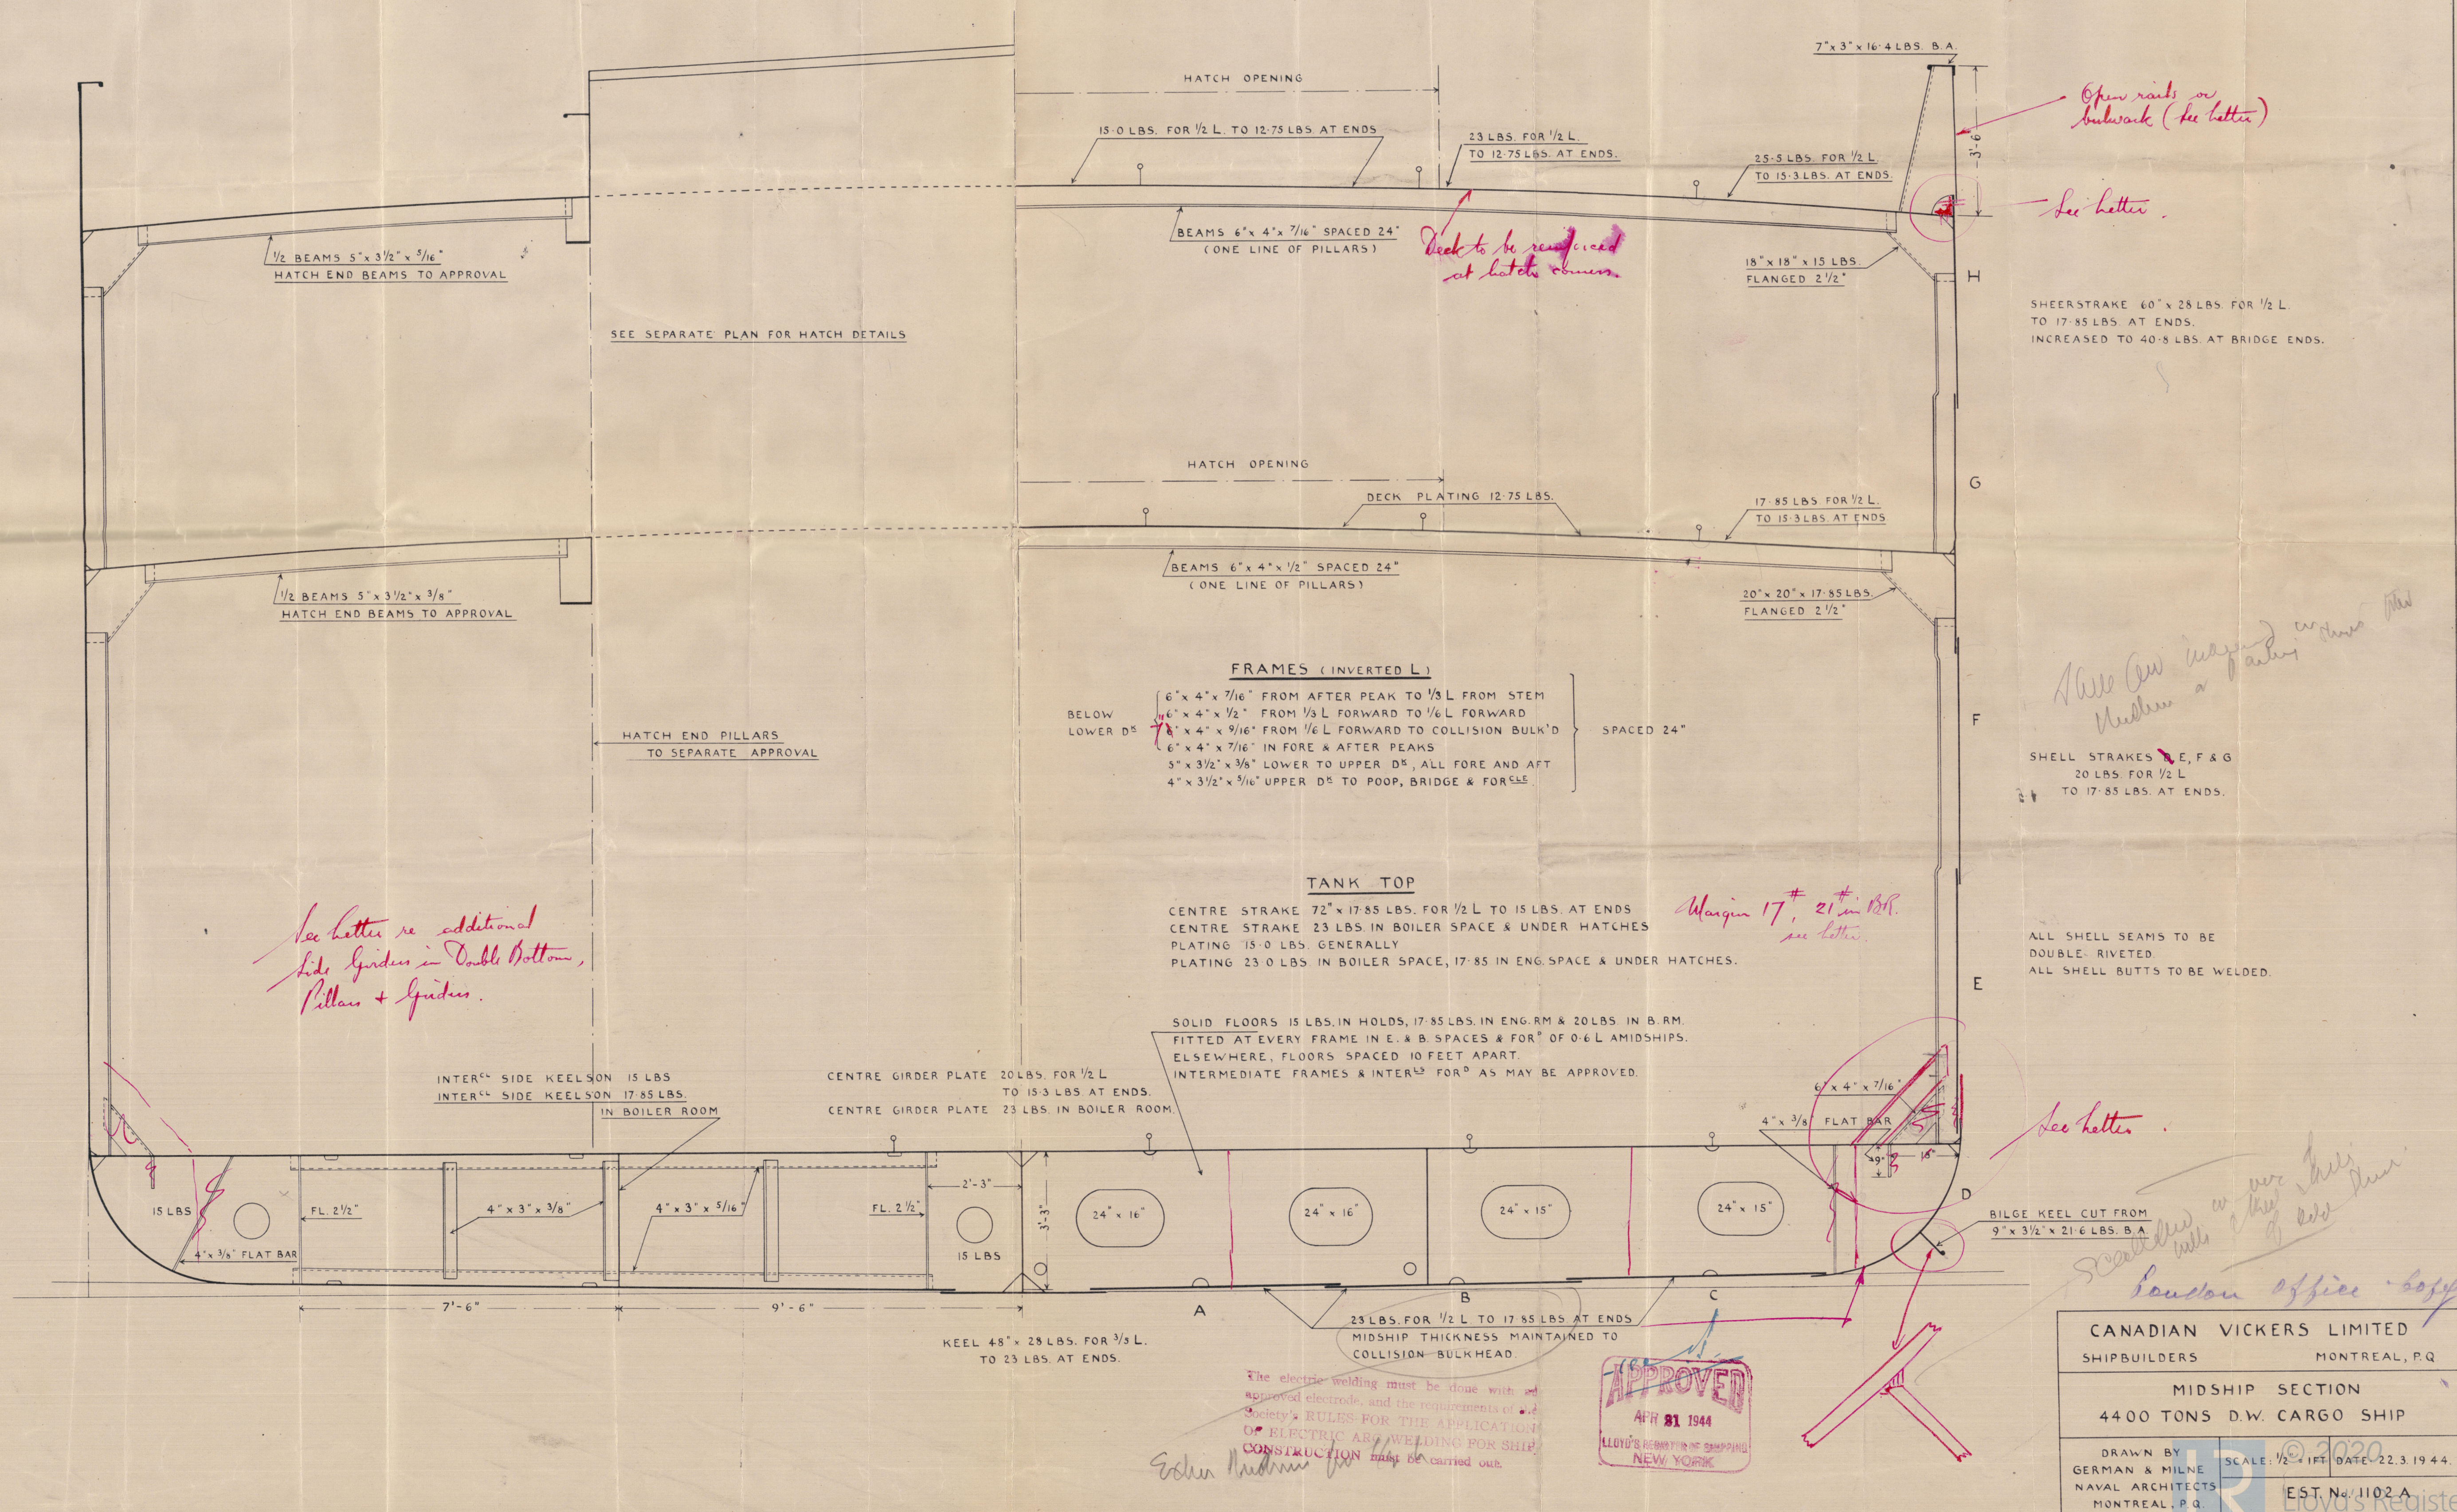

CANADIAN VICKERS LIMITED
SHIPBUILDERS MONTREAL, P.Q.


MIDSHIP SECTION
4400 TONS D.W. CARGO SHIP

DRAWN BY
GERMAN & MILNE
NAVAL ARCHITECTS
MONTREAL, P.Q.

SCALE: 1/2" = 1 FT. DATE: 22.3.1944

EST. No. 1102 A

004866-004877-0222

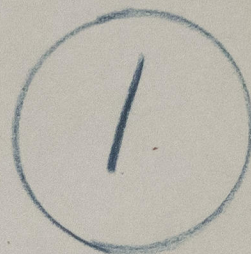

CANADIAN VICKERS LTD.

320' DESIGN
YARD NOS. 210/11/12/13

MIDSHIP SECTION.

"Cabello" X

RETAIN



© 2020

Lloyd's Register
Foundation

004866-004872-0222