

## Lloyd's Register of Shipping. - 4 JUL 1941


DUNDEE REPORT NO 9233.

Ship's Name *CAPE WRATH*

Official No. 165,945

Memorandum of alterations reported since ship was surveyed for assignment of Load Lines in *Livingham* on 1st April, 1941

- (1) Lounage opening in shelter Deck aft. closed by fitting steel plate over opening.
- (2) Wood companionway fitted on top of steel Coaming. Coaming 20" x 44" companionway 5'7" x 3'0" x 7'0" high. Wood door 5'6" x 2'3", sill 24" above deck
- (3) The scuppers from steering gear space blanked off by steel plate. Scuppers from accommodation blanked off. Scuppers from refrigerated spaces in tween decks plated over at ships side & scupper led to bulges.
- (4) Discharge pipe from w.c. aft discharges overboard above the 2nd deck & is fitted with screw down valve at ships side controlled from shelter dk.
- (5) additional accommodation fitted in tonnage well & adjoining tween decks.
- (6) Lifelines fitted fore & aft.
- (7) Two 9" vents to crew spaces aft emgs. 2'6" x 32", closed by wood plugs & canvas covers.
- (8) Two side scuttles 15" dia. 2'0" below shelter dk. fitted with strongly constructed deadlights to gunners accommodation.
- (9) Starboard door in bridge after hbd. closed by steel plate.

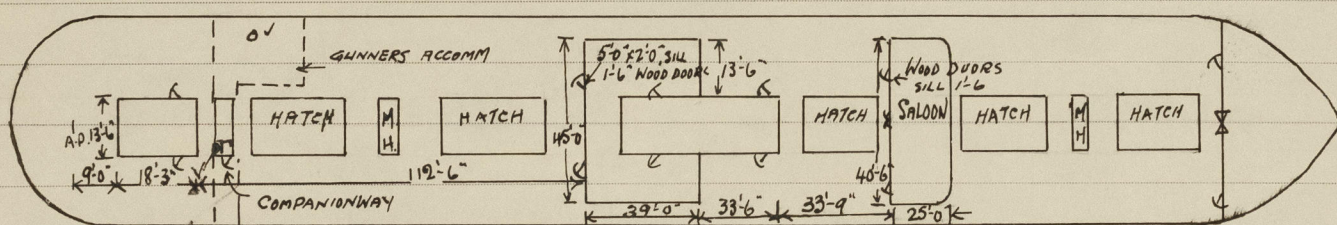

Noted

*W.B.*  
4/7/41

*A.M. Queen*



© 2020

Lloyd's Register  
Foundation