


PARTICULARS OF PROTECTION TO OPENINGS, ETC.

HATCHWAYS ON FREEBOARD AND SUPERSTRUCTURE DECKS											
						BUNKER	HATCHES	IN BRIDGE OR	ON	ON TRUNKS	
Description of Hatchway						BRIDGE	DECK	FL. DECK	FORECASTLE DECK	BETWEEN HATCHES	
Dimensions of Hatchway						6'0" x 14'-11"	6'0" x 3'-0"	6'0" x 2'-6"	2'-0" x 1'-9"	2'-6" x 1'-9"	
COAMINGS	{	Height above Deck	148"	148" ✓	142" ✓	142" ✓	60" ✓	18" ✓	none	15" ✓	18" ✓
		Thickness Sides	144" ✓	144" ✓	144" ✓	144" ✓	30" ✓	30" ✓	✓	30" ✓	30" ✓
		Thickness Ends	144" ✓	144" ✓	144" ✓	144" ✓	30" ✓	30" ✓	✓	30" ✓	30" ✓
		Stiffeners .. B. ANGLES ..	7x3x.40 ✓	7x3x.40 ✓	7x3x.40 ✓	7x3x.40 ✓	3x22x.26 ✓	-	✓	30" ✓	30" ✓
		Brackets, Stays	3 6"x40" ✓	3 6"x40" ✓	3 6"x40" ✓	3 6"x40" ✓	none ✓	none ✓	✓	✓	✓
HATCH BEAMS	{	Number	5	5	5	5	none	none	none	none	none
		Spacing	4'-8"	4'-9 1/2"	4'-8"	4'-8"	none	none	none	none	none
		Scantling and Sketch	 Plate angles	11"x38" ✓	21"x38" ✓	20"x38" ✓	20"x38" ✓	none	none	none	none
			5x3 1/2"x46" ✓	5x3 1/2"x46" ✓	5x3 1/2"x46" ✓	5x3 1/2"x46" ✓	✓	✓	✓	✓	✓
		Bearing Surface	3" ✓	3" ✓	3" ✓	3" ✓	✓	✓	✓	✓	✓
FORE AND AFTERS	{	Number	none	none	none	none	none	none	none	none	
		Spacing	none	none	none	none	none	none	none	none	none
		Unsupported Lengths	none	none	none	none	none	none	none	none	none
		Scantling* and Sketch	none	none	none	none	none	none	none	none	none
		Bearing Surface	none	none	none	none	none	none	none	none	none
HATCH COVERS	{	Material	White wood	White wood	White wood	White wood	White wood	White wood	White wood	White wood	
		Thickness	3"	3"	3"	3"	2 3/4"	2 1/2"	none	2 1/2"	2 1/2"
		How fitted	F & A ✓	F & A ✓	F & A ✓	F & A ✓	F & A ✓	F & A ✓	✓	Solid ✓	Solid ✓
		Bearing Surface	3"	3"	3"	3"	3"	3"	none	2 1/2"	2 1/2"
		Spacing of Cleats	24" & 23"	24" & 23"	24" & 23"	24" & 23"	21" & 28"	15" & 28"	none	18" & 14"	24" & 18"
Number of Tarpaulins		Two ✓	Two ✓	Two ✓	Two ✓	Two ✓	Two ✓	none	Two ✓	Two ✓	

*Are wood fore and afters steel shod at all bearing surfaces? *Yes ✓*

Are battens and wedges efficient and in good condition? *Yes ✓*

Are tarpaulins in good condition and in accordance with rule requirements? *Yes ✓*

Are lashings provided in accordance with rule requirements? *Hatch No 1 & 2 Yes ✓ Hatch No 3 & 4 - none X*

Particulars of fiddle, funnel and ventilator coamings:—
 Fiddle 4'0" high 30 plate 4" x 3" x 30 of stiffeners spaced 30" - 32" ✓
 Funnel Coaming 18" x 125 plate. twisted angle to fiddle top plating. Fiddle gratings covered by strengthened plates. ✓
 2 stockhold Ventilators 18" diameter x 20 plate. 40" high. ✓
 2 Engine Room —" 12 —" x 125 —" 14" ✓
 Engine Room chyl. Light. Hinged & flanged steel flaps 20 plate with glass bulls eyes ✓

Particulars of Flush Bunker Scuttles:—

None ✓

Particulars of Companionways :—

None ✓

Particulars of Ventilators in exposed positions on freeboard and superstructure decks :—

Particulars of Ventilators in exposed position on freeboard and superstructure decks :-														
2	Forecastle Deck	to Capos Quarters	8' dia	x 30	Coaming	x 36" high.	✓	2	Raised Quarters Deck to Hold	18" dia x 35	Coaming	x 36" high.	✓	
1	"	to Fore Peak.	6 "	x 20	"	x 36 "	✓	1	"	Ground	18" "	x 35 "	x 36 "	✓
2	Wing Deck	to Hold	18' "	x 35	"	x 36 "	✓							
1	"	to Hold	18' "	x 35	"	x 24 "	✓							
all fitted with wood covers & canvas hoods ✓														

Particulars of Air Pipes in exposed positions on freeboard, raised quarter, or superstructure decks :—

Particulars of Air Pipes in exposed positions on freeboard, raised quarter, or superstructure decks:			
1	Forecastle deck (Protected by Rain Plate + Breast plate. Cast Iron)	3 1/2"	dia x 13" high ✓
1	Well deck (—" Forecastle Bulkhead)	3 1/2"	" x 15" " ✓
-2	" " " "	3 1/2"	" x 8 1/2" " ✓
2	Bridge deck	3 1/2"	" x 20" " ✓
2	Raised Quarter Deck	3 1/2"	" x 36" " ✓
1	" " " "	3 1/2"	" x 15" " ✓

wood plugs as closing

Good Plugs and
Canoe covers not
fitted.
without snifting holes

Particulars of Gangway Cargo and Coaling Ports:—

None ✓

5. 1-1.

Particulars of Scuppers and Sanitary Discharge Pipes —

Inlets of Scuppers and Sanitary Discharge Pipes —					
1.	Sanitary discharge Pipes	in Forecastle (above Raibord deck)	3 1/2" diameter.	no Valve fitted.	Port side ✓
1	" "	in Bridge { " " Raised Cast-iron Deck }	3 1/2" "	" "	" " ✓
2	" "	" " { " " " " }	2" "	" "	" " ✓
1	" "	in Machinery Space through R. & Deck	3 1/2" "	Brass non-return valve on	Starboard side ✓

Particulars of Side Scuttles :

In Forecastle sides.	9'	diameters, with hinged deadlights.	✓
In " Bulkhead	9'	" " " without hinged deadlights.	✓
In Bridge	9'	" " " with hinged deadlights.	✓
In Bridge Foot	13"	" " " without hinged deadlights.	✓

Particulars of Guard Rails :—

Forecastle deck. 3'-3" high, spaced 4'-7" apart. 2 Raibs ✓
Bridge deck 3'-0" —, — " 4'-11" —. 2 Raibs ✓

Particulars of Gangways, Lifelines, etc. :—

In well. Over hatchways stanchions 3'-0" high. Spaced 5'-10" apart.
1 life line (not a wire rope) ✓

Particulars of Freeing Arrangements.						
	Length of Bulwark	Height of Bulwark	Size of Freeing Ports	Number each side	Area each side	Rule area each side
Aft Well R.A. Deck ...	95'-0" ✓	3'-9"	2'-9" + 18" 30" x 18"	3- } 4 }	10-25 ✓	19 φ
Forward Well ...	74-5½ ✓	3'-11"	33" x 18"	4	21-50 ✓	14-89 φ

State position of each freeing port ... { Aft Well : - 1FT 4' 2 1/4" - 27' 5" - 24' 6" = 28' 6" 593 from keel height.
(F. and A. position and height above deck edge) { Forward Well : - 1FT 4' - 6' 0" - 15' 0" - 16' 4" = 16' 4" } 102 above deck. ✓

State whether the freeing ports are fitted with shutters, bars, or rails, and give particulars of such :-
1 Bar at half height. ✓


Additional area where sheer is less than standard.

Particulars of Superstructures, Trunks, Casings, Deckhouses.								
	Coaming	Plating	Stiffeners	Spacing	End Attachments of Stiffeners	Size of Openings	Height of Sills	Height of Casings
Poop Bulkhead	✓							
Raised Quarter Deck Bulkhead ...	✓							
Bridge, After Bulkhead	30 ✓	25 ✓	4" x 8" x 30" OA ✓	30" - 38" ✓	Full height ✓	5'-2" x 1'-10" ✓	18" ✓	7'-2" ✓
Bridge, Forward Bulkhead	38 ✓	34 ✓	7 1/2" x 8" x 38" BA ✓	30" ✓	Bracket ✓	none ✓	—	—
Forecastle Bulkhead	26 ✓	26 ✓	3 x 2 1/2" x 26" OA ✓	30 - 32 ✓	Full height ✓	3'-2" x 1'-10" ✓	18" ✓	7'-5 1/2" ✓
Trunk, Aft	✓							
Trunk, Forward	✓							
Exposed Machinery Casings on Fore- board or Raised Quarter Decks ...	30 ✓	25 ✓	4" x 3" x 30" OA ✓	30 - 32 ✓	Full height ✓	30" x 24" ✓	18" ✓	7'-2" ✓
Exposed Machinery Casings on Super- structure Decks	30 ✓	30 ✓	3 x 2 1/2" x 30" OA ✓	24 - 30 ✓	Bracket at top ✓	none ✓	—	4'-0" ✓
Machinery Casings within Superstruc- tures not fitted with Class I Closing Appliances	✓		4 x 3 x 30 "					
Deckhouses on Flush Deck Ships ...	✓							

Particulars of Closing Appliances (state if capable of being manipulated from both sides).

Poop Bulkhead	✓	
Raised Quarter Deck Bulkhead	✓	
Bridge, After Bulkhead		Hinged hardwood doors 2" thick. Can be opened from both sides ✓
Bridge, Forward Bulkhead		no openings ✓
Forecastle Bulkhead		Slid doors & plate & hinged hardwood doors 2" thick. Can be opened from both sides
Bridge Machinery Casings Fore		1 each side 30" x 24" - no doors - 18" lills. <i>sturdy constructed doors capable of being securely closed</i>
Exposed Machinery Casings on Superstructure Decks		no openings ✓
Machinery Casings within Superstructures not fitted with Class I Closing Appliances	✗	
Deckhouses on Flush Deck Ships	✓	




Superstructure bulkheads, trunks, deckhouses, casings, cargo and coaling hatchways, extent and thickness of sheathing on the freeboard deck, gangway, cargo and coaling ports, and any other openings, etc., which would affect the seaworthiness of the ship are to be shewn on the following sketches:—

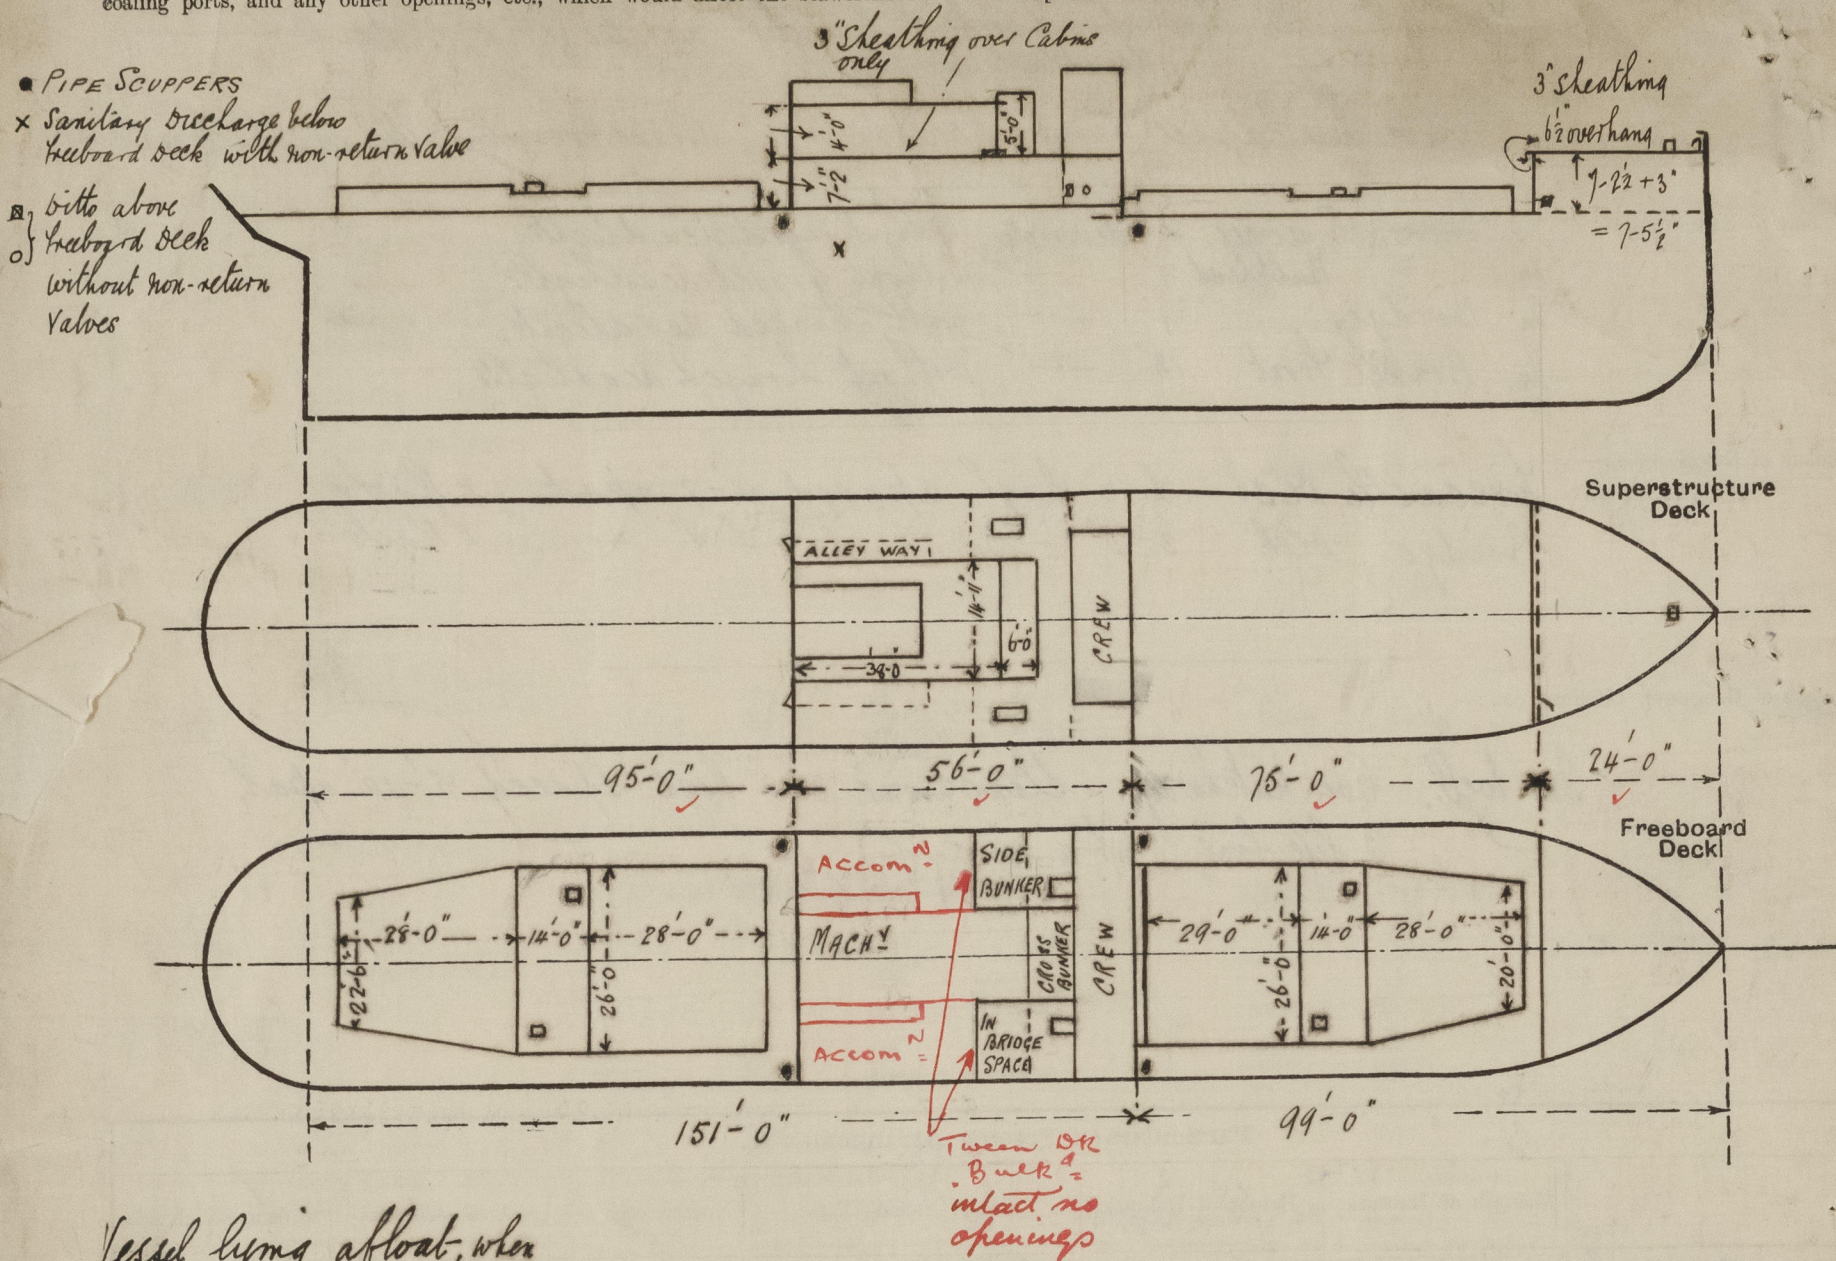

Vessel lying afloat, when
 particulars were obtained.

State any special features in the construction of the ship:—

Continuation of Raised Quarters &
 well decks

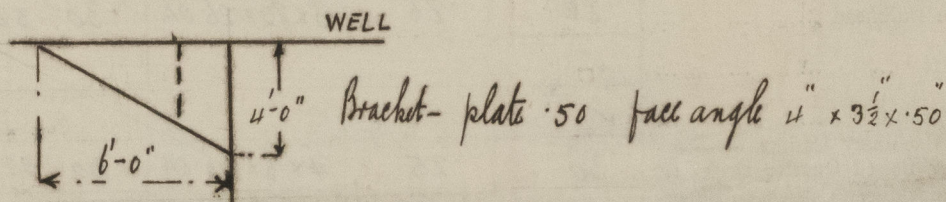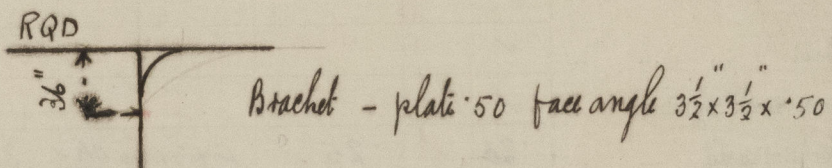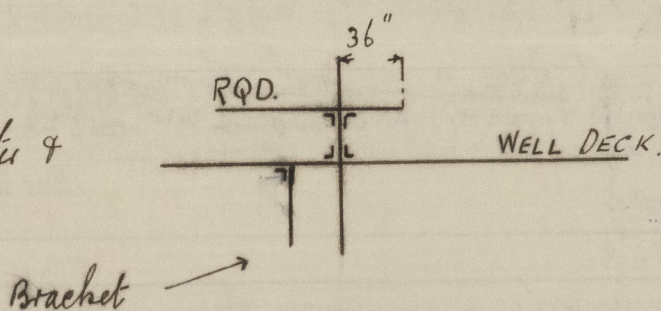

Builder's name and yard number Goole S.H. Co (1927) Ltd. Yard No 291

Names of sister ships

Owners Kiloway Shipping Co. Ltd. (J.R. Lisher & Co. Ltd. Mgrs)

Fee £ 9 : 7 : 0

Received by me



© 2021

Lloyd's Register
 Foundation