

Lloyd's Register of Shipping.

No. 3126.

21 OCT 1941

Ship's Name N. V. "PORT ALMA"Official No. 160615

Memorandum of alterations reported since ship was surveyed for assignment of Load Lines in

The tonnage opening has been permanently closed by bolting down all wood hatches and caulking seams and ends, over this a $\frac{1}{4}$ " steel plate fitted and welded round edge to coaming and round small hatch for magazine. Along the centre and athwartship a $3" \times \frac{1}{2}"$ flat bar welded on plate, this bolted to athwartship beam.

The freeing port openings in the tonnage well have been permanently closed by welding in plates of equal weight as ship's side plates.

All overboard scuppers draining from the shelter tween deck have been permanently closed by electric welding steel plates over their openings in the shell. The tween decks are now efficiently drained to the bilges, P. & S. admidships to engine room bilges, P. & S. aft to tunnel bilges.

No cargo doors or side scuttles fitted in shelter tween deck.

Suitable provision is provided for rigging life lines.


Forecastle Bulkhead. Plating $\frac{3}{8}"$ - $3\frac{1}{2}" \times 3" \times 7/20"$ 24" apart, no end attachments.

Openings in front - 4 hinged steel doors operated from both sides $60" \times 24" \times 12"$ coaming. 1 Steel hinged W.T. door operated from both sides $54" \times 24" \times 21"$ coaming. 1 Steel door in halves at end of alleyway operated from both sides $60" \times 33" \times 12"$ coaming. 14 Wood doors $59" \times 24" \times 14"$ coaming.

Forecastle. 62'0" long 7'6" beam to beam.

Distance from forecastle front to bridge house front and commencement of steel bulwark 102'0", steel bulwarks for 164'0". 3 Freeing ports P. & S. in same $2'9" \times 12"$ deep 12" above deck with hinged shutters and protection bar.

The new freeboard deck is wood sheathed 3" thick and the statutory deck line has been cut in at the sides at the line of wood sheathing, freeboards assigned, markings cut in and verified.

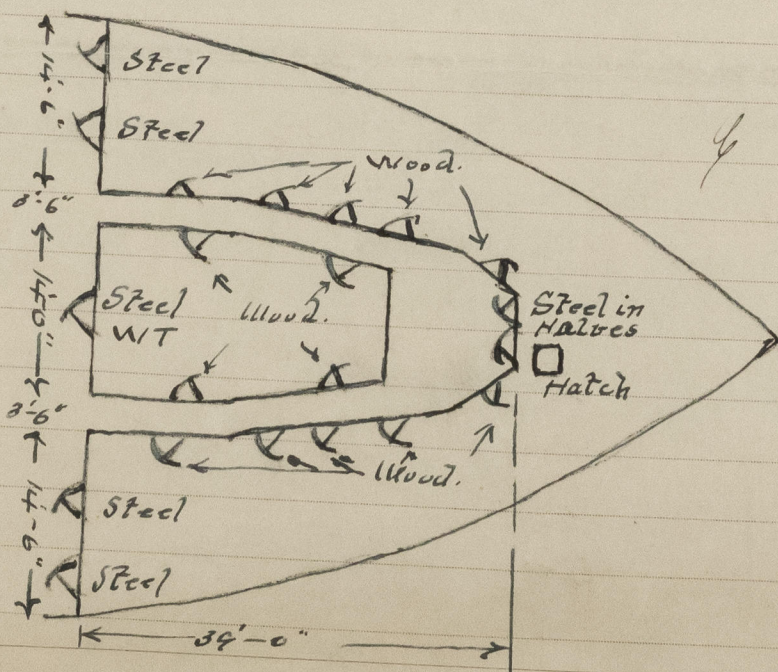

Fee . £6. 5. 0.
Cable. 2. 14. 6.
Expenses 6. 0. 0.

*Noted
see copy of official
attached
to
22/10/41*

Harold Liagett
SURVEYOR TO LLOYD'S REGISTER
WELLINGTON, N.Z.

4th Aug 1941