

PLAN NO. 2.

SHIP NO. 338.

PROFILE AND DECK PLAN.

SCALE: $\frac{1}{8}$ INCH = ONE FOOT

DIMENSIONS


LENGTH B.P. 211'-0"

BREADTH MLD. 35'-0"


DEPTH MLD. (SECOND DECK) 13'-6"

DEPTH MLD. (UPPER DECK) 21'-0"

CLASS 100 A1 LLOYDS WITH FREEBOARD
CORRESPONDING TO A C.S.S. VESSEL
WITHOUT TONNAGE OPENING
FORE PEAK BULKHEAD TO UPPER DECK
REMAINDER OF BULKHEADS TO SECOND DECK

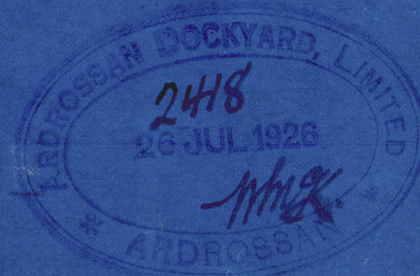

$\lambda = B.A.$ on Hatch and or Riffened.
by which girder to Surveys satisfaction.

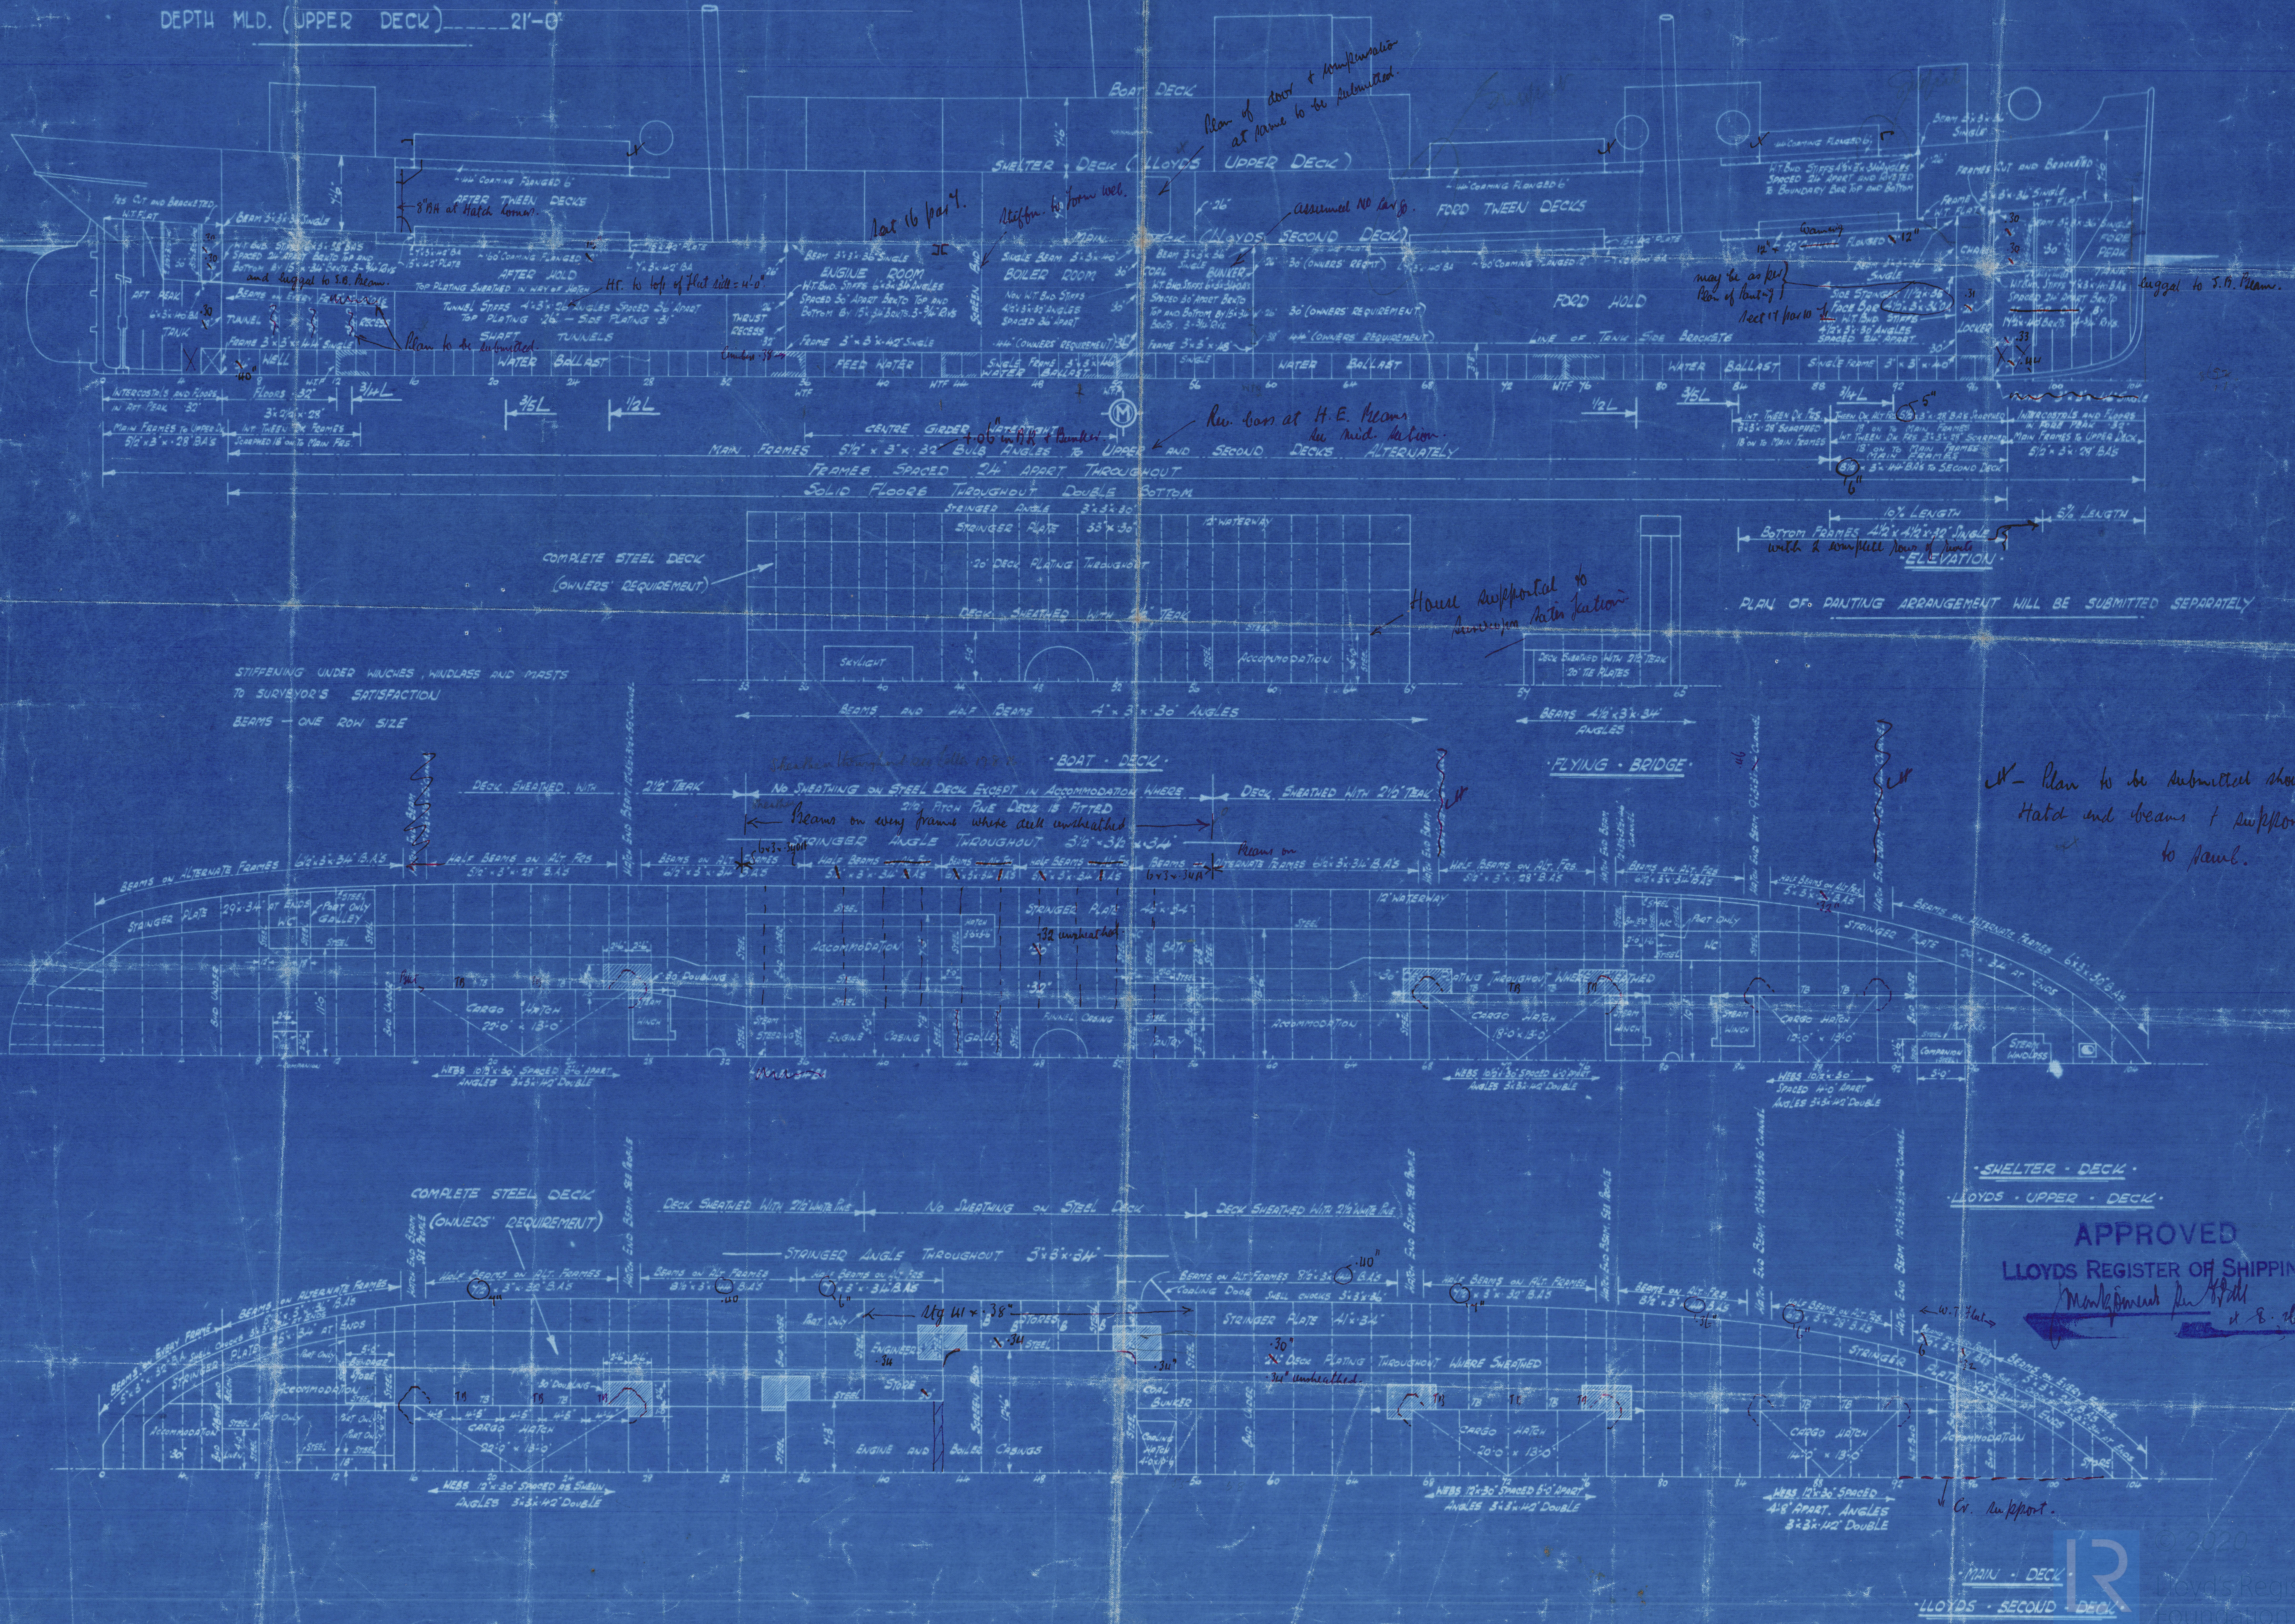

Ardrrossan No 338

Profile & Deck Plan

"BOUNDARY"

Howena

GLASGOW REPORT No 47103

Ardrrossan Dockyard Ltd

No 338



© 2020

Lloyd's Register
Foundation

004900-004905-0146

ENCLOSURE
N^o 410
"JUSTO"

004900-004905-0146



© 2020

Lloyd's Register
Foundation