

37685

37685

Rpt. C. 11 (Contd.)

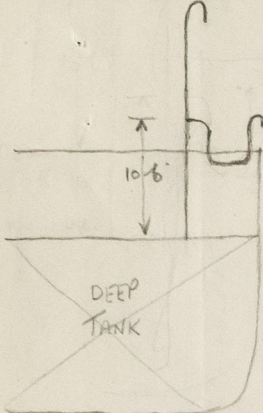
"SUNLIGHT"

Index No. FBD 3904

Lloyd's Register of Shipping.

Ship's Name *S. S. "BARTON GRANGE"* Official No. 169514

Memorandum of alterations reported since ship was surveyed for assignment of Load Lines in _____

Originally to
boat deck

a 6" bore branch taken from existing 6" air pipe, p. & o. to midship's deep tank below main dk., led under dk. to the ship's side, and thro' the dk to a height of 1'6" to opening. Fitted with gauge.

A copy of this memorandum has been placed on board the vessel.

James S. Greenhalgh.
11th. May, 1950.



Noted
[Signature]