


No 267 & 9 SHIPS.

OUTLINE MIDSHIP SECTION SHOWING SHELL PLATING.

SCALE :- $\frac{1}{2}'' = 1 \text{ FT.}$

1st Transverse 44.83
2nd Long. 89.55

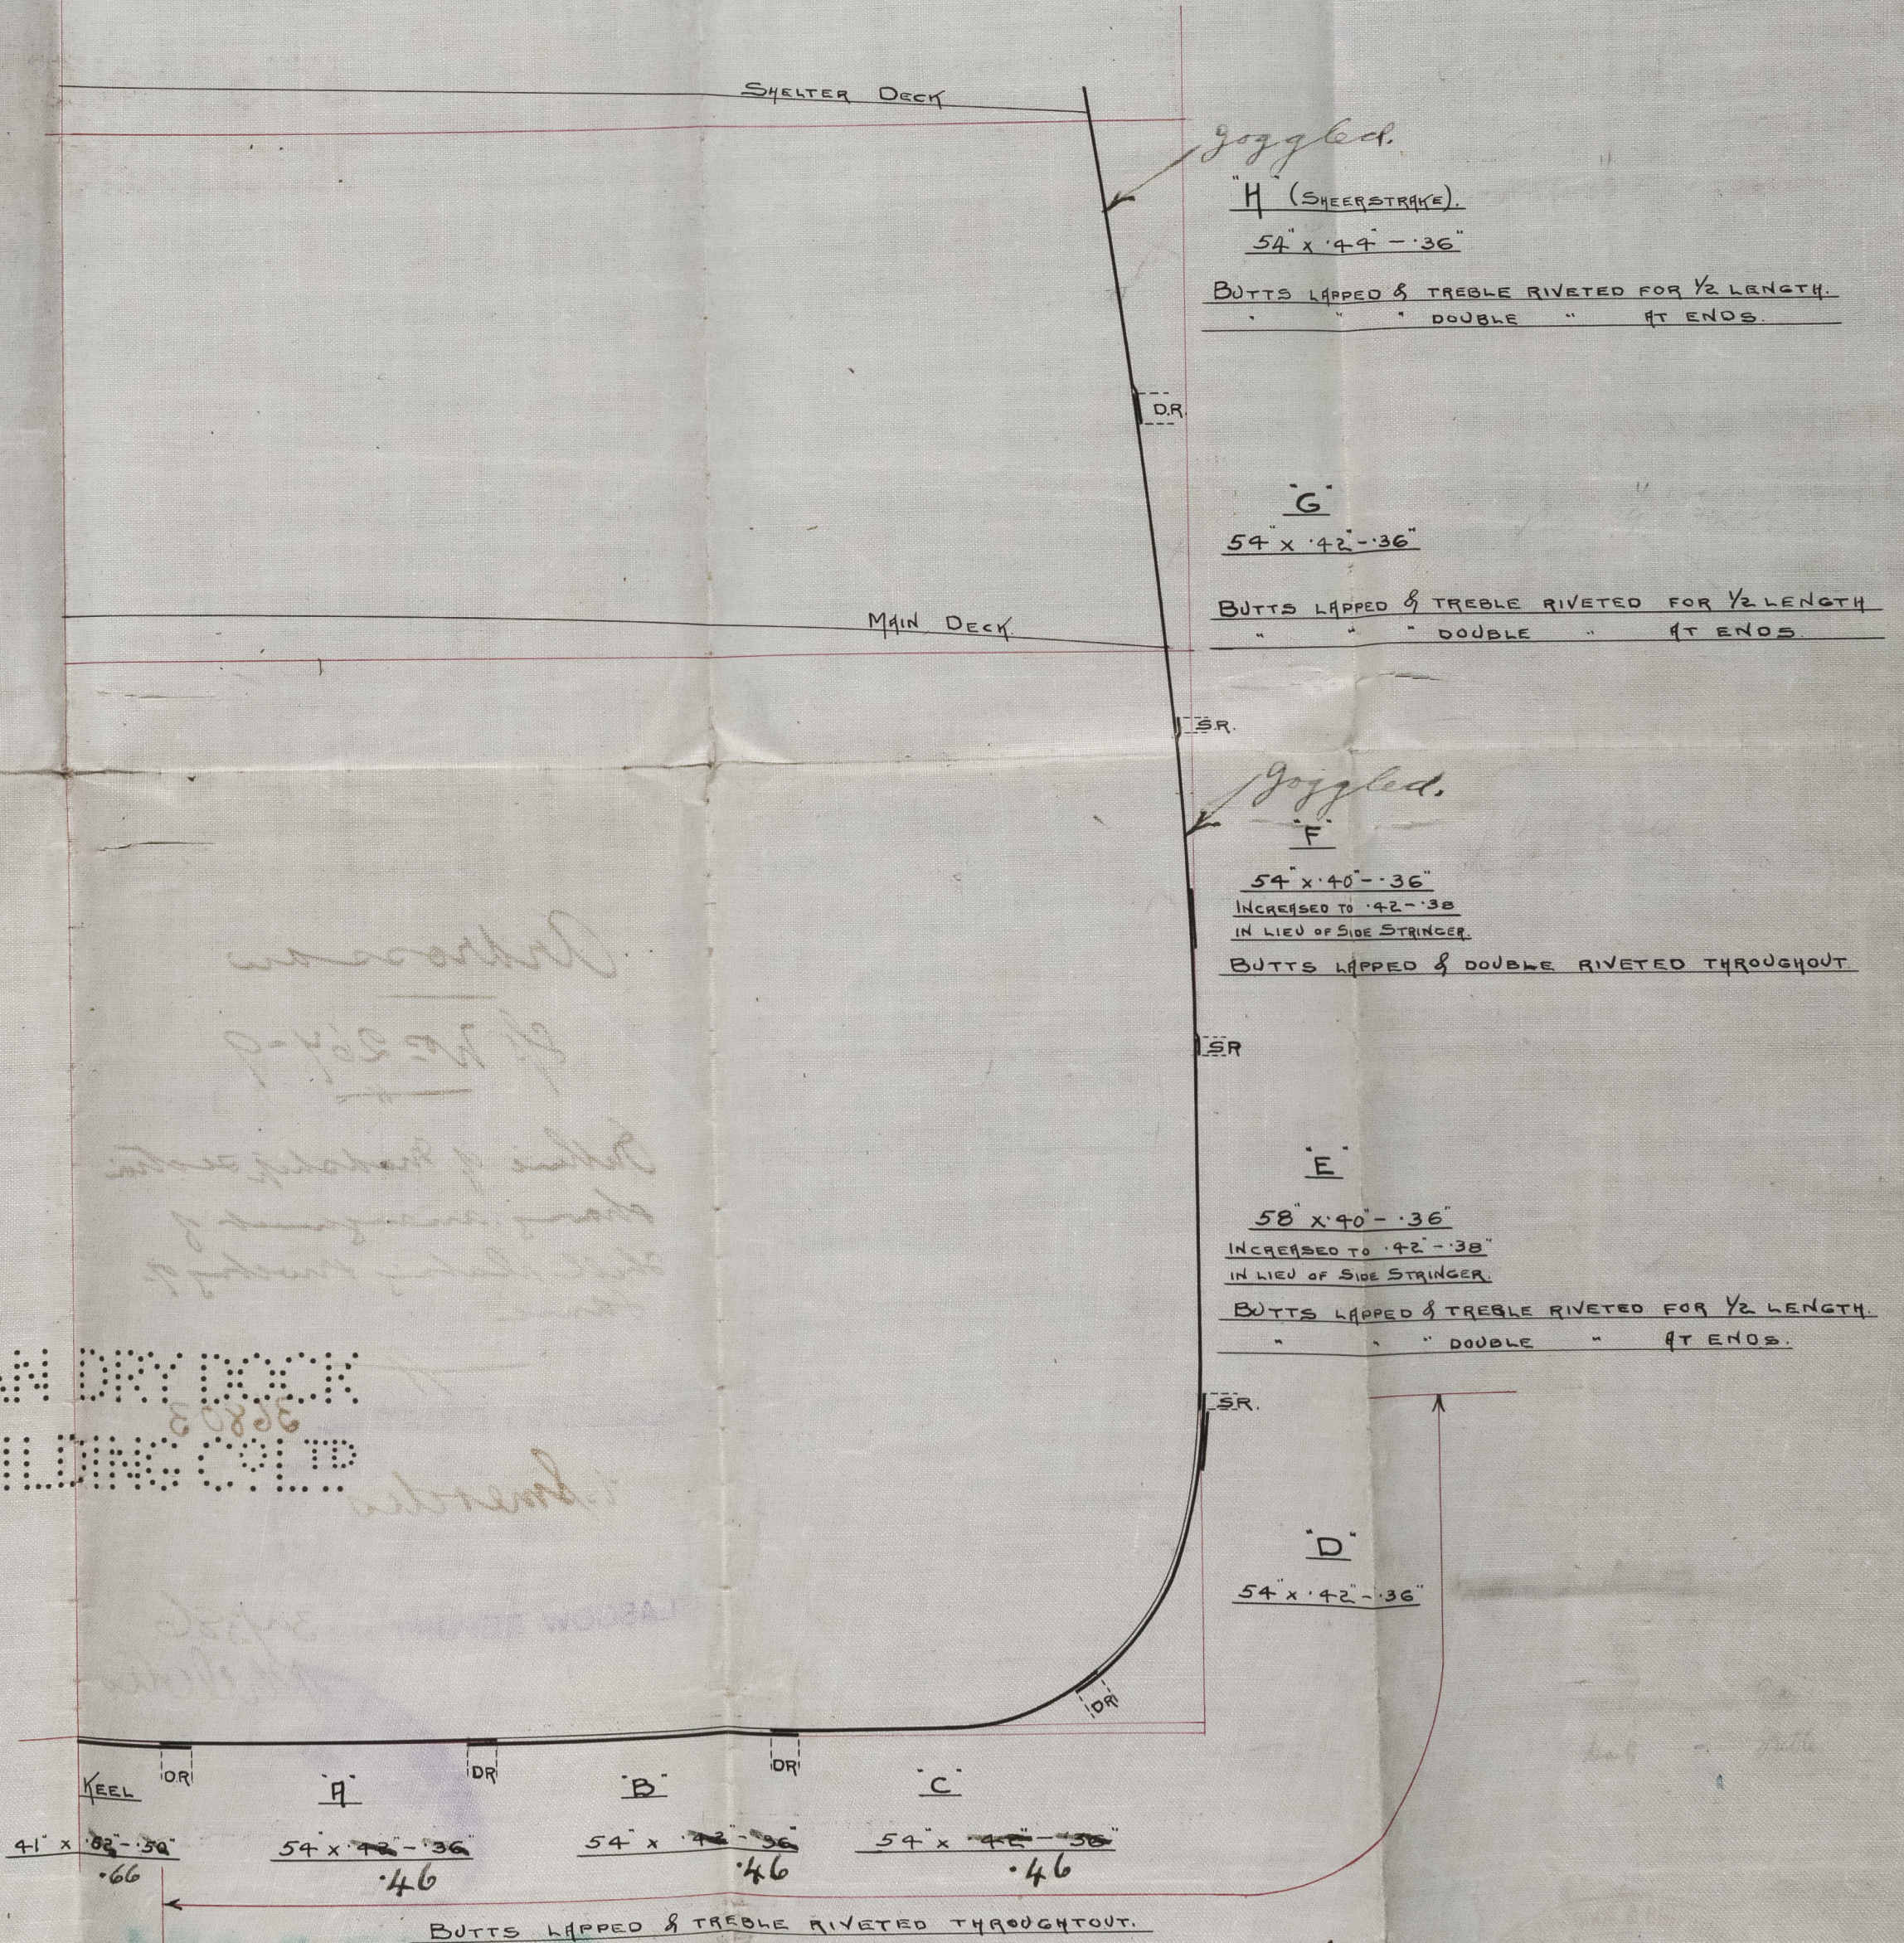

ADDRESS: DRY DOCK
& SHIPBUILDING CO. LTD.

W.P.B.
1/4/15

© 2021

Lloyd's Register
Foundation

005029-005037-0167

Androssau

Sfs No 264-9

Outline of midship section
showing arrangement of
shell plating structure of
same

—//—

GLASGOW REPORT No.

36803

Smerdis

GLASGOW REPORT No.

347386

Philotis



© 2021

Lloyd's Register
Foundation

005029.005037-0167