

Lloyd's Register of British & Foreign Shipping.

36803  
24088.

SURVEYS FOR FREEBOARD.-STEAM SHIPS.

PARTICULARS RELATING TO ALL STEAM SHIPS EITHER FLUSH DECKED, OR WITH TOP GALLANT FORECASTLES, SHORT POOPS AND BRIDGE HOUSES DISCONNECTED, OR WITH TOP GALLANT FORECASTLES HAVING LONG POOPS, OR RAISED QUARTER DECKS CONNECTED WITH BRIDGE HOUSES, OR OTHERWISE.

Port of Survey Ardronau  
Date of Survey Budding  
Name of Surveyor Harry G. Forrest

Ship's Name. <u>"SMERDIS"</u> <u>Ardronau No. 267</u>	Port of Registry and Nationality. <u>Cardiff</u> <u>British</u>	Official Number. <u>137839</u>	Gross Tonnage.	Date of Build. <u>1917</u>	Particulars of Classification. <u>+100 A.1. Shelter Dk.</u> <u>(Class contemplated)</u>
---	---	-----------------------------------	----------------	-------------------------------	---

Registered dimensions from Ship's Register.	LENGTH. <u>200.4</u>	BREADTH. <u>30.7</u>	DEPTH. <u>12.1</u> <u>Depth to tank = 12.33</u>	UNDER DECK TONNAGE. <u>594.06</u>
Length on LOADLINE.	<u>199.5</u>	Frame Depth Rule <u>5 1/2</u>	Ceiling fitted <u>Peak</u>	Tanks <u>2 tank drops</u>
CORRECTED DIMENSIONS.	<u>199.5</u>	<u>- .33</u>	<u>+ .16</u>	<u>594.06</u>

Moulded Depth as measured..... 14.4 by beam Dk  
21 1/4 to Shelter Dk.

NOTE. - If the depth is measured when vessel is afloat, the details of measurement should be reported.

CORRECTION FOR LENGTH.

Length of Ship on Loadline.....	<u>199.75</u>
Length in Table .....	<u>172.00</u>
Difference .....	<u>27.75</u>
Correction for 10ft., Table A. ....	<u>.10</u> Table C.
× Difference divided by 10 .....	<u>2.77</u> (if required.)
If 1/10ths length covered divide by 2	<u>+ 1 1/2</u> ✓

Co-efficient of fineness..... .75  
Any modification necessary [Para. 4 (a) to (e)]\*  
Co-efficient as corrected ..... .75

CORRECTION FOR IRON DECK.

Proportion covered, if less than 1/10ths length covered ....	
Thickness of usual wood deck, less stringer .....	<u>3 1/2 - 1/2</u> <u>3 1/2</u> - <u>3</u>

Sheer { Stem..... 72 } 108 ÷ 2 = 54 ... Mean  
at { Sternpost ... 36 } 3624.05  
.66

Sheer at 1/3 of the length from { Stem 39.5 } 59.5 ÷ 2 = 29.75 Mean  
Sternpost 20 } 55% = 54

Gradual mean Sheer ..... 54.1  
Standard mean Sheer [Table, Para. 18] ..... 32.95 Correction  
Difference..... 24.05 ÷ 4 = -6"

§ If limited as Para. 18 (f).....

CORRECTION FOR ROUND OF BEAM.

Breadth at Gunwale amidships.....	<u>29.9</u>
Round of Beam .....	<u>1 1/2</u>
Normal round.....	<u>1 1/2</u>
Difference .....	<u>÷ 2 =</u>
Proportion of Deck uncovered (Para. 19) .....	✓

NOTE. - The round of beam should be reported on the full breadth of vessel at the gunwale.

Rise in Sheer { At front of bridge house..... } ✓  
from amidships { [Para. 18 (e)] At after end of forecastle .....

¶ Fall in Sheer { }  
Para. 18 (d) { } ÷ 2 = ✓  
Length uncovered ..... Correction

Freeboard, Table A .....	<u>2 - 3 1/2</u>
Correction for Sheer .....	<u>- 6</u>
Correction for Length .....	<u>+ 1 1/2</u>
Allowance for Deck Erections .....	<u>1 - 11 1/4</u>
Correction for Round of Beam.....	<u>0 - 11 1/4</u>
Correction for fall in Sheer (if any).....	
Correction for Iron Deck (if required) .....	<u>3</u>
Height of Shelter, tween decks	<u>0 - 8 1/4</u>
Additions for non-compliance with provisions of Para. 11 (d) and (e) †	<u>7 - 0</u>
Other Corrections (if any) Allowance for closing tonnage opening	<u>7 - 8 1/4</u>
	<u>1 - 4</u>

ALLOWANCE FOR DECK ERECTIONS :-

Freeboard, Table C.....	<u>0 - 6 1/4</u>
Correction for Length, if required (Para. 12, 13, and 14) .....	
Freeboard by Table A, corrected for sheer, and for length, if required (Para. 12, 13, and 14) }	<u>1 - 9 3/4</u>
Difference .....	<u>1 - 3 1/2</u>
Percentage as below.....	<u>77.6%</u>
	<u>12.03</u>

Winter Freeboard .....	<u>6 - 4 1/4</u>
Summer Freeboard .....	<u>6 - 2 1/4</u>
Indian Summer Freeboard .....	<u>6 - 0 1/4</u>
N. A. Winter Freeboard .....	✓
Correction necessary because clearside amidships, measured in accordance with the Statute is not taken at the intersection of the wood or iron deck with side.	<u>+ 1 1/2</u>
Winter Freeboard from deck line .....	<u>6 - 5 1/2</u>
Summer " " " " .....	<u>6 - 3 1/2</u>
Indian Summer " " " " .....	<u>6 - 1 1/2</u>
N. A. Winter " " " " .....	✓

Correction for R. Q. Dk. if engine and boiler openings not covered by bridge house (Para. 11)	<u>- 12</u>	
Allowance for Deck Erections .....		
Length.	Length allowed.	Height.
Forecastle.....	<u>123.5</u>	<u>98.85</u>
Bridge House .....	<u>4</u>	
† Raised Q. Dk.....	<u>72</u>	<u>36</u>
Poop.....	<u>199.5</u>	<u>134.85</u>
Total .....	<u>199.5</u>	<u>32.32</u>
Length of Ship .....	<u>167.17</u>	<u>= .838</u>
Corresponding percentage (Para. 11, 12, 13, or 14) }	<u>77.6%</u>	<u>199.5</u>


FREEBOARD recommended amidships from centre of Disc to top of Statutory Deck Line, Wood (Iron) Deck :-

Fresh Water Line above centre of Disc	
Indian Summer Line " " "	
Winter Line below " "	
Winter North Atlantic Line " " "	

3 - 4 - 17

State dimensions of freeing port area on back of this form.  
† The Surveyor should state whether the fall in sheer as reported is measured relatively to the straight line of keel or to the water line. If measured relatively to water line the vessel's draft at time of survey, and also the usual load draft forward and aft should be reported.

Q If the frames, skin planking, or ceiling are of unusual thickness the breadth of vessel to inside of ceiling should be reported if possible.  
† In vessels obtaining an allowance for deck erections under Para. 11 where the sheer drops abaft amidships the height of the R.Q.D. is to be taken from the level of the top of the amidship beam.  
§ In flush-decked vessels the total standard mean sheer means the sheer measured at the stem and sternpost. In vessels having poops and forecastles, it means the sheer measured at points distant one eighth of the vessel's length from stem and sternpost.

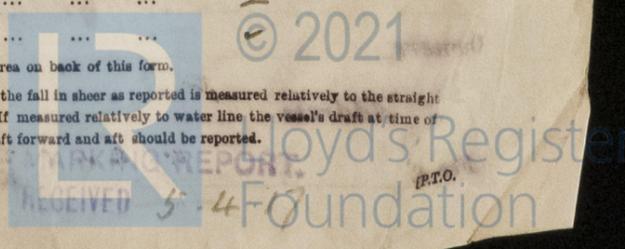

Shelter Deck

Do all the Frames extend to the top height in the Poop? *Yes* Raised Quarter Deck?  Bridge House  Forecastle?

To what height do the Reverse Frames extend? *None*

Has the Poop or Raised Quarter Deck an efficient Iron Bulkhead at the fore end?

Give particulars of the means for closing the openings in Bulkhead

Is the Poop or Raised Quarter Deck connected with the Bridge House?  Has the Bridge House an efficient Bulkhead at the fore end?

Give particulars of the means for closing the openings in Bulkhead

What is the thickness of the Bridge Front plating?  and Coaming plate?

Give scantlings and spacing of the Stiffeners

Are bracket plates fitted at each end of the Stiffeners?  Are hor'l. brackets fitted connecting Bridge Bulk'd. with Bulwarks?

Has the Bridge House an efficient Iron Bulkhead at the after end?

How are the openings closed?

Is the Forecastle at least as high as the main or top-gallant rail?  Has the Forecastle an efficient Iron or Wood Bulk'd. at after end?

Are the Engine and Boiler openings covered by a Bridge, Poop, Raised Quarter Deck, or enclosed by a Strong Iron or Steel Deckhouse? *Shelter Deck & steel Deck House*

If the openings are not so protected are the exposed parts of the Casings efficiently constructed? *Yes.*

Give thickness of plating; scantlings and spacing of Stiffeners

What is the height of the exposed Casings? *7.0* Are suitable means provided for closing all openings in them in bad weather? *Yes.*

Are the Weather Deck Hatchways efficiently constructed and at least equal to the requirements of Section 28 of the Rules for 1904-5? Give particulars below:— *Yes. Rule Damage Opening*

Position and Size.	No. 1 = 33.0 x 15.0		No. 2 = 31.2 x 15.0		No. 3 = 4.0 x 15.0					
	Ship.	Rule.	Ship.	Rule.	Ship.	Rule.	Ship.	Rule.	Ship.	Rule.
COAMING.	Height above top of DECK	2.6	2.6	2.6						
	Thickness	Sides.....	.54	.52	.44					
		Ends.....	.40	.40	.44					
SHIFTING BEAMS OR WEB PLATES.	Number .....	5	Same	None						
	Section and Scantlings .....	11" x .34	as							
	Material .....	Steel	No. 1							
* FORE AND AFTERS.	Number .....									
	Section and Scantlings .....									
	Material .....									
HATCHES Thickness .....	3"	3"	3"							
Remarks.....										

Please give particulars of assignment of freeboards, vessel checked, sailing Wednesday or Thursday

\* When the Fore and Afters are of wood the depth should be stated from the underside of the hatches.  
 (If the sill of the lowest side scuttle will be less than 6 inches above the Indian Summer Load Line if assigned under the tables, state vertical distance from top of deck at side amidships to lower edge of lowest side scuttle.)

The following information is to be given in all Cases of vessels dealt with under Paras. 11, 12 (under 15 feet Moulded depth) and under Shelter Deck Rules.

What is the thickness of the Bridge Sheerstrake?  Strake between Main and Bridge Sheerstrakes?


Delete the words { The Crew are, are not, berthed in the bridge house. }  
 that do not apply { The arrangements to enable them to get backwards and forwards from their quarters are, are not satisfactory. }

Length of Bulwarks in well

Area of Freeing Ports required by Para. 11 (e) each side of vessel = \_\_\_\_\_ Sq. ft.

Ft. Tenths.    Ft. Tenths.    No.    }    Freeing Ports (each side of vessel) = \_\_\_\_\_ Sq. ft.

                  x                   x                   }    Total deficiency or excess = \_\_\_\_\_ Sq. ft.

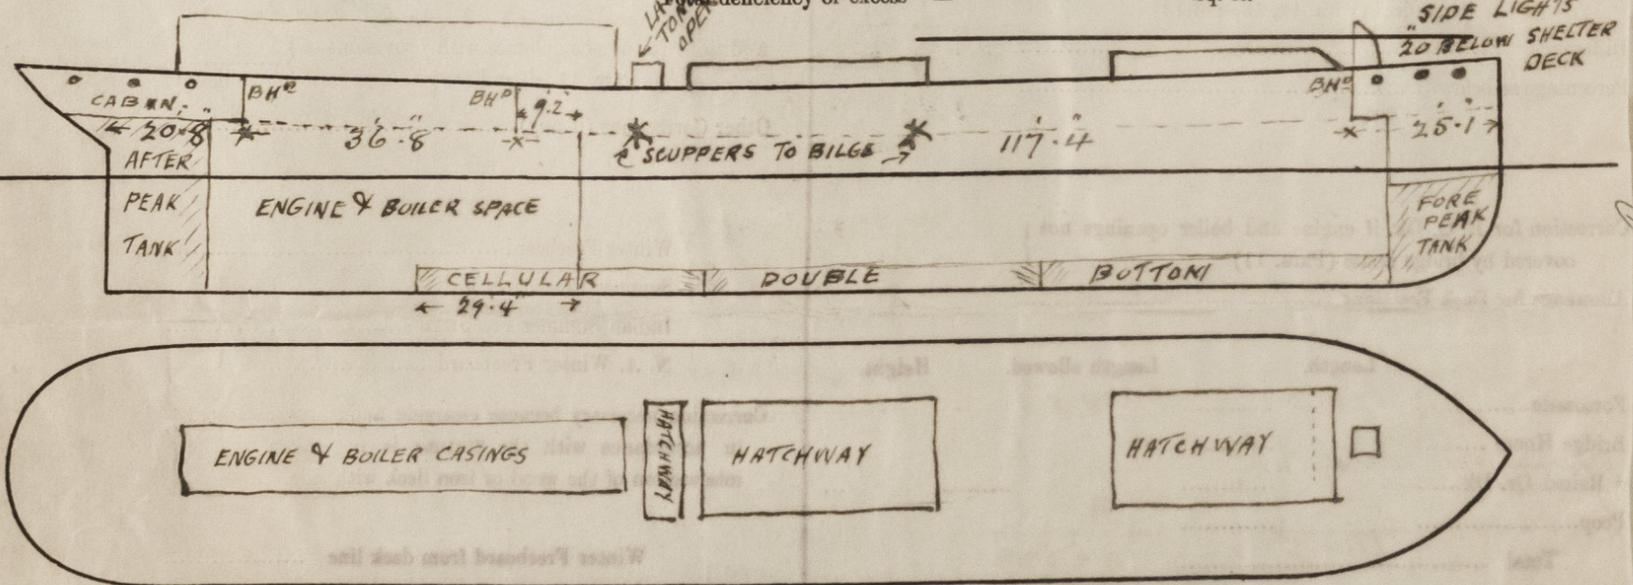

Show hereon line of Floors or Tank Top with position of any Breaks in same; also height of Peak Tank tops, &c., &c.

State any special features in the construction of the Vessel *Freeing ports, now permanently riveted up*  
*Scupper holes in shell plating & shelter tween decks, now closed with riveted plate*  
*two scuppers, each side fitted from tween decks to bilges. The tonnage opening is*  
*converted into a permanent hatchway with arrangements as for weather*  
*deck hatchway. Plans of mainmast section, profile & deck & scuttles, & hullow, &*  
*together with freeboard request forms are enclosed.*

Owners \_\_\_\_\_  
 Address \_\_\_\_\_  
 Fee £ \_\_\_\_\_ Received by me \_\_\_\_\_

